


- MAP REFERENCE:**
- "Final Plan Amended Carriage Hill Subdivision Map of Lands of Charlew Construction Corp." Town of Bethlehem Albany County, NY prepared by Edward W. Bouletle and Son dated November 14, 1995 last revised March 2006 and filed in the Albany County Clerk's Office on November 1, 2006 in Drawer 172 as Map No. 11898.

MAP NOTES:


- Subject to a Declaration of Restrictive Covenants as described in Book 2879 of Deeds at Page 263.
- May be subject to an unplottable easement granted to New York Power & Light Corporation as described in Book 823 of Deeds at Page 277.
- Subject to an unplottable drainage easement granted to the Town of Bethlehem as described in Book 48 of Miscellaneous at Page 832.
- Subject to a Drainage Easement granted to the Town of Bethlehem as described in Book 2864 of Deeds at Page 1058.
- Subject to a Declaration of Covenants and Restrictions as described in Book 2854 of Deeds at Page 599, as amended by First Amendment to Declaration of Covenants and Restrictions as described in Book 2980 of Deeds at Page 945.
- Subject to a Declaration of Restrictive Covenants as described in Book 2960 of Deeds at Page 751.
- May be subject to an unplottable easement granted to New York Power & Light Corporation as described in Book 850 of Deeds at Page 336.

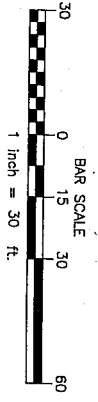

"ONLY COPIES OF THIS MAP SIGNED IN RED INK AND EMBOSSED WITH THE SEAL OF AN OFFICER OF C.T. MALE ASSOCIATES, P.C. OR A DESIGNATED REPRESENTATIVE SHALL BE CONSIDERED TO BE A VALID TRUE COPY."

WILLIAM J. NEITLTON
 PLS 49513

DATE	REVISIONS RECORD/DESCRIPTION	DRAFTED/CHECK	APPR.
12/22/15	PROPOSED BUILDING LOCATION	MDD	WIN
1/21/16	FOUNDATION LOCATION	MDD	WIN
4/22/16	FINAL SURVEY	MDD	WIN

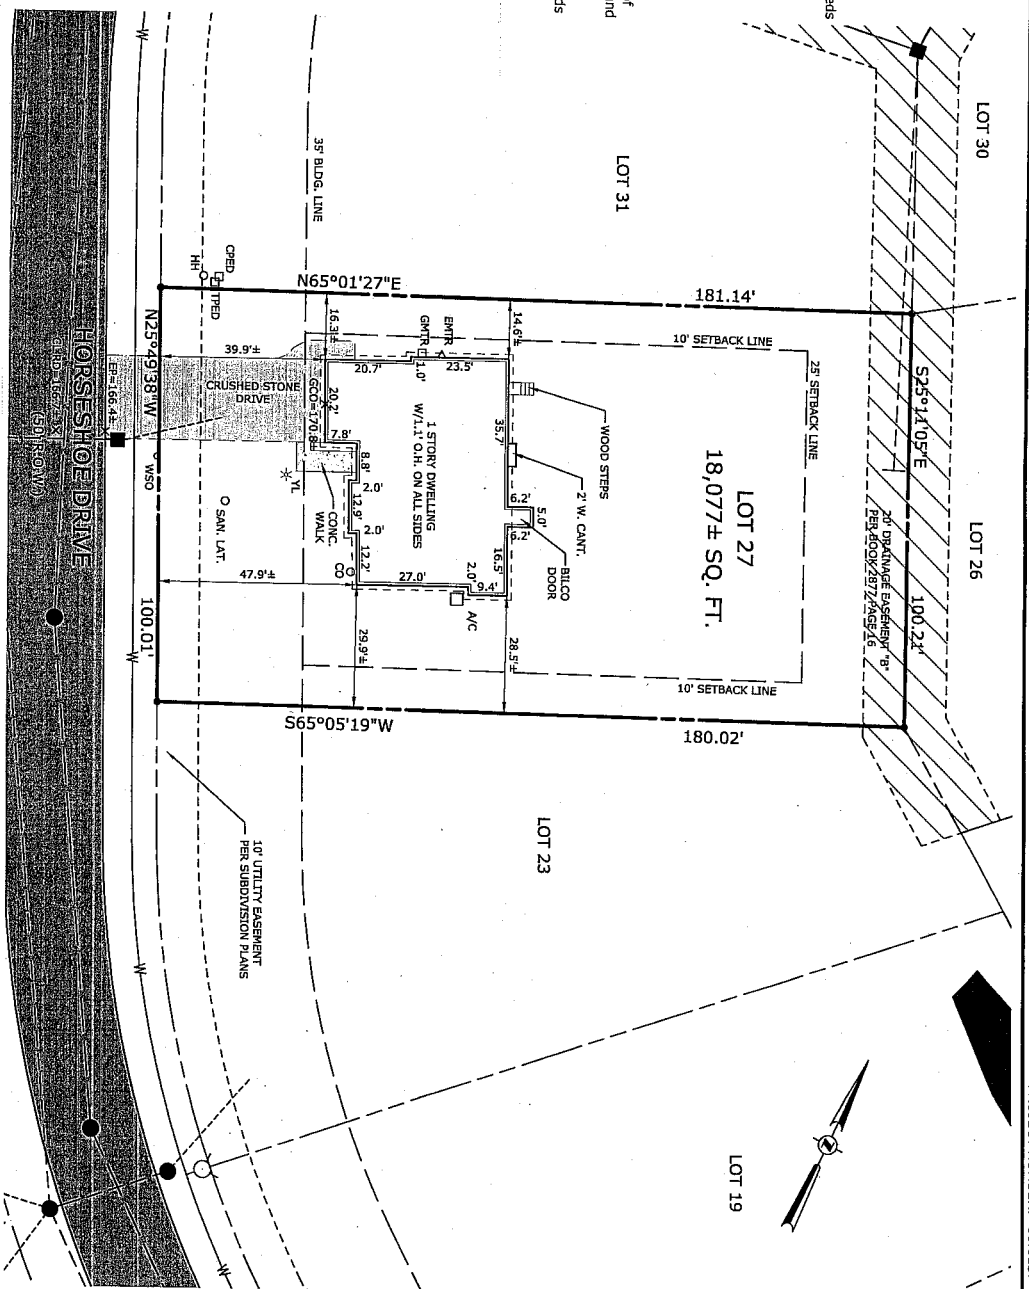

UNAUTHORIZED ALTERATION OR ADDITION TO THIS DOCUMENT IS A VIOLATION OF SECTION 209 SUBDIVISION 2 OF THE NEW YORK STATE EDUCATION LAW.

© 2010
 C.T. MALE ASSOCIATES, P.C.

APPROVED: _____

DRAFTED: MDD

CHECKED: _____

PROJ. NO.: 06.6137

SCALE: 1"=30'

DATE: APR. 6, 2010

TOWN OF BETHLEHEM

LOT 27 HORSESHOE DRIVE

CARRIAGE HILL SUBDIVISION

C.T. MALE ASSOCIATES, P.C.
 50 CENTURY HILL DRIVE, P.O. BOX 777, LATHAM, NY 12110
 518.786.7400 * FAX 518.786.7299
 ARCHITECTURE & BUILDING SYSTEMS ENGINEERING * CIVIL ENGINEERING
 ENVIRONMENTAL SERVICES * SURVEY & LAND INFORMATION SERVICES

ALBANY COUNTY, NEW YORK

SHEET 1 OF 1
 DWG. NO.: 06-254