



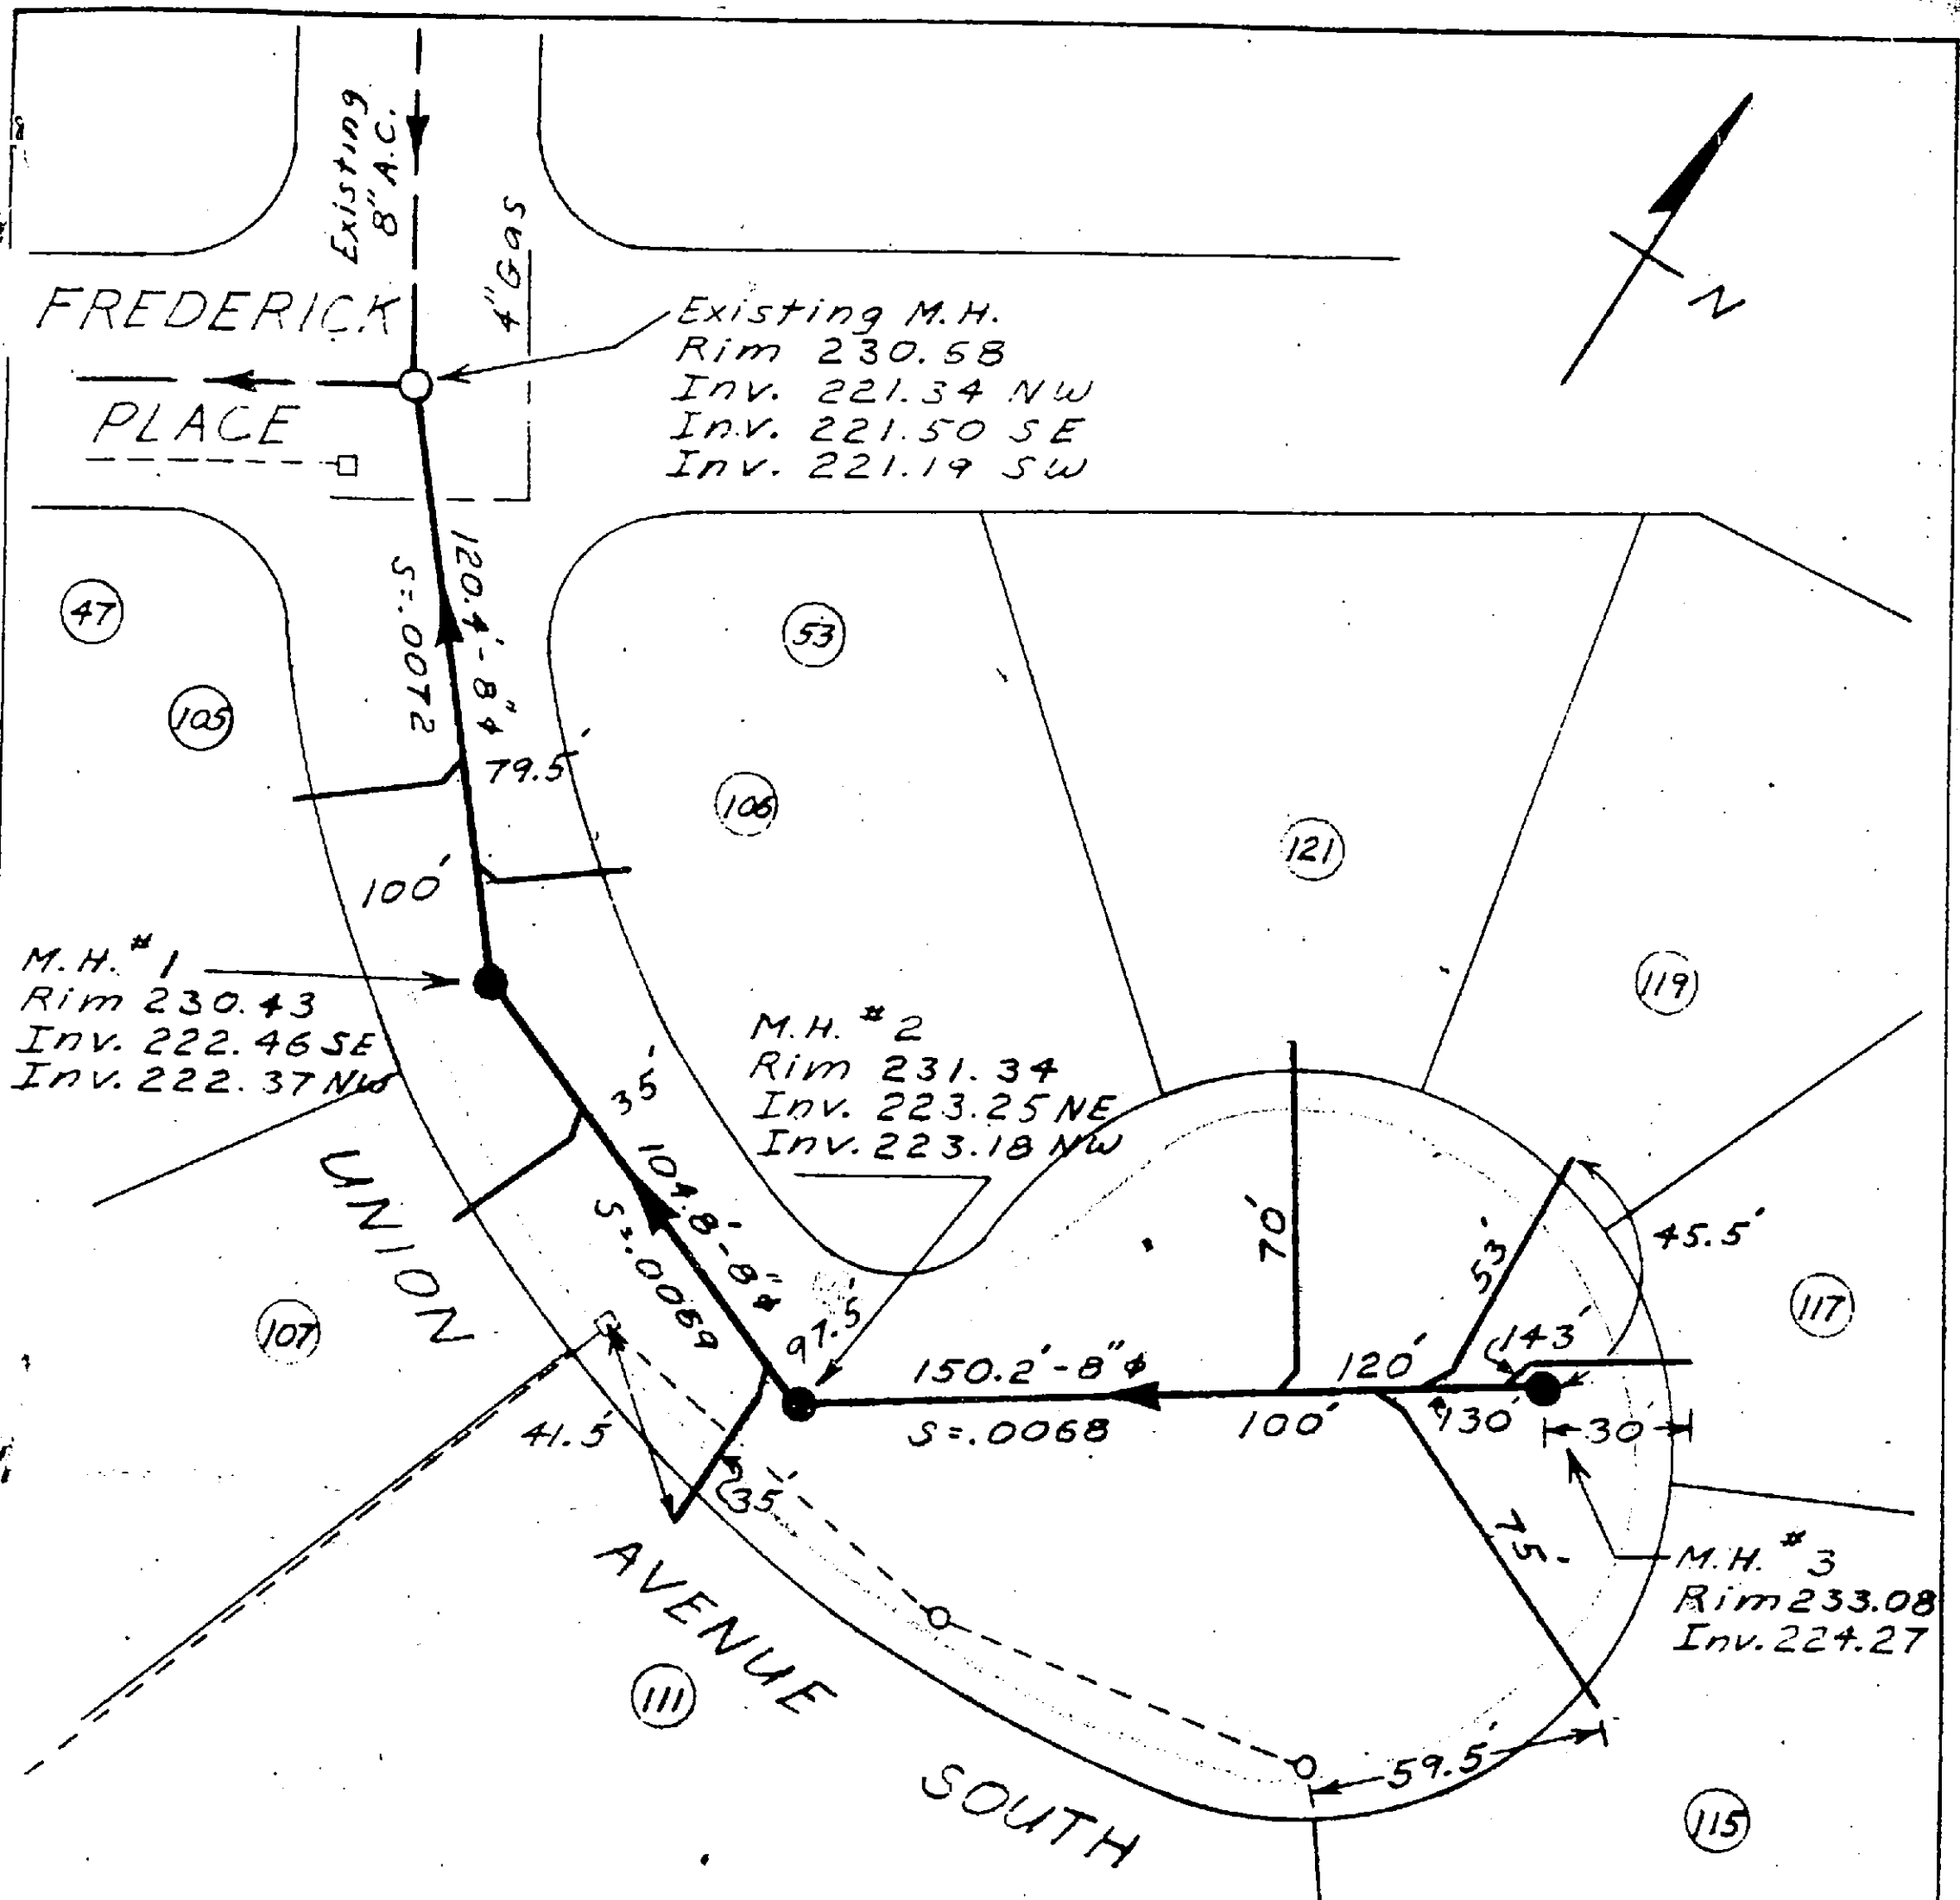

Constructed - May 1977
 Contractor - Armada Assocs.
 Soil - Brown on Blue Clay
 Ground Water - 1'±
 Main Line - 8" Truss ABS
 Laterals - 6" ABS

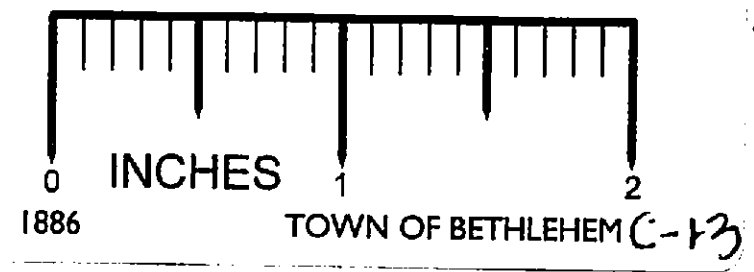

BETHLEHEM SEWER DISTRICT
 RECORD PLAN
 UNION AVENUE SOUTH
 CONTRACT NO. 54

Scale 1" = 50' May 1977
 J. Kenneth Fraser & Assocs., P.C.
 Consulting Engrs. Renss., N.Y.

DRN. by JJB
 CHK. by WTB