



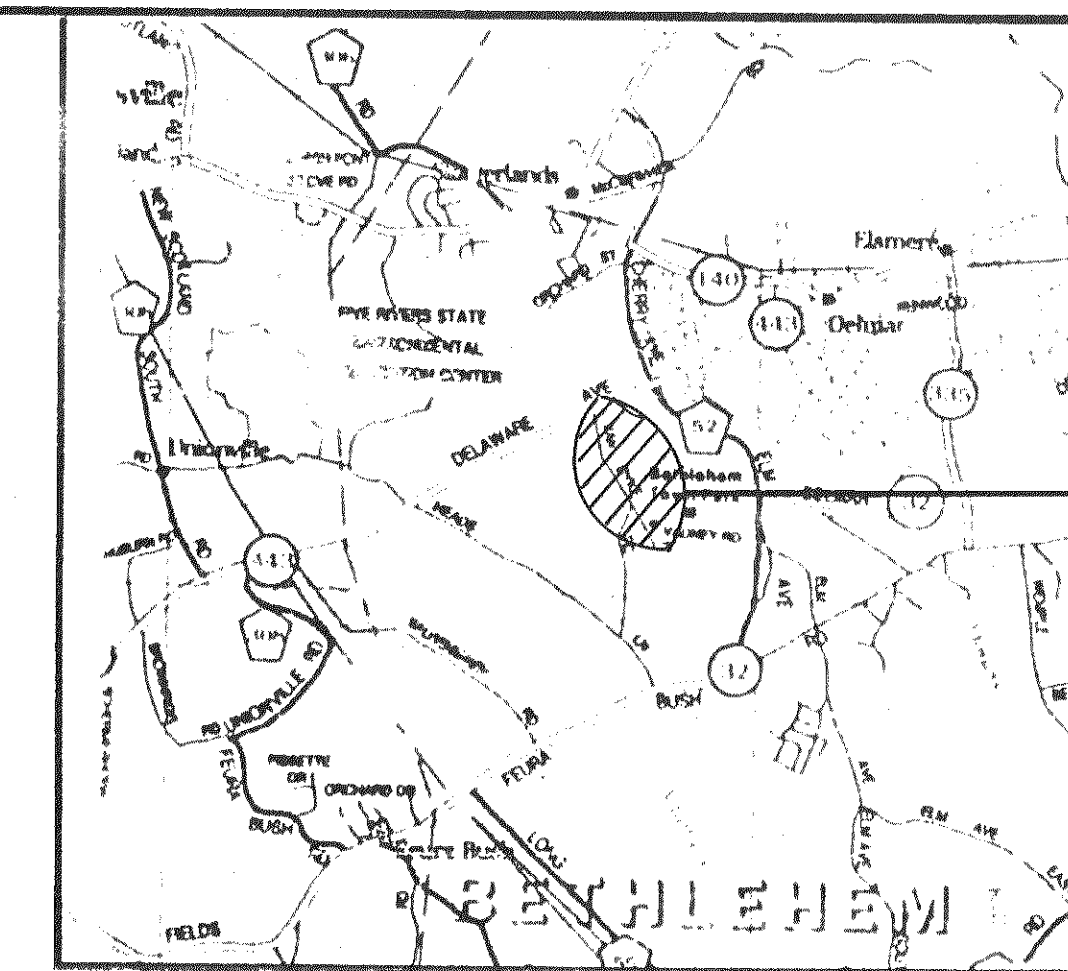


SITE
LOCATION

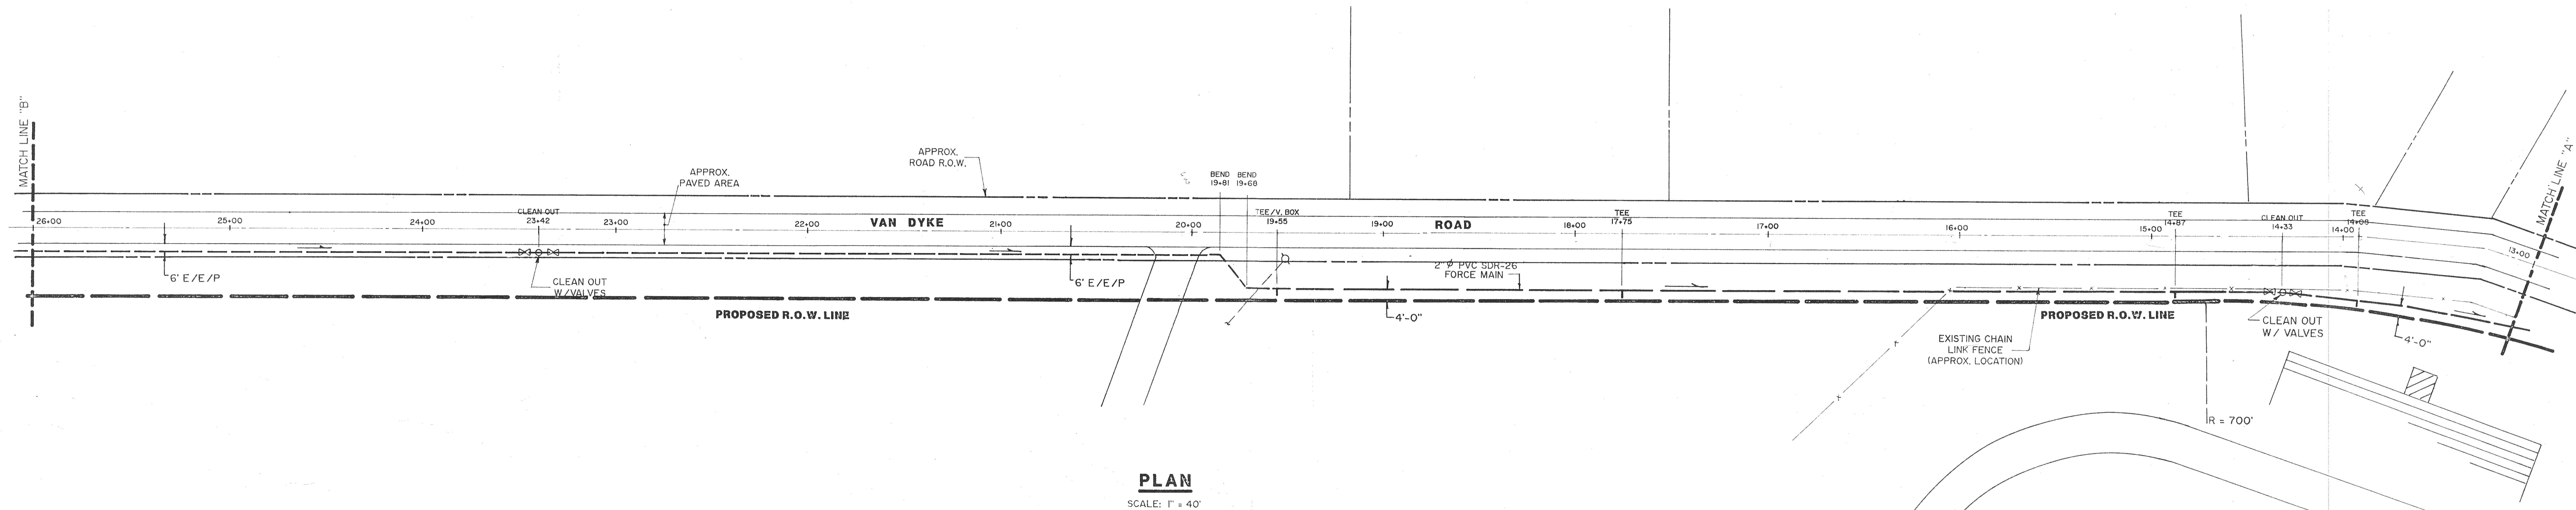

PLAN
SCALE: 1" = 40'


LEGEND

- R.O.W. LINE
- G — GAS LINE
- S — SEWER LINE
- - - - - ELECTRIC/TELEPHONE LINE
- - - - - FORCE MAIN
- x - FENCE

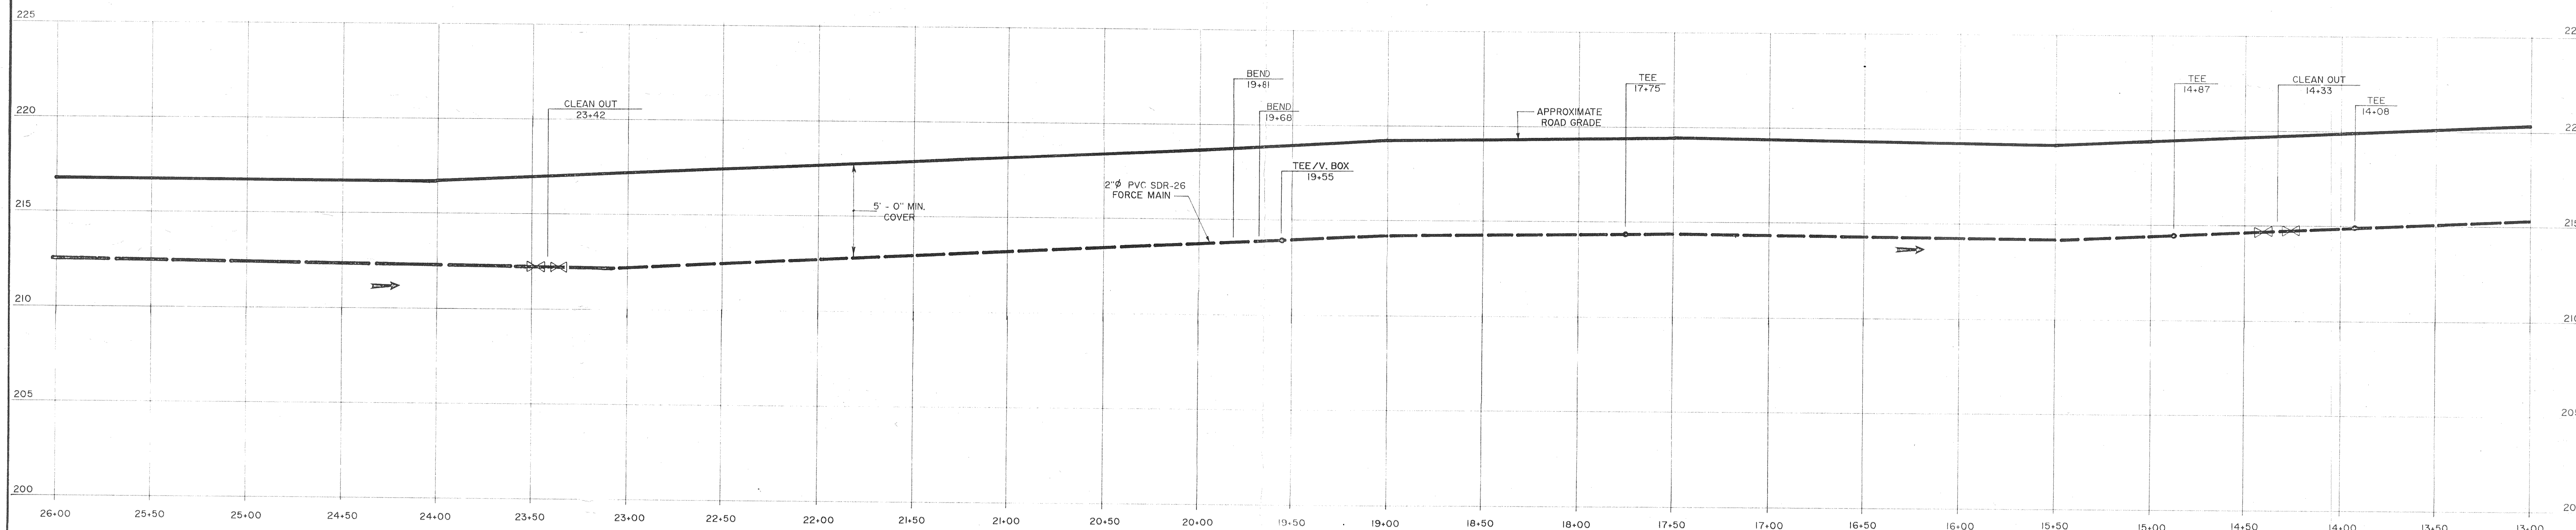

FORCE MAIN PROFILE

SCALE: HORIZ. 1" = 40'
VERT. 1" = 4'

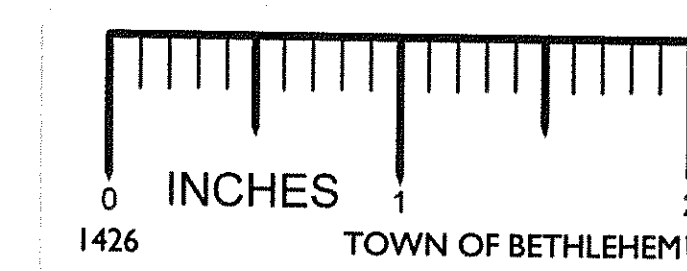

RECORD DRAWING 12/22/89

REVISIONS 1. PROPOSED R.O.W. 2. 12/22/89 VARIOUS REVISIONS PER AS BUILT CONDITIONS		M.J. ENGINEERING, P.C. CONSULTING ENGINEERS ONE MARINOL DRIVE CLIFTON PARK, N.Y.		WILDWOOD PROGRAMS DELMAR RESIDENCE 232 GAY ST. DELMAR, N.Y. OWNER: NEW YORK ASSOCIATION FOR THE LEARNING DISABLED INC., CAPITAL DISTRICT CHAPTER	2 OF 3 H-17
		GRINDER P.S. & FORCE MAIN SEWER CONNECTION SCALE: AS SHOWN DATE: MAY 12, 1989			