



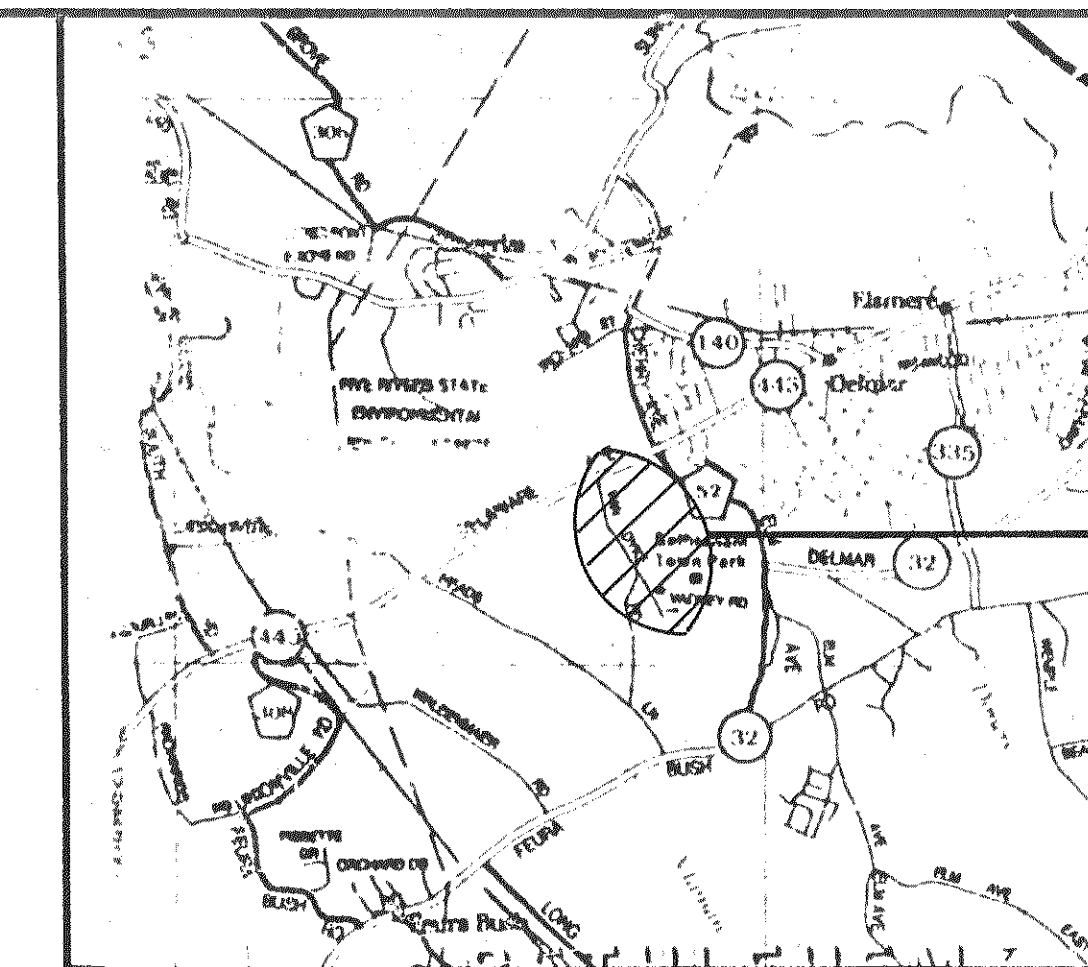


SITE
LOCATION

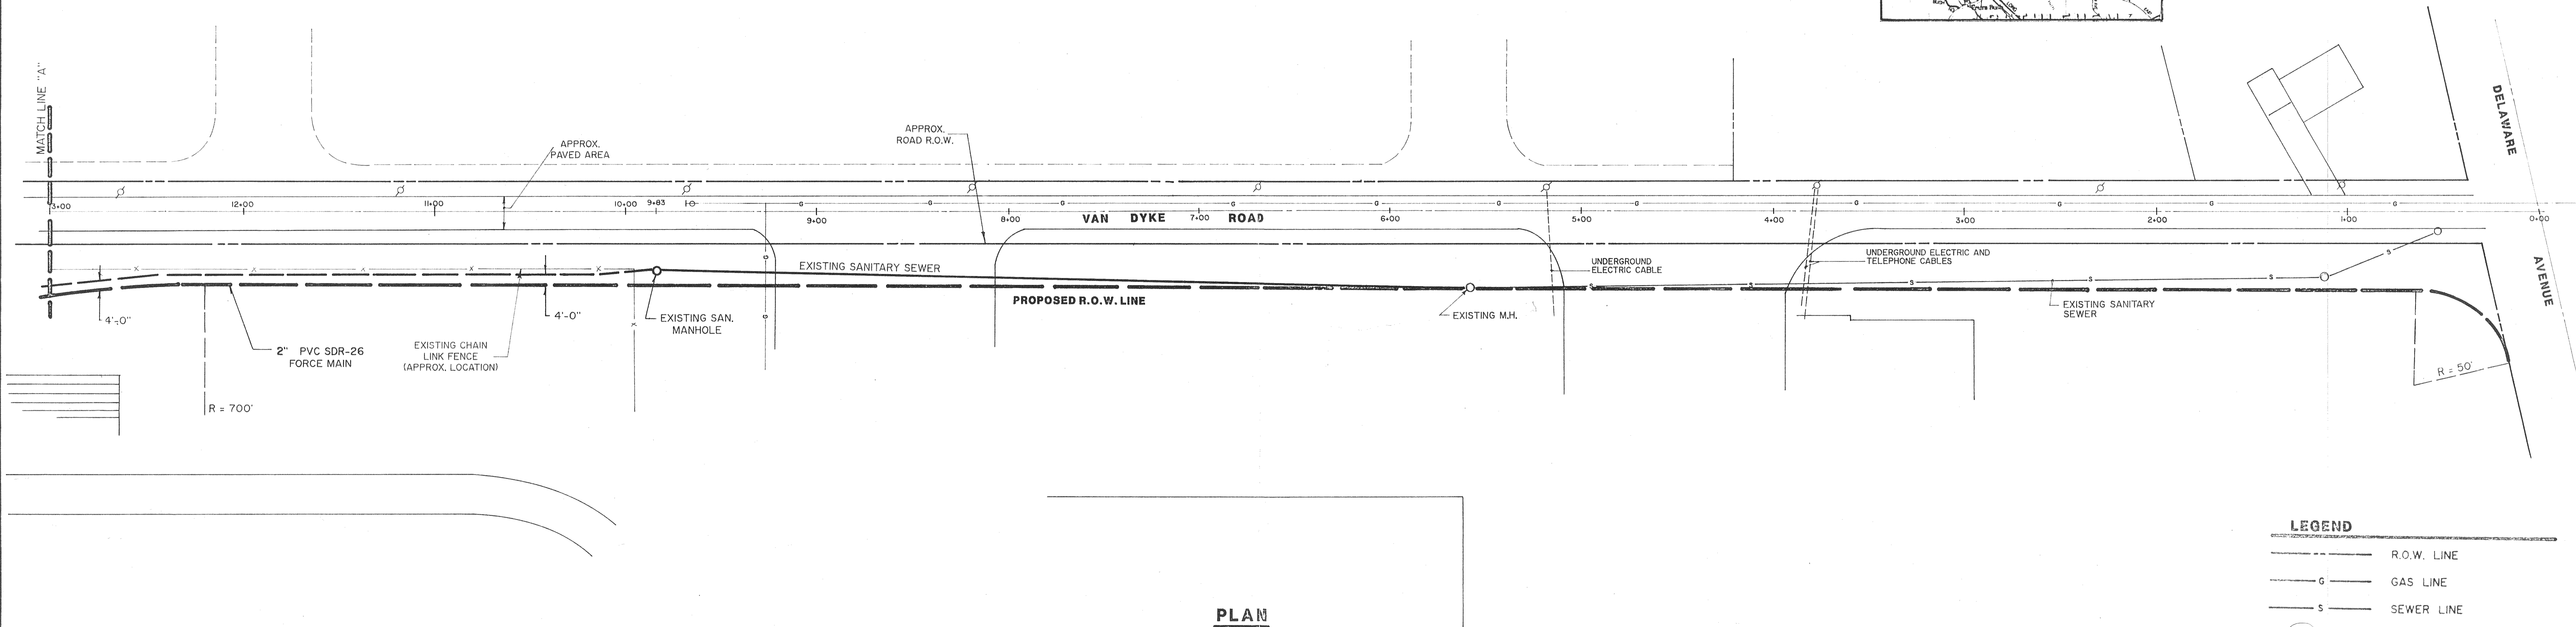


PLAN
SCALE: 1" = 40'

LEGEND


- R.O.W. LINE
- GAS LINE
- SEWER LINE
- ELECTRIC/TELEPHONE LINE
- FORCE MAIN
- FENCE

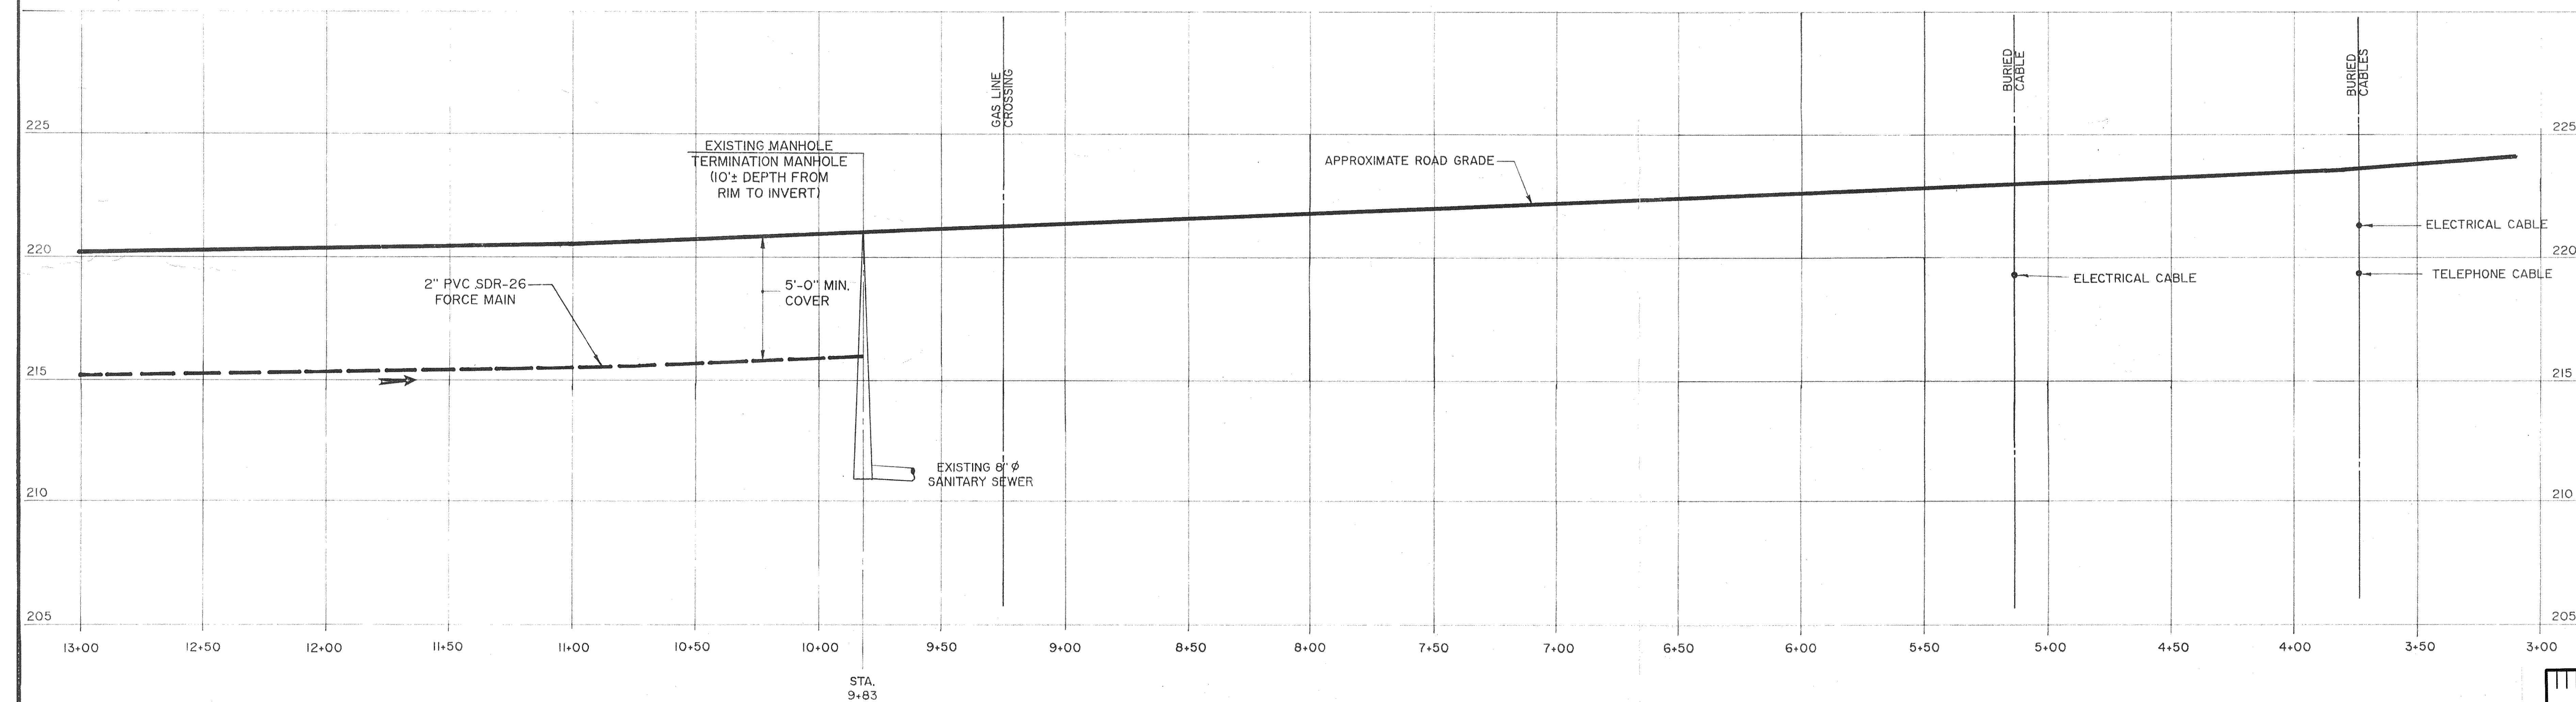

FORCE MAIN PROFILE
SCALE: HORIZ. 1" = 40'
VERT. 1" = 4'

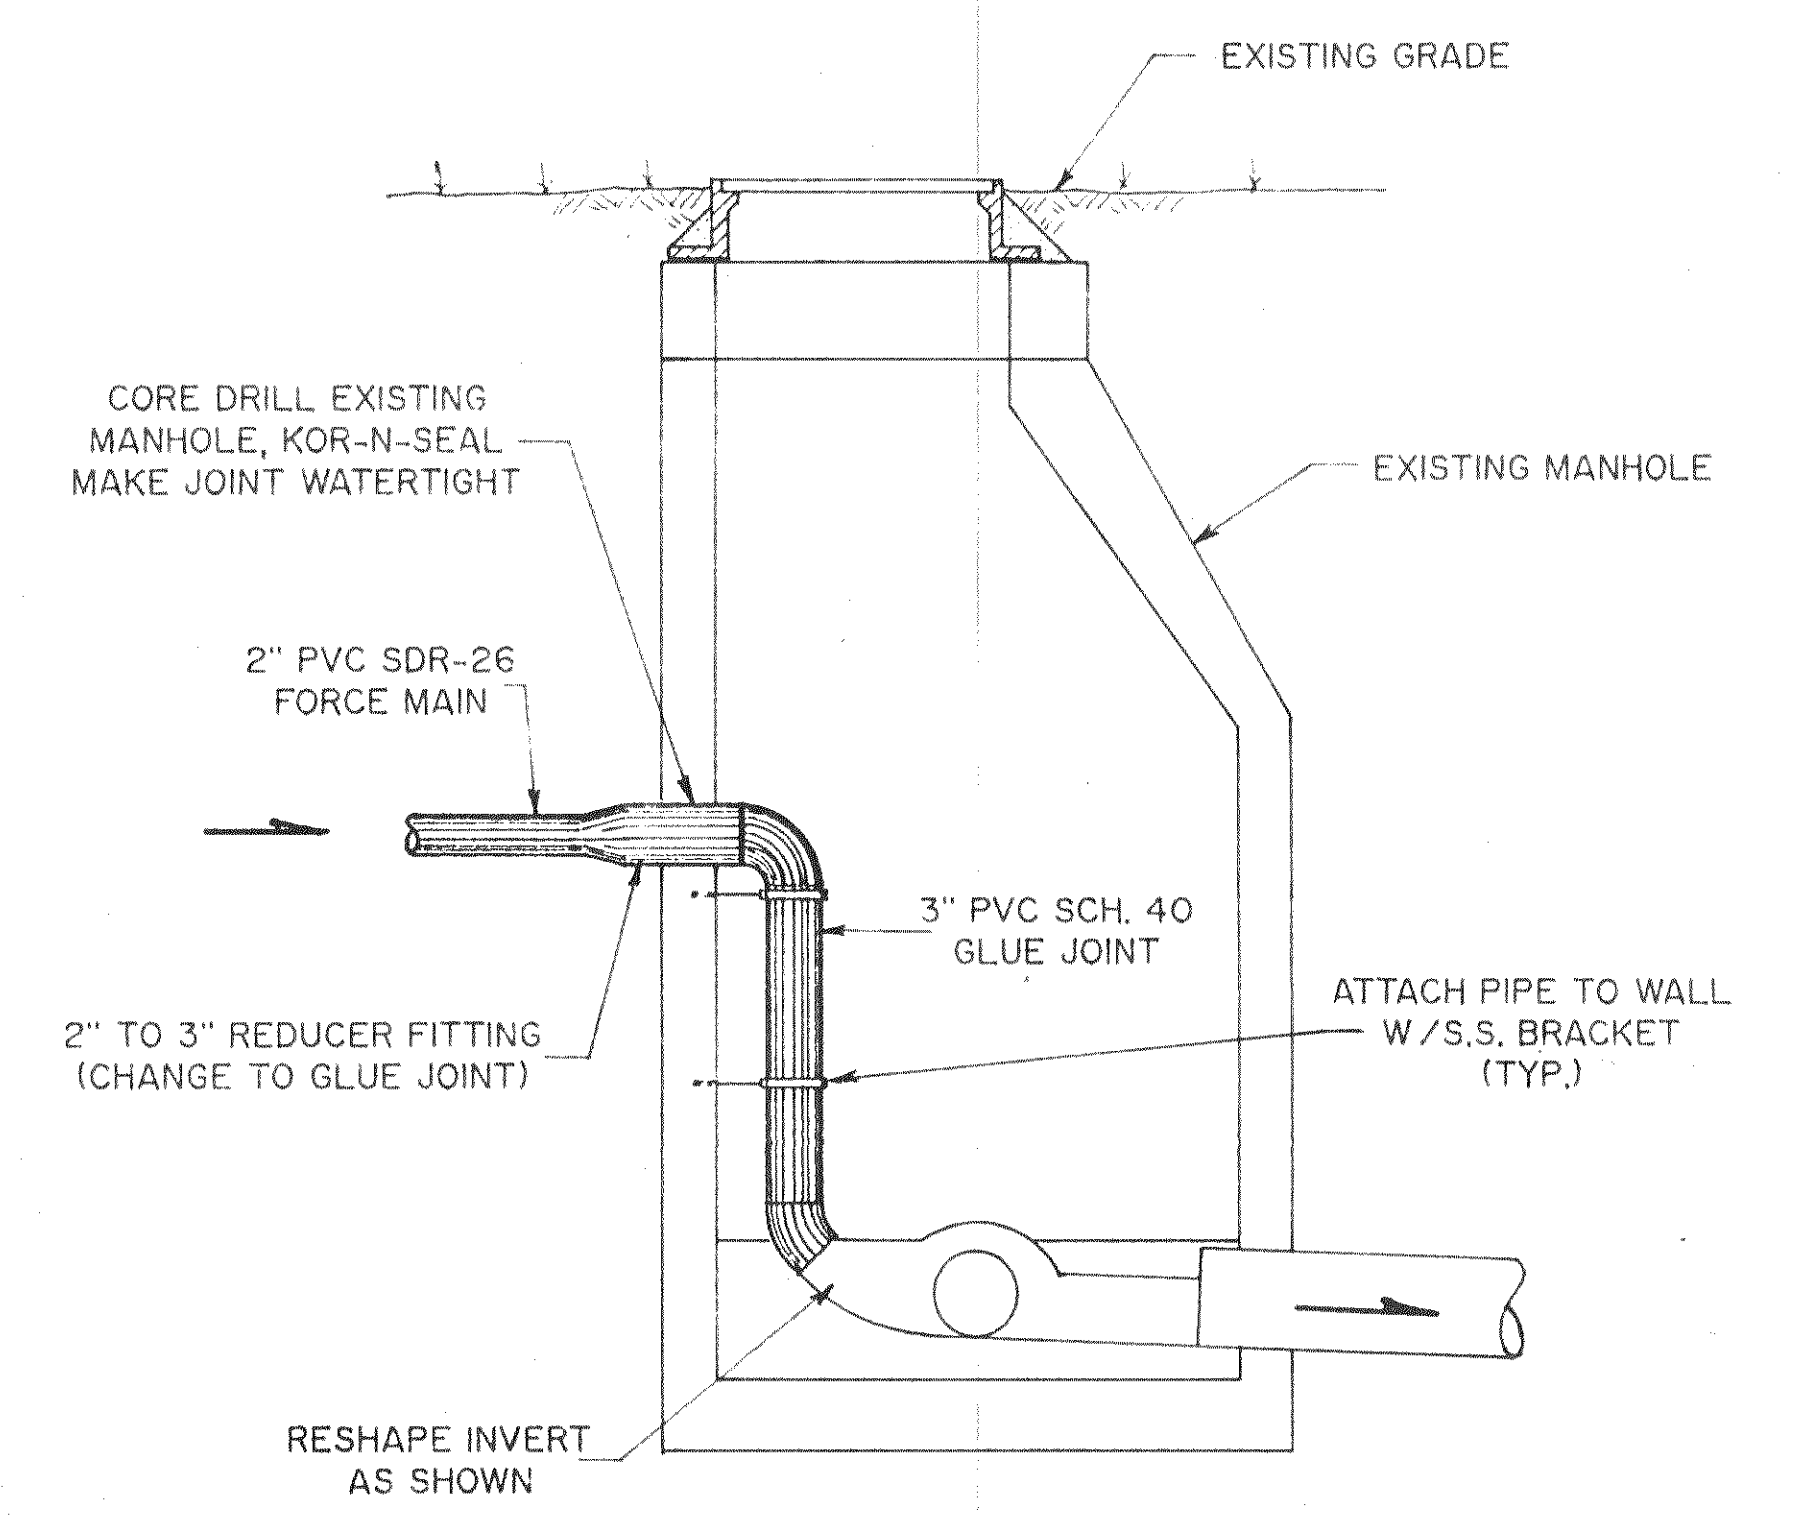

MANHOLE TERMINATION
N.T.S.

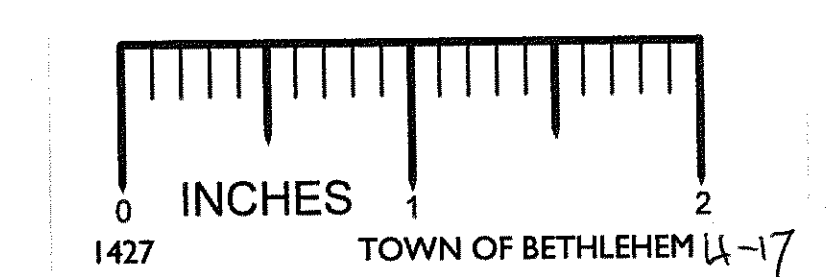

RECORD DRAWING 12/22/89

REVISIONS 1. PROPOSED R.O.W. 2. 12/22/89 VARIOUS REVISIONS PER AS BUILT CONDITIONS		M.J. ENGINEERING, P.C. CONSULTING ENGINEERS ONE MARINOL DRIVE CLIFTON PARK, N.Y.	WILDWOOD PROGRAMS DELMAR RESIDENCE 232 GAY ST. DELMAR, N.Y. OWNER: NEW YORK ASSOCIATION FOR THE LEPANINS DISABLED INC., CAPITAL DISTRICT CHAPTER	
			GRINDER P.S. & FORCE MAIN SEWER CONNECTION	
SCALE: AS SHOWN			DATE: MAY 12, 1989	

3
OF 3