



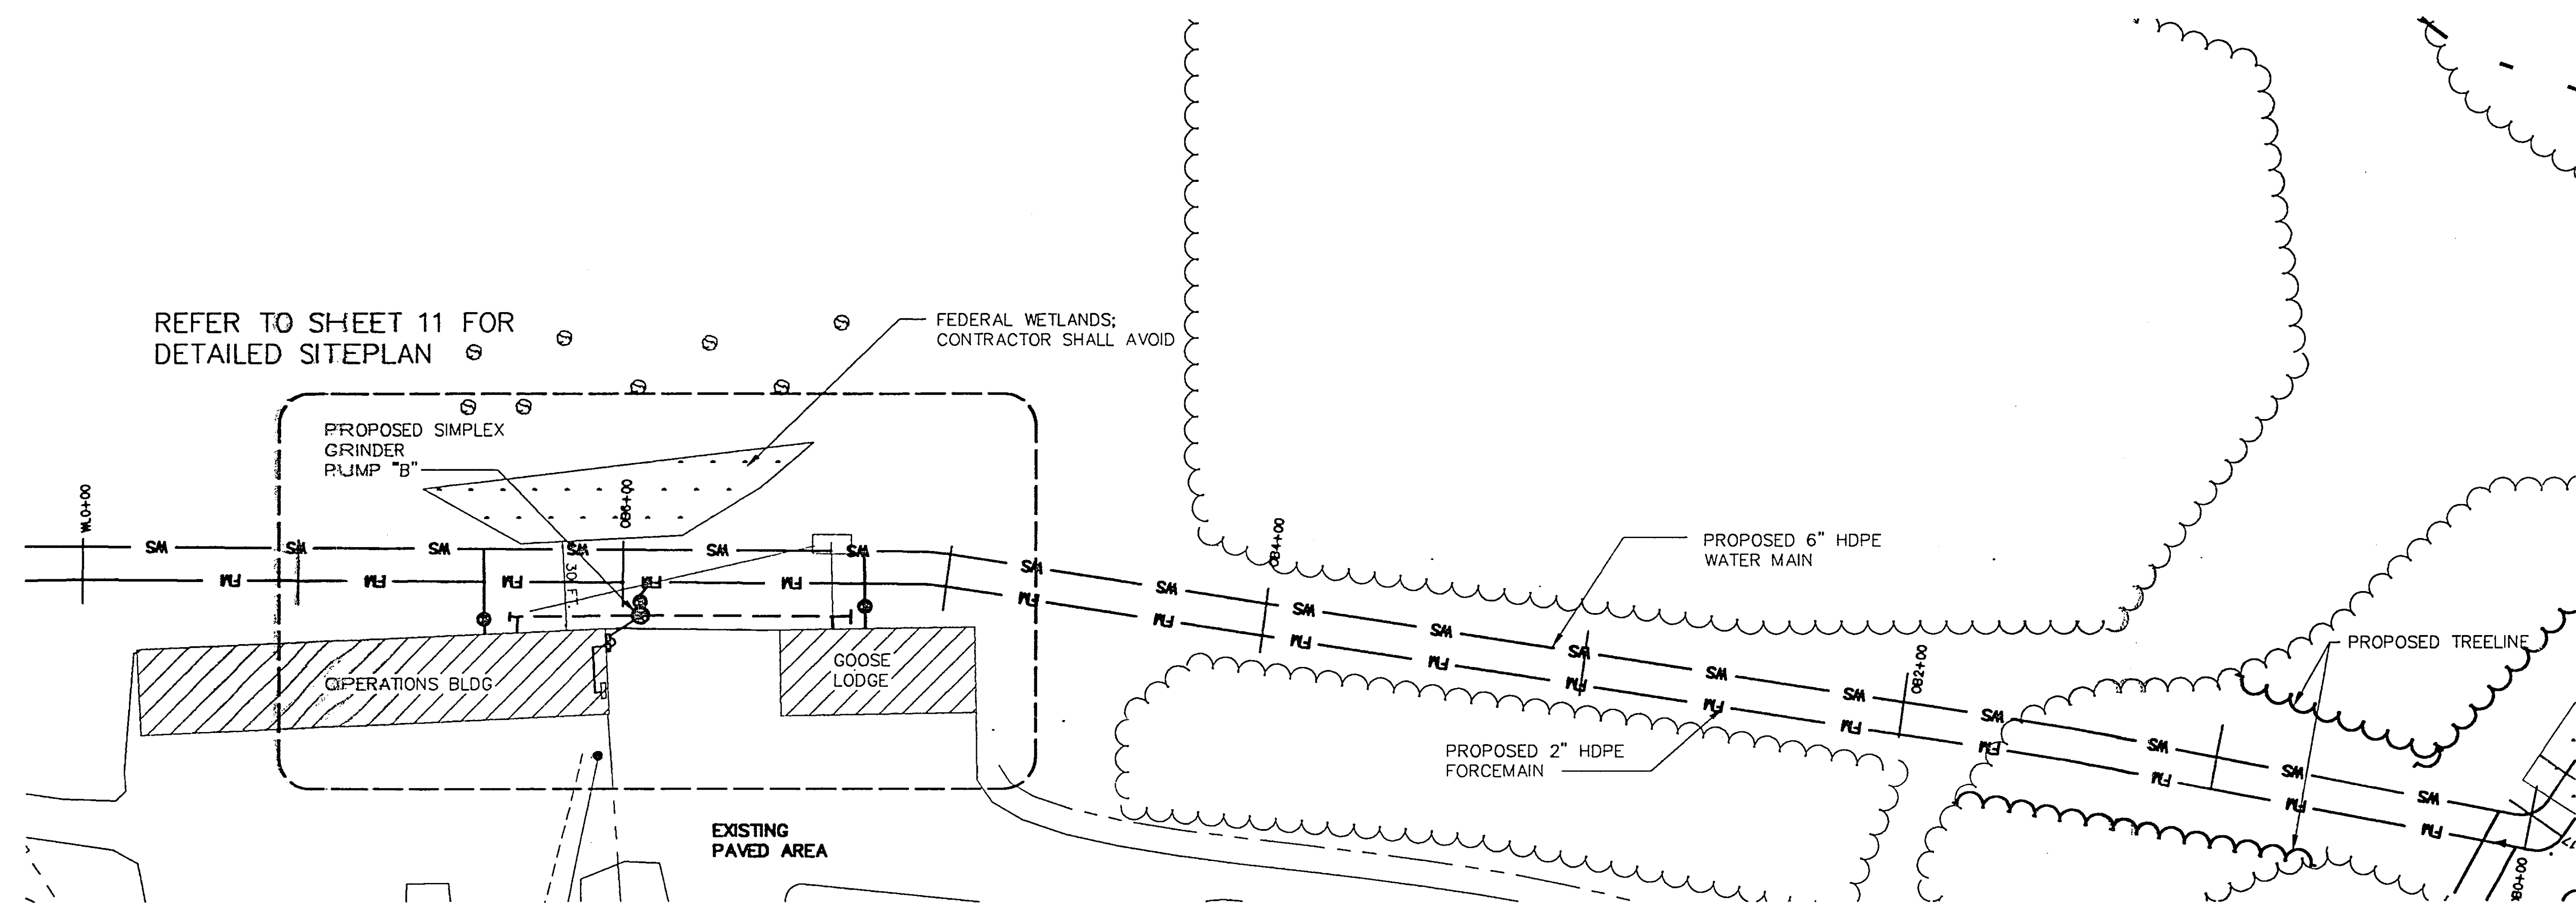

FIVE RIVERS PLAN

SCALE: - 1"=40'

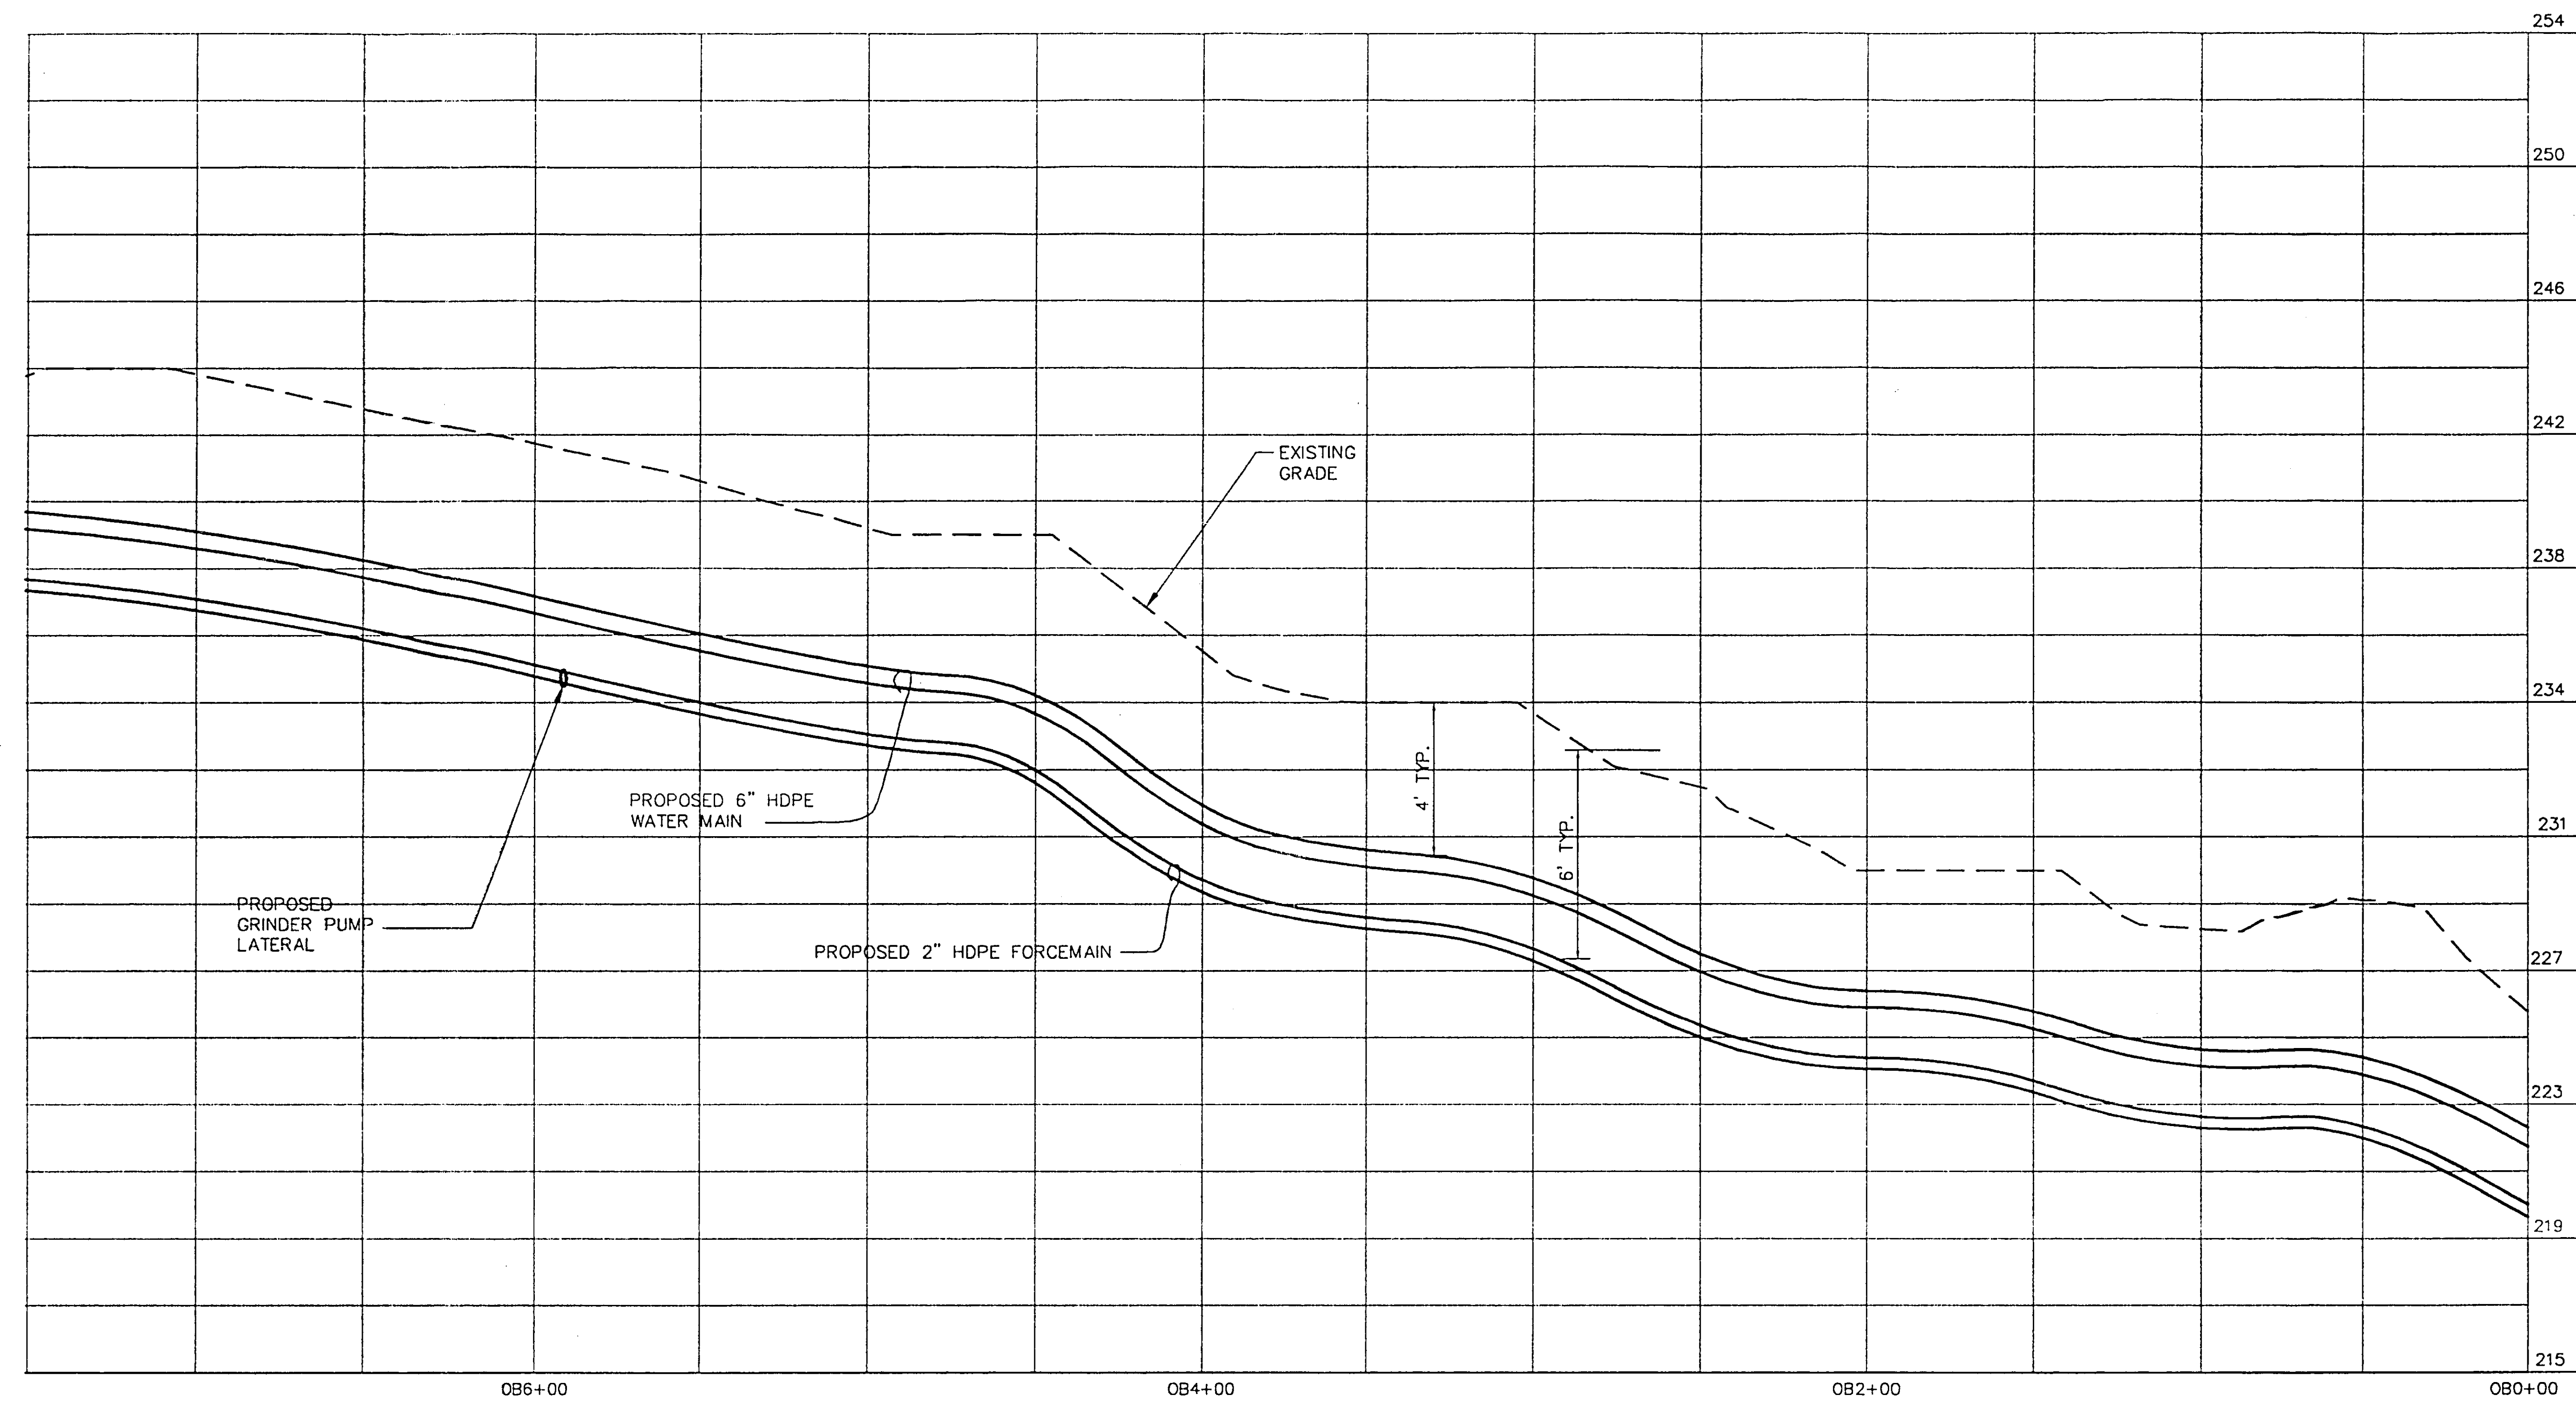

PROFILE III

SCALE: HORIZ. - 1"=40'
VERT. - 1"=4'



NO. DATE		NOTES:	
STATE OF NEW YORK DEPARTMENT OF ENVIRONMENTAL CONSERVATION DIVISION OF OPERATIONS BUREAU OF DESIGN & CONSTRUCTION			
DESIGNED BY	CHECKED BY	DRAWN BY	BY DE
BY 22	BY 11	BY 11	BY DE
REVISIONS			AS BUILT
NO. DATE	DESCRIPTION	BY	
PROJECT DESCRIPTION FIVE RIVERS ENVIRONMENTAL EDUCATION CENTER MUNICIPAL SEWAGE AND WATER CONNECTION FIVE RIVERS PLAN & PROFILE III			
FACILITY NAME			
FIVE RIVERS ENV. EDUCATION CENTER			
FACILITY NO. 2515			
PROJECT NO. 97-2789			
DATE AUGUST, 2001			
SCALE AS NOTED			
DRAWING NO. 7			