

DRAFT

TOWN OF BETHLEHEM
ALBANY COUNTY, NEW YORK

TRANSMISSION MAIN - NORTH BETHLEHEM SLINGERLANDS BYPASS TO EASTMOUNT DRIVE

SUPERVISOR

SHEILA FULLER

TOWN BOARD

DANIEL PLUMMER
GEORGE LENHARDT

SUSAN BURNS
DORIS M. DAVIS

TOWN CLERK

KATHLEEN A. NEWKIRK

COMMISSIONER OF PUBLIC WORKS


BRUCE H. SECOR, PE

DIRECTOR OF WATER DEPT OPERATIONS

CHARLES WICKHAM

DRAWING INDEX

SHEET	SHEET NO.
T1	TITLE SHEET
PP1	PLAN\PROFILE
PP2	PLAN\PROFILE
PP3	PLAN\PROFILE
BD1	SLINGERLANDS BYPASS BORING PLAN AND DETAILS (ALTERNATE BID)
SW1	STANDARD WATER DISTRIBUTION DETAILS
SW2	STANDARD WATER DISTRIBUTION DETAILS
SW3	STANDARD WATER DISTRIBUTION DETAILS
MT1	MAINTENANCE OF TRAFFIC SIGN DETAILS
D1	DETAILS

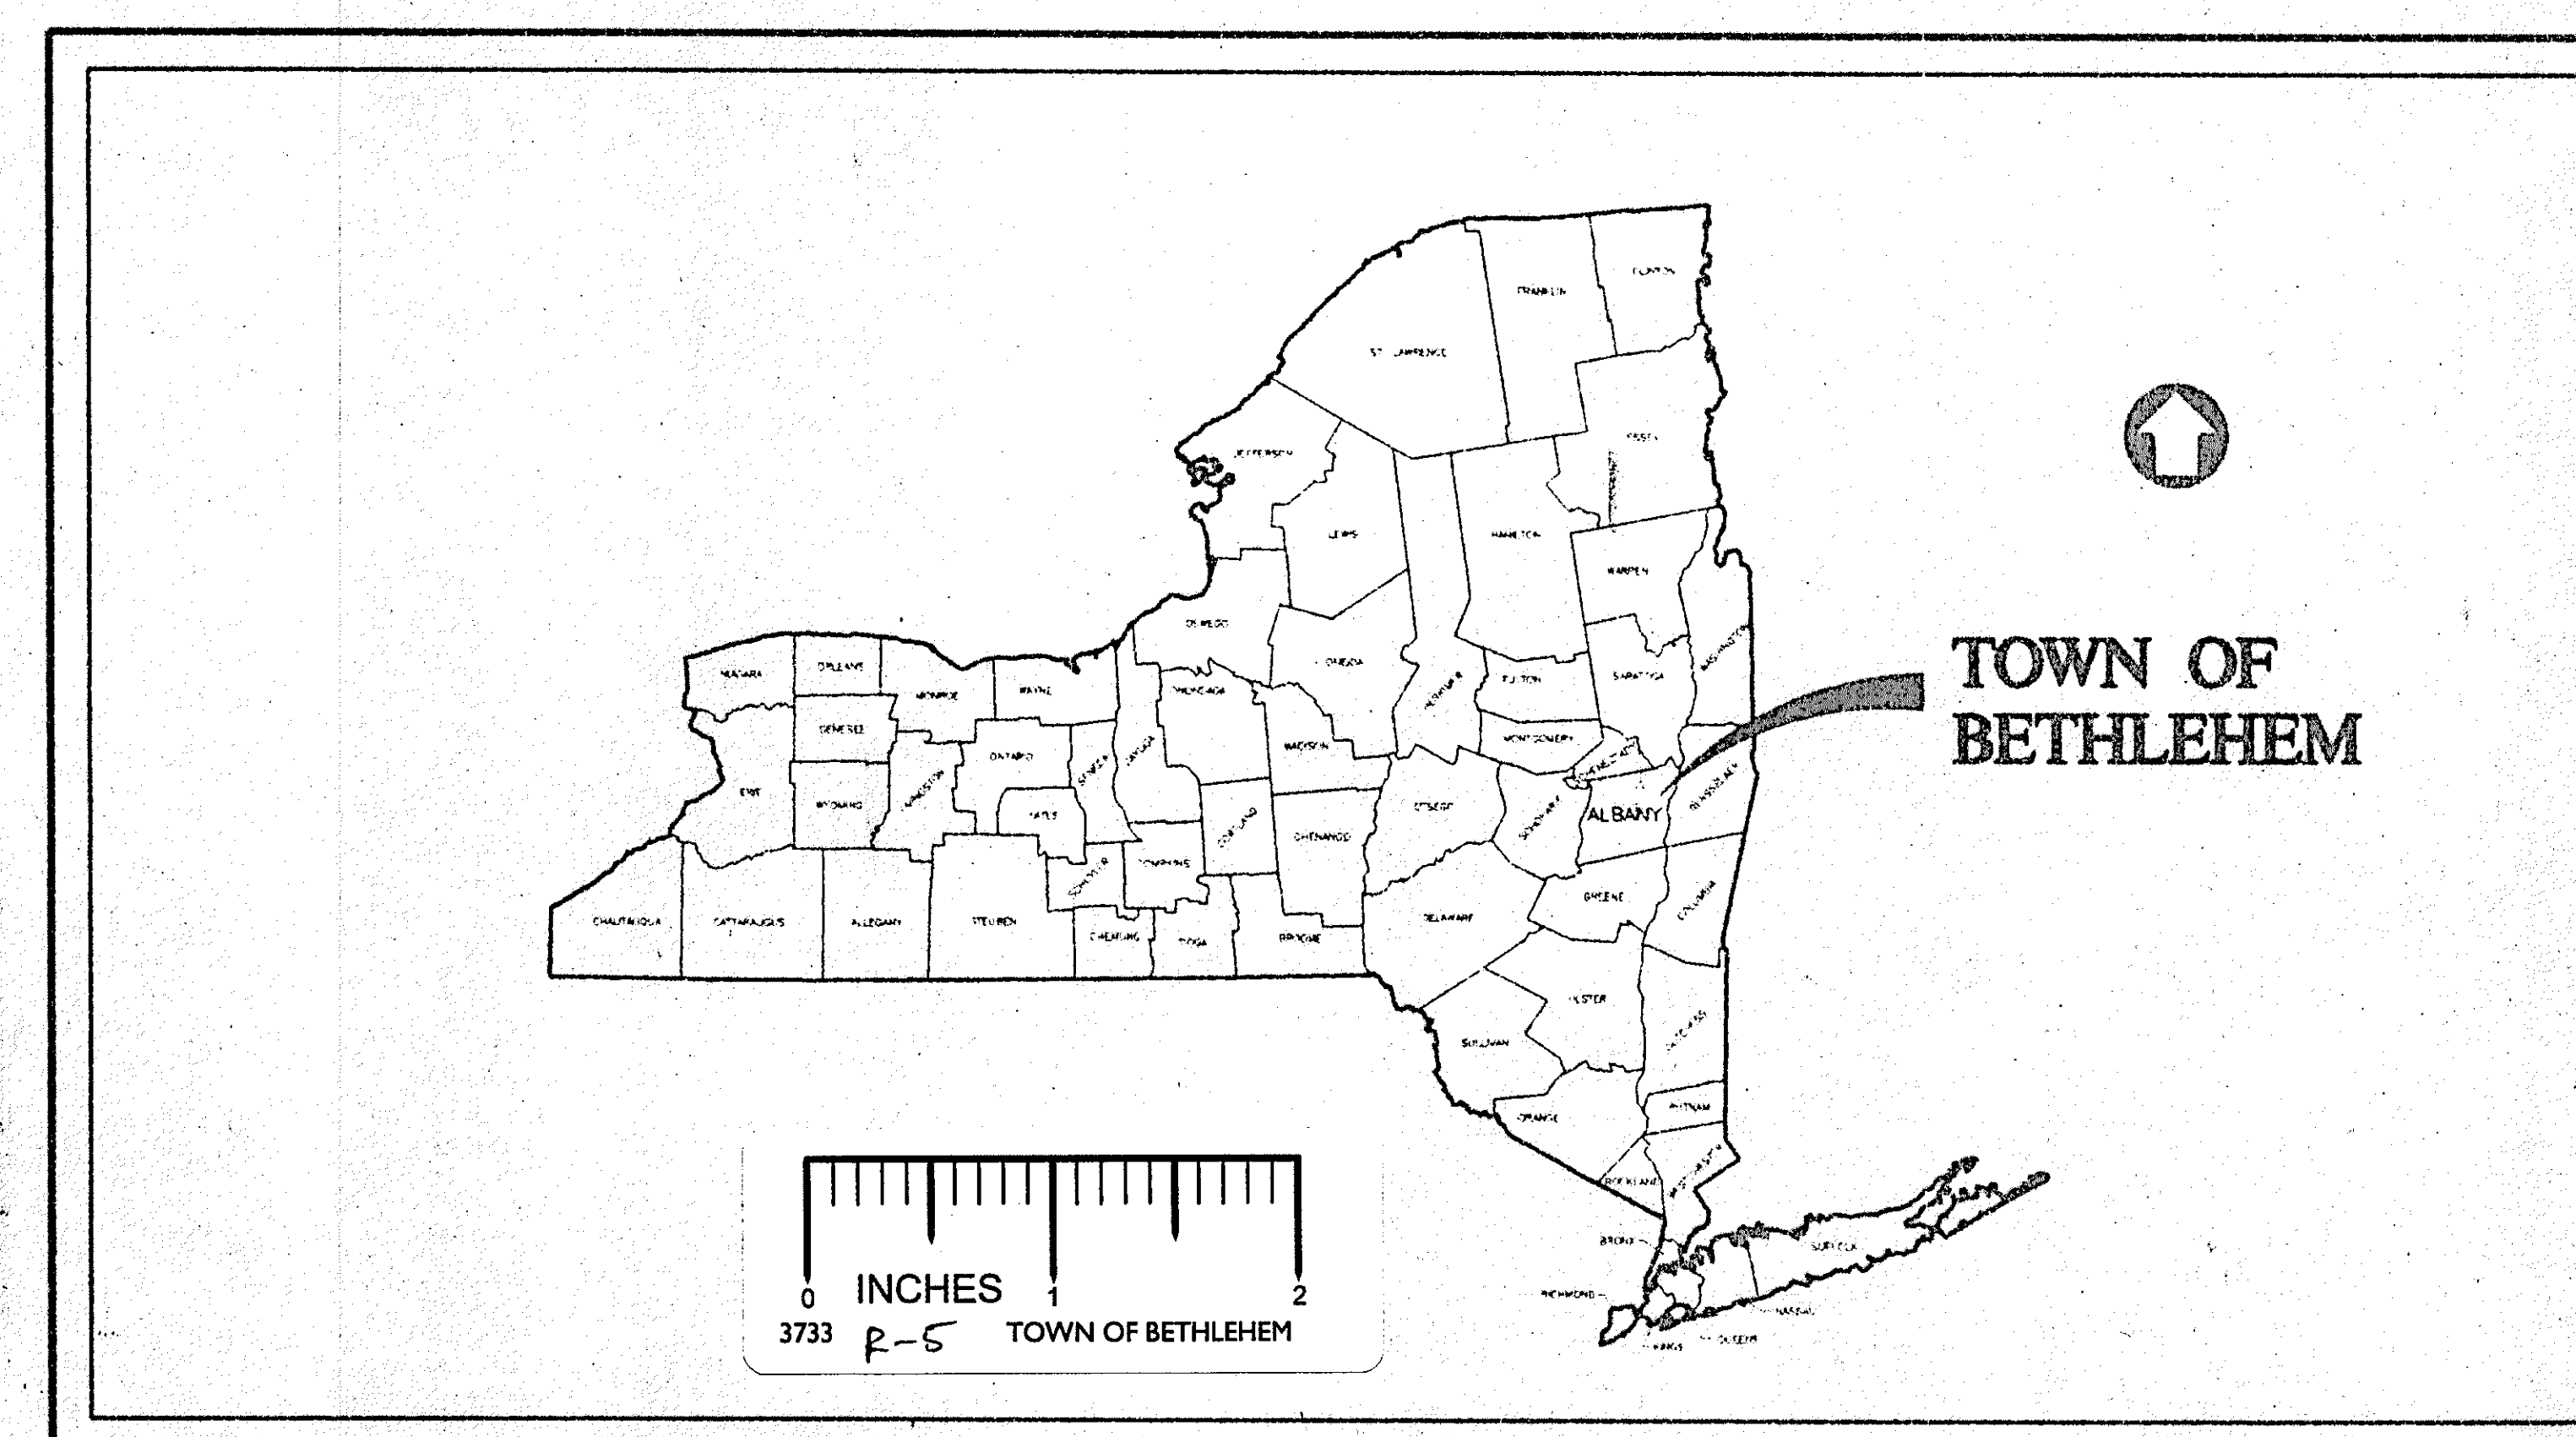

DRAFT

RECORD DRAWING
C.T. MALE ASSOCIATES, P.C.

50 CENTURY HILL DRIVE, P.O. BOX 727, LATHAM, NY 12110
(518) 786-7400 • FAX (518) 786-7299

ENGINEERING • LAND SURVEYING • BUILDING SYSTEMS
LAND PLANNING • ENVIRONMENTAL SERVICES • GPS/GIS SERVICES


DATE: FEB 12, 1999 PROJ. NO: 98.8693 SHEET 1 OF 5
5/30/00 REVISED FOR BID; 9/13/00 RECORD DATA ADDED

DWG. NO: 98-205
00-522

C.T. MALE ASSOCIATES, P.C.

OCT 24 2000

PRINTED AND ISSUED

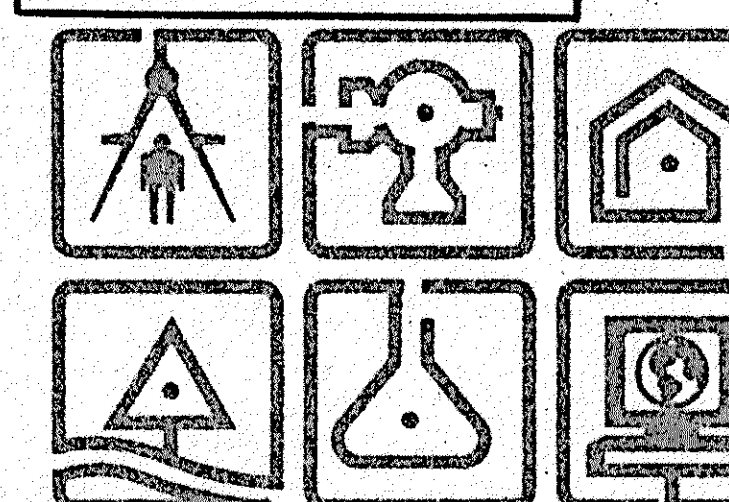

T1

AUTOMATIC

PLOT SCALE FACTOR: 1=50

CAD DWG. FILE NAME: T1.DWG

© 1999
C.T. MALE ASSOCIATES P.C.
UNAUTHORIZED ALTERATION OR ADDITION TO
THIS DOCUMENT IS A VIOLATION OF SECTION
7209 SUBDIVISION 2 OF THE NEW YORK STATE
EDUCATION LAW.

CAD DWG. FILE NAME: T1.DWG