


SILT FENCE FOR TEMPORARY EROSION CONTROL  
(NOT TO SCALE)

DETAIL "A"

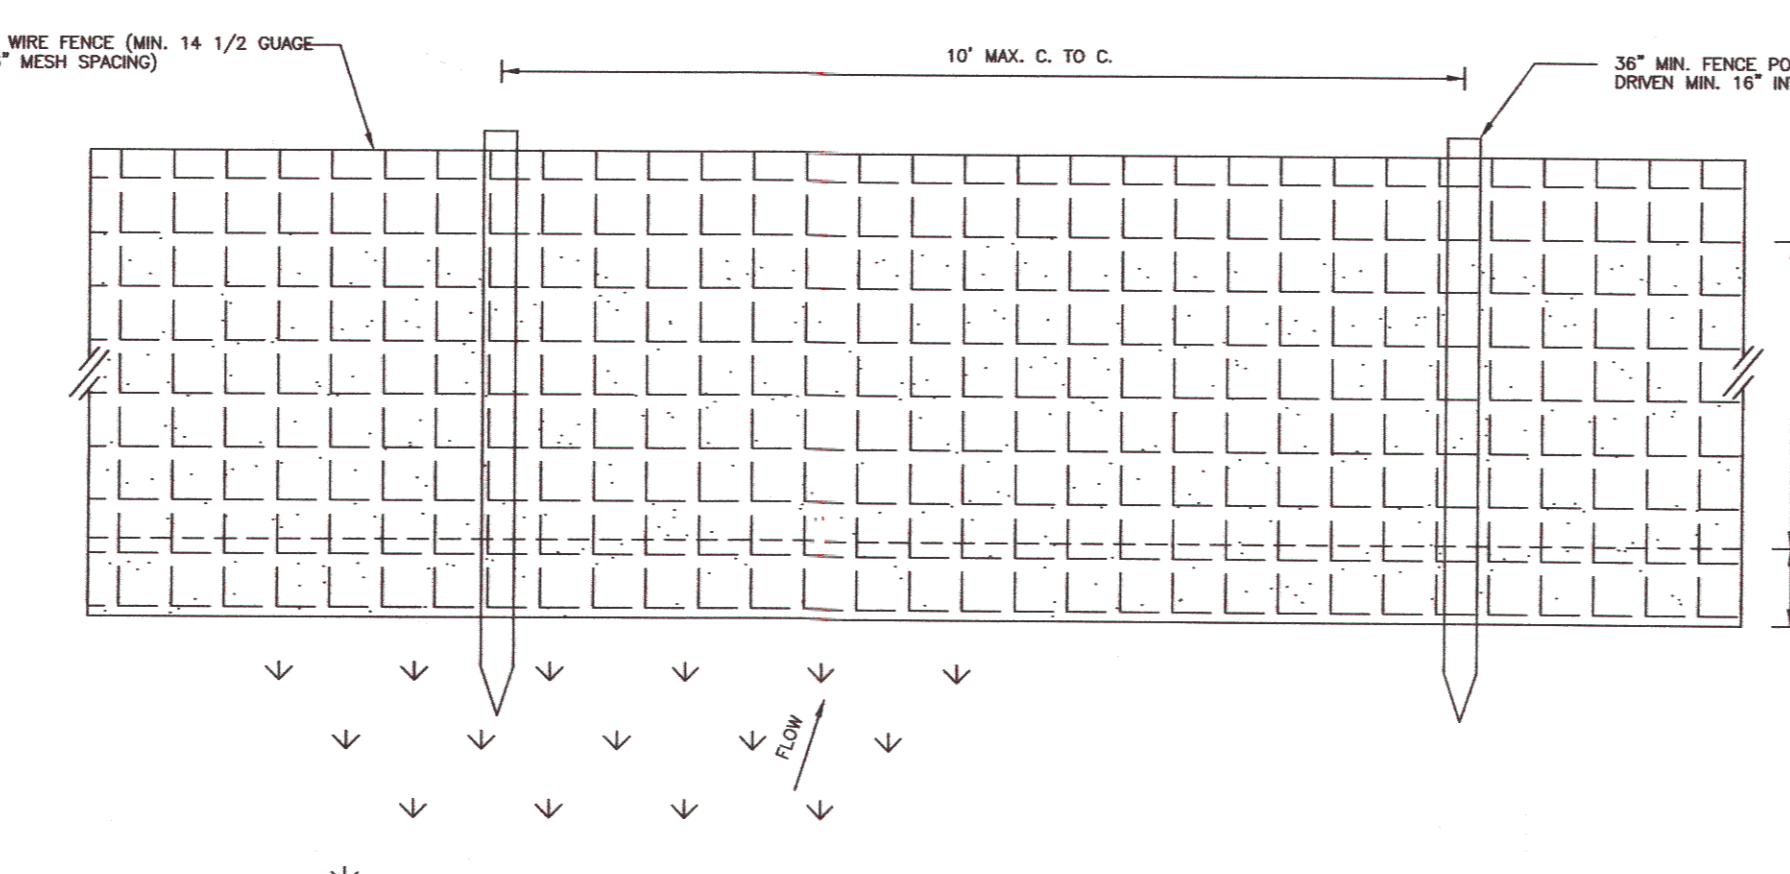


SILT FENCE FOR TEMPORARY EROSION CONTROL  
(NOT TO SCALE)

DETAIL "B"

1. Inspect sediment fences periodically and after each rainfall event.
2. Should fabric tear, decompose, or in any way become ineffective, replace it immediately.
3. Remove sediment deposits promptly to provide adequate storage volume for the next rain and reduce pressure on fence. Take care to avoid undermining fence during cleanout.
4. Remove all fencing materials and unstable sediment deposits after the contributing drainage area has been properly stabilized, inspected, and approved. Grade and stabilize the disturbed area as shown in the vegetation plan.
5. Mulch all exposed soil during construction.


## SILT FENCE FOR TEMPORARY EROSION CONTROL

### MAINTENANCE NOTES

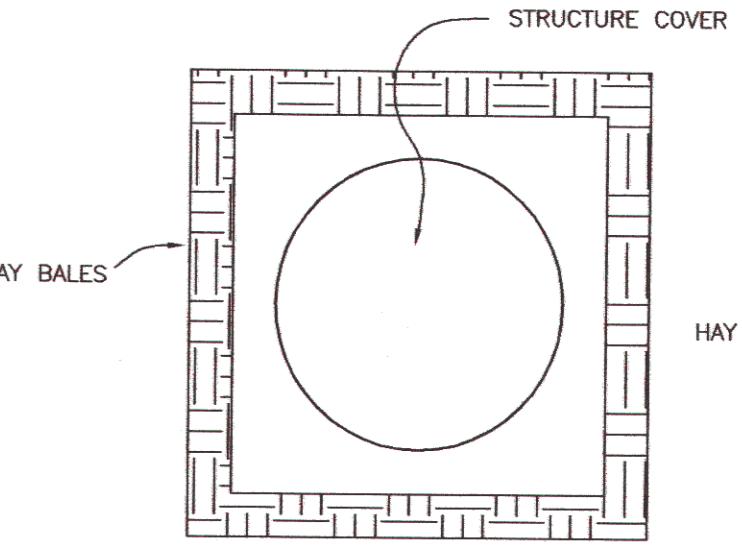

## TYPICAL HAY BALE LOCATION AROUND STRUCTURE COVER

DETAIL "C"

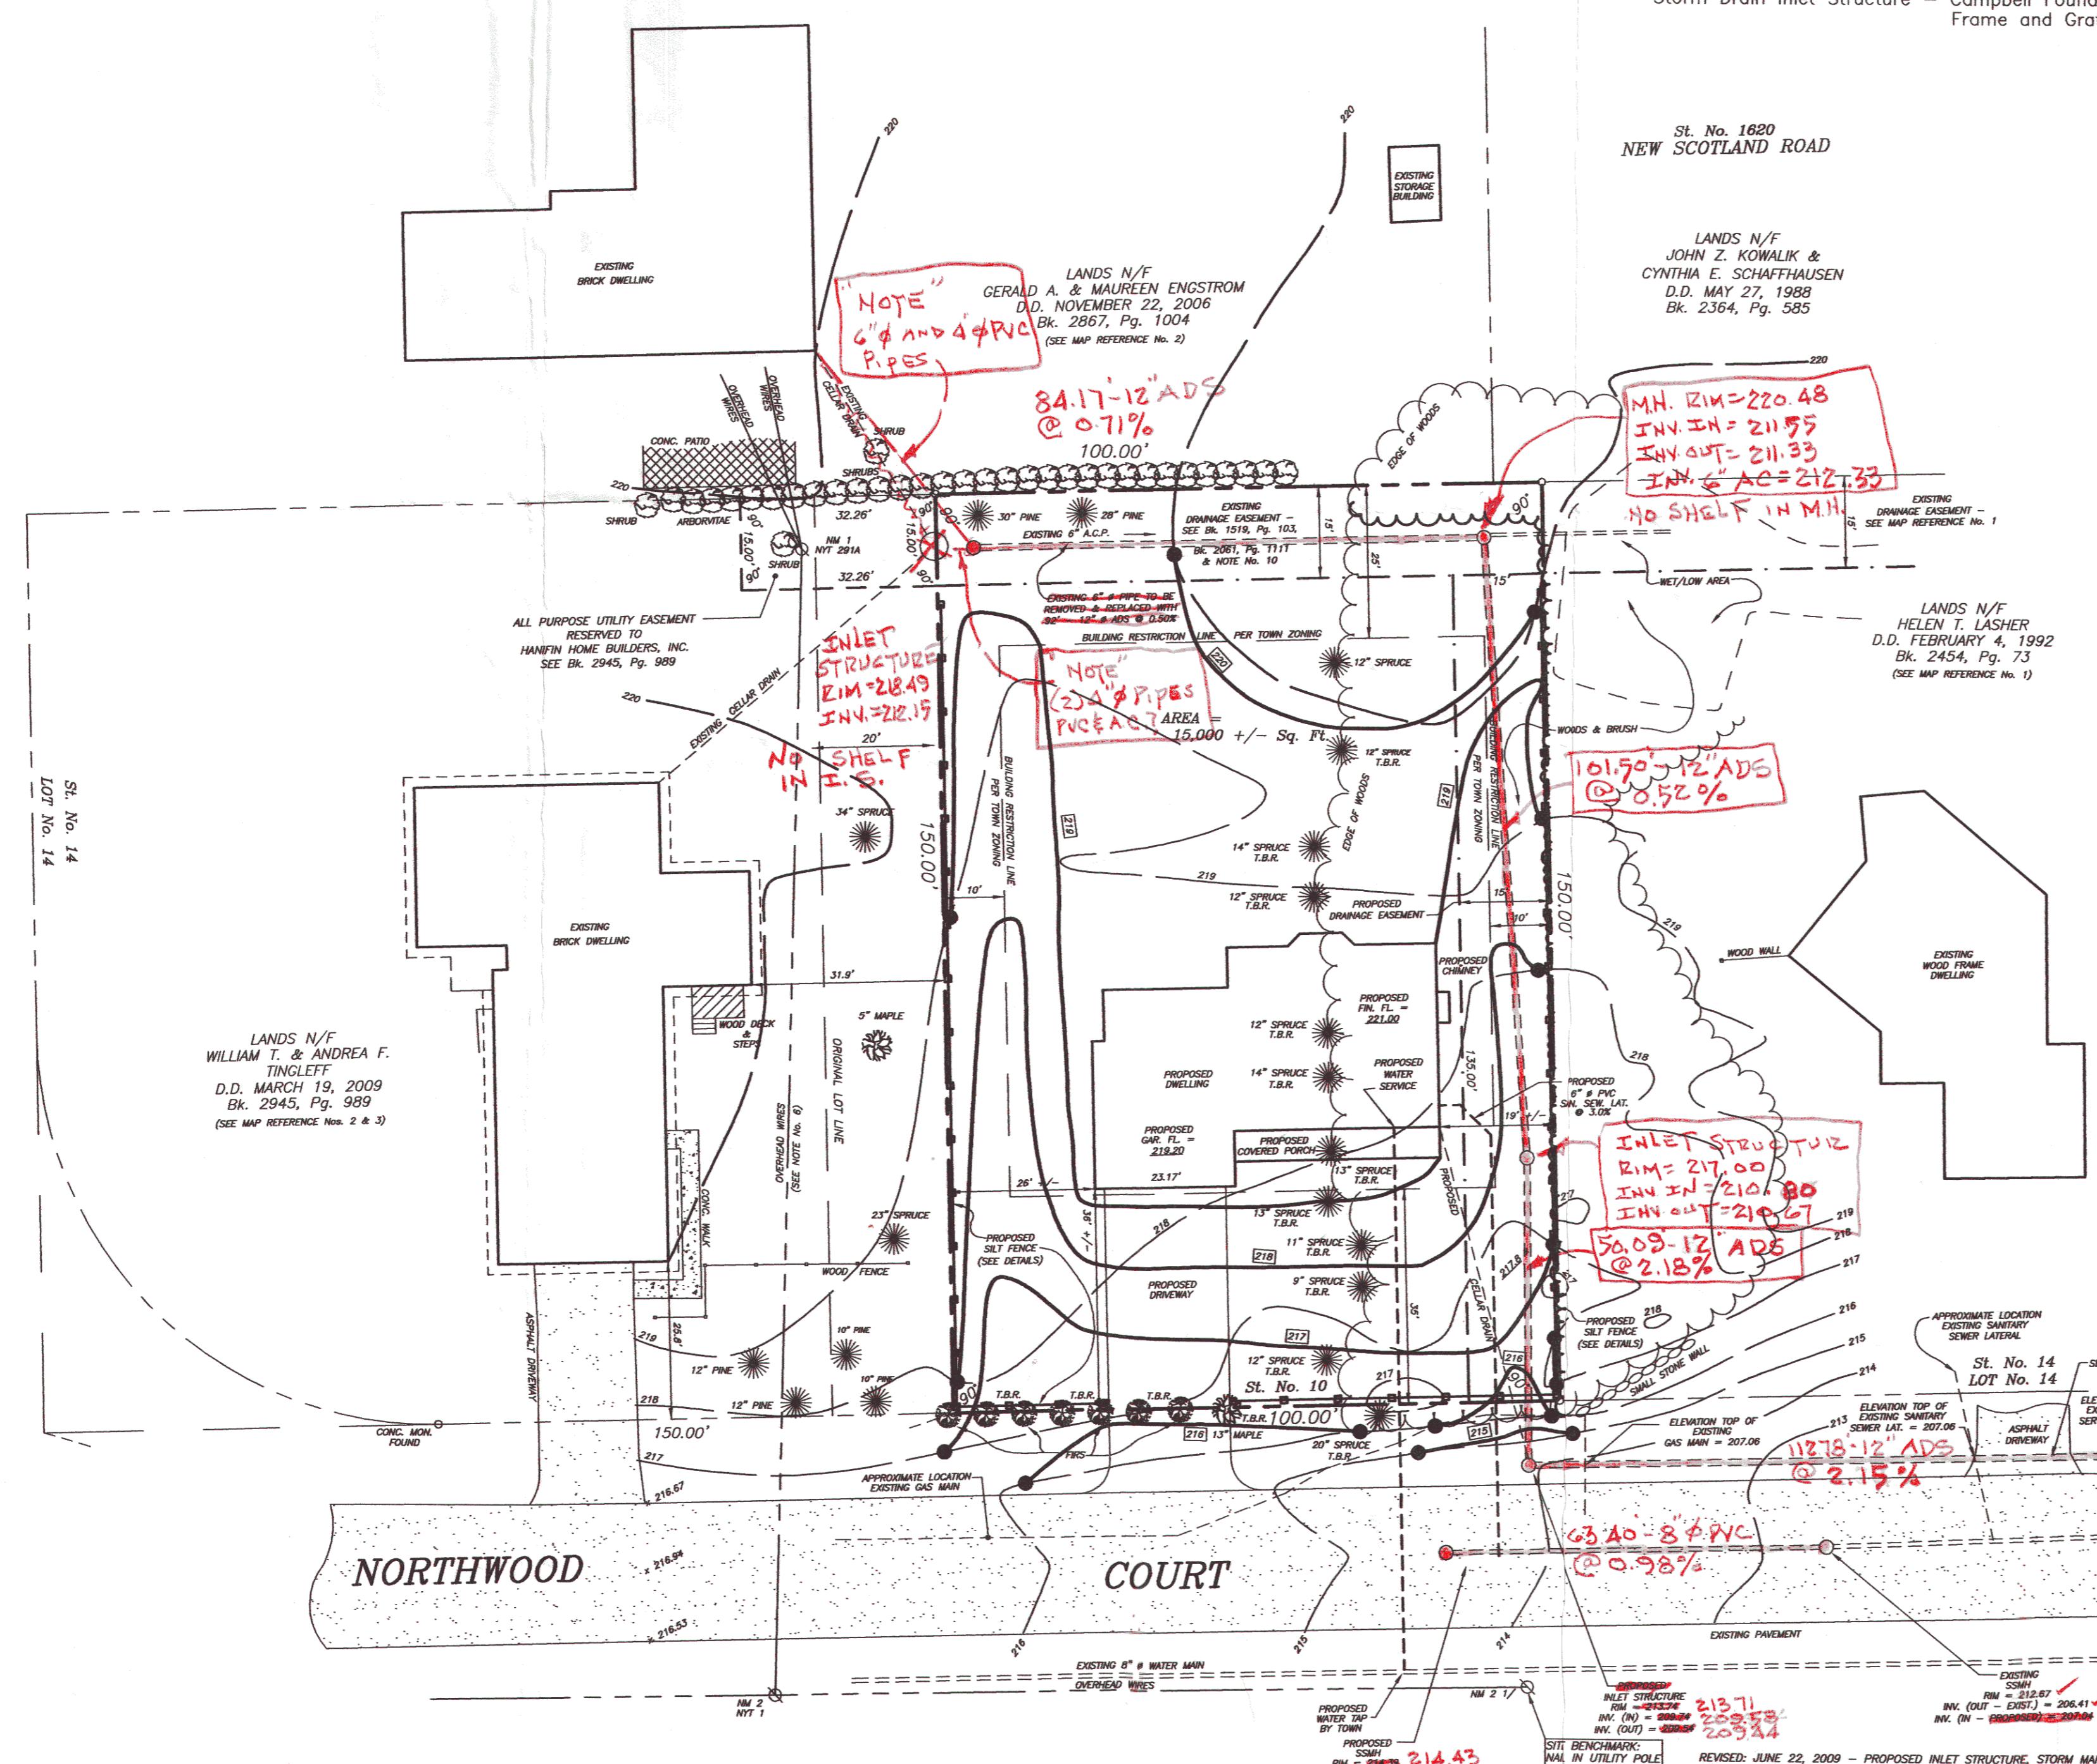

# *THORNDALE ROAD*

TOWN OF BETHLEHEM	
Paul E. Hite, L.L.S. L.S. #45369	
COUNTY:	ALBANY
STATE:	NEW YORK
SCALE:	1" = 20'
DATE:	APRIL 14, 2009
DRAWN BY:	SHD
	MAP NO.: 726S-10
MAP PREPARED BY: <b>PAUL E. HITE</b> LICENSED LAND SURVEYOR 230 DELAWARE AVENUE DELMAR, NEW YORK 12054 (518) 439-4989	

MAP PREPARED BY:  
**PAUL E. HITE**  
LICENSED LAND SURVEYOR  
230 DELAWARE AVENUE  
DELMAR, NEW YORK 12054  
(518) 439-4989