
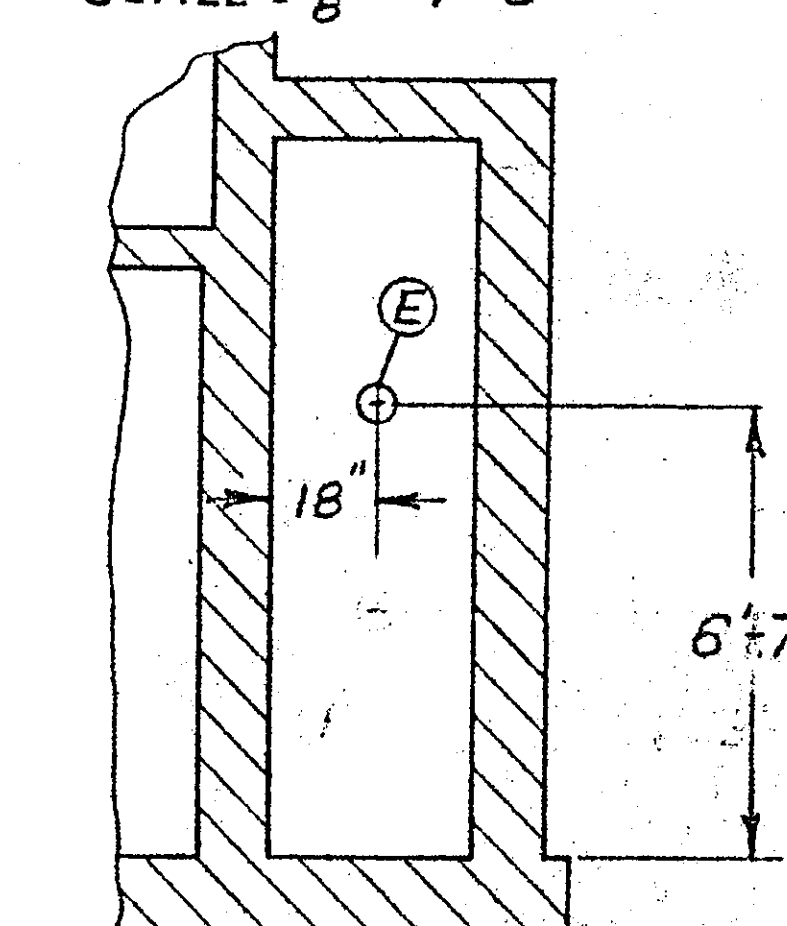
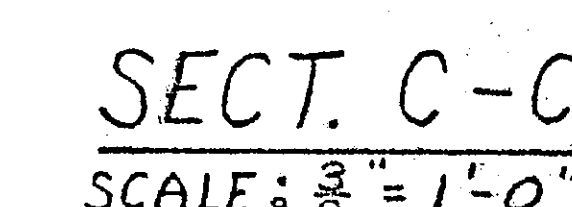
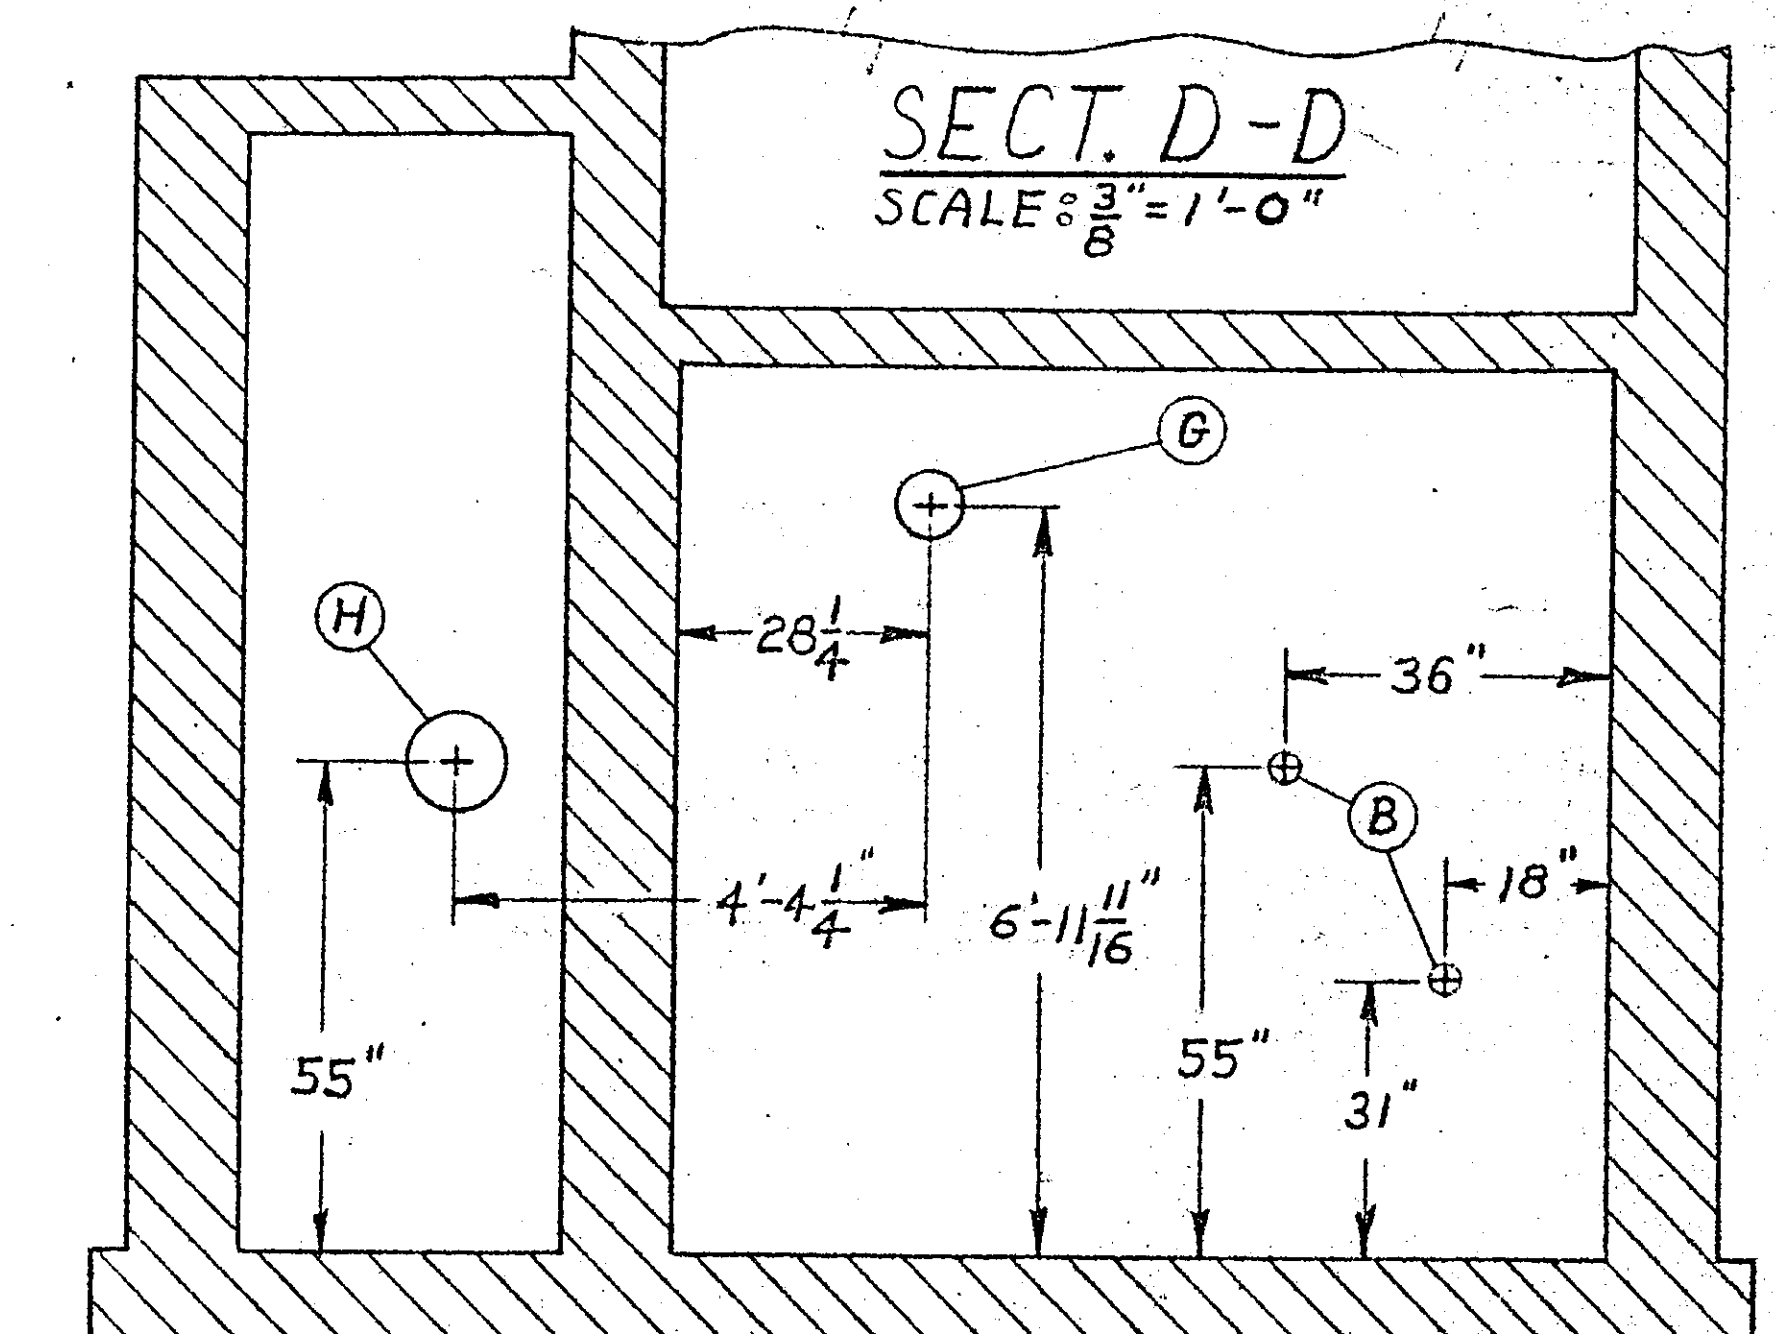
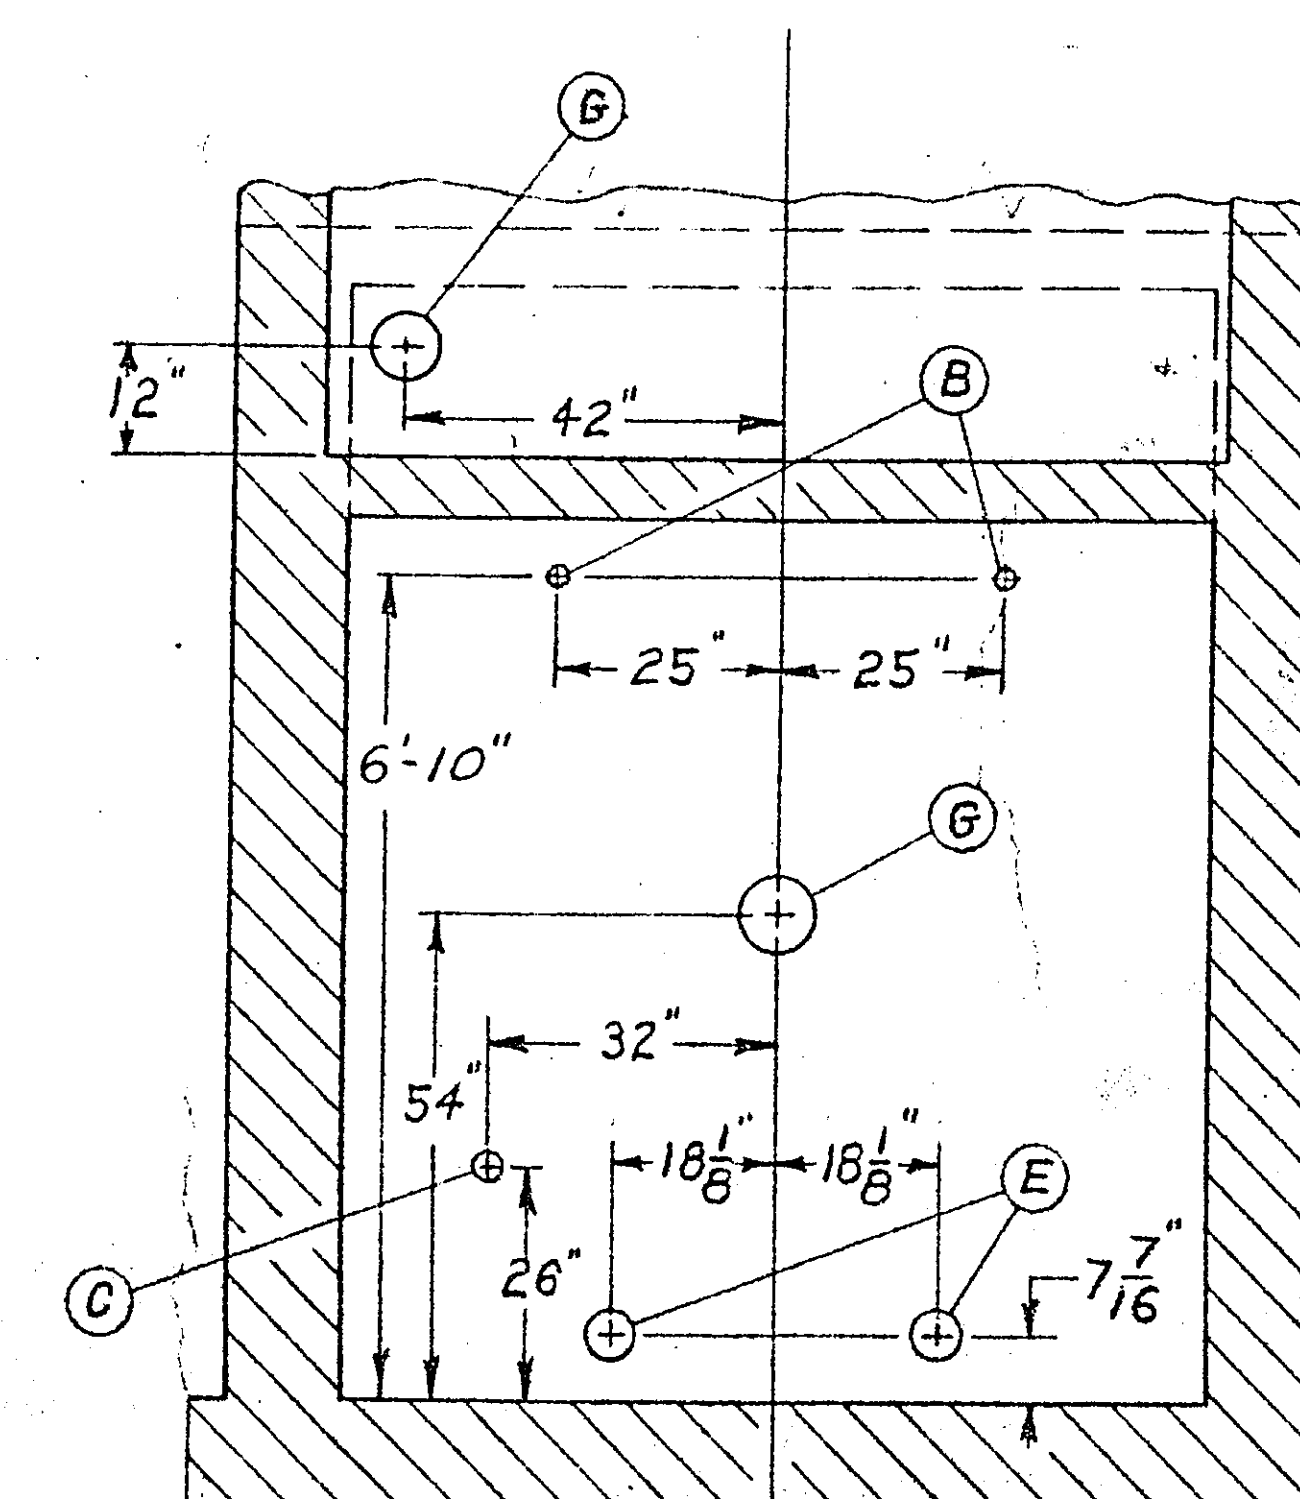
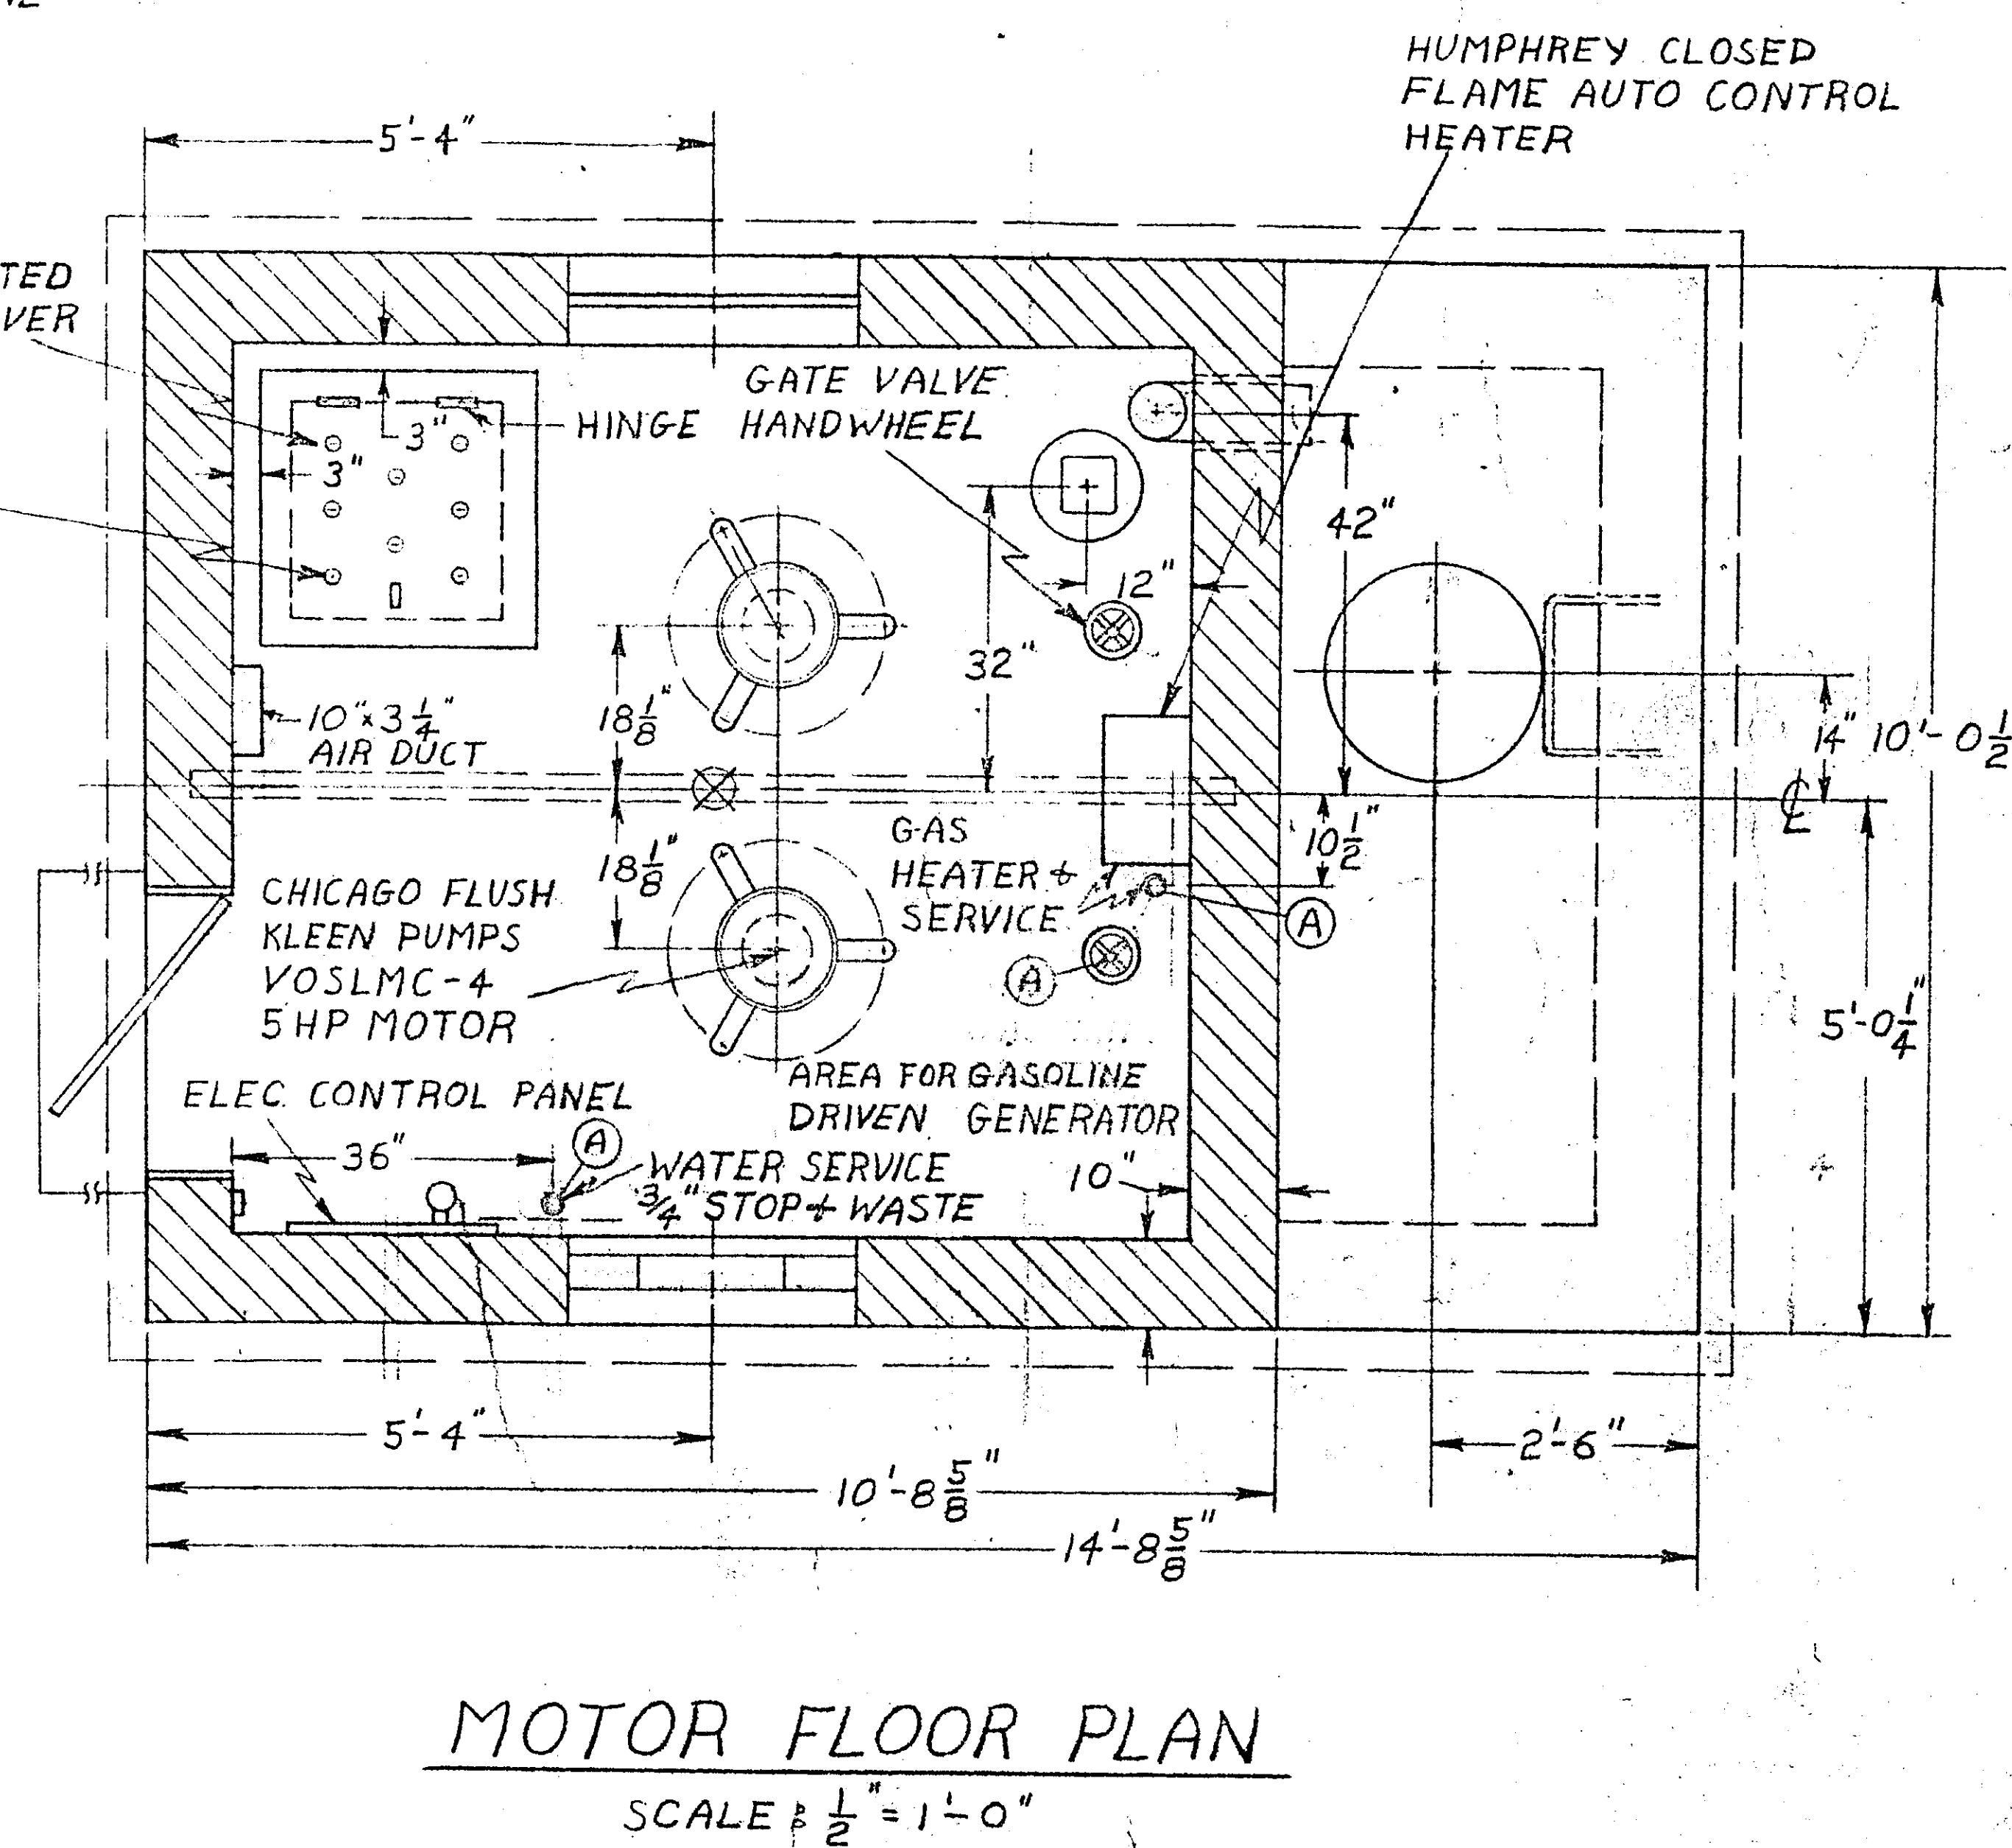
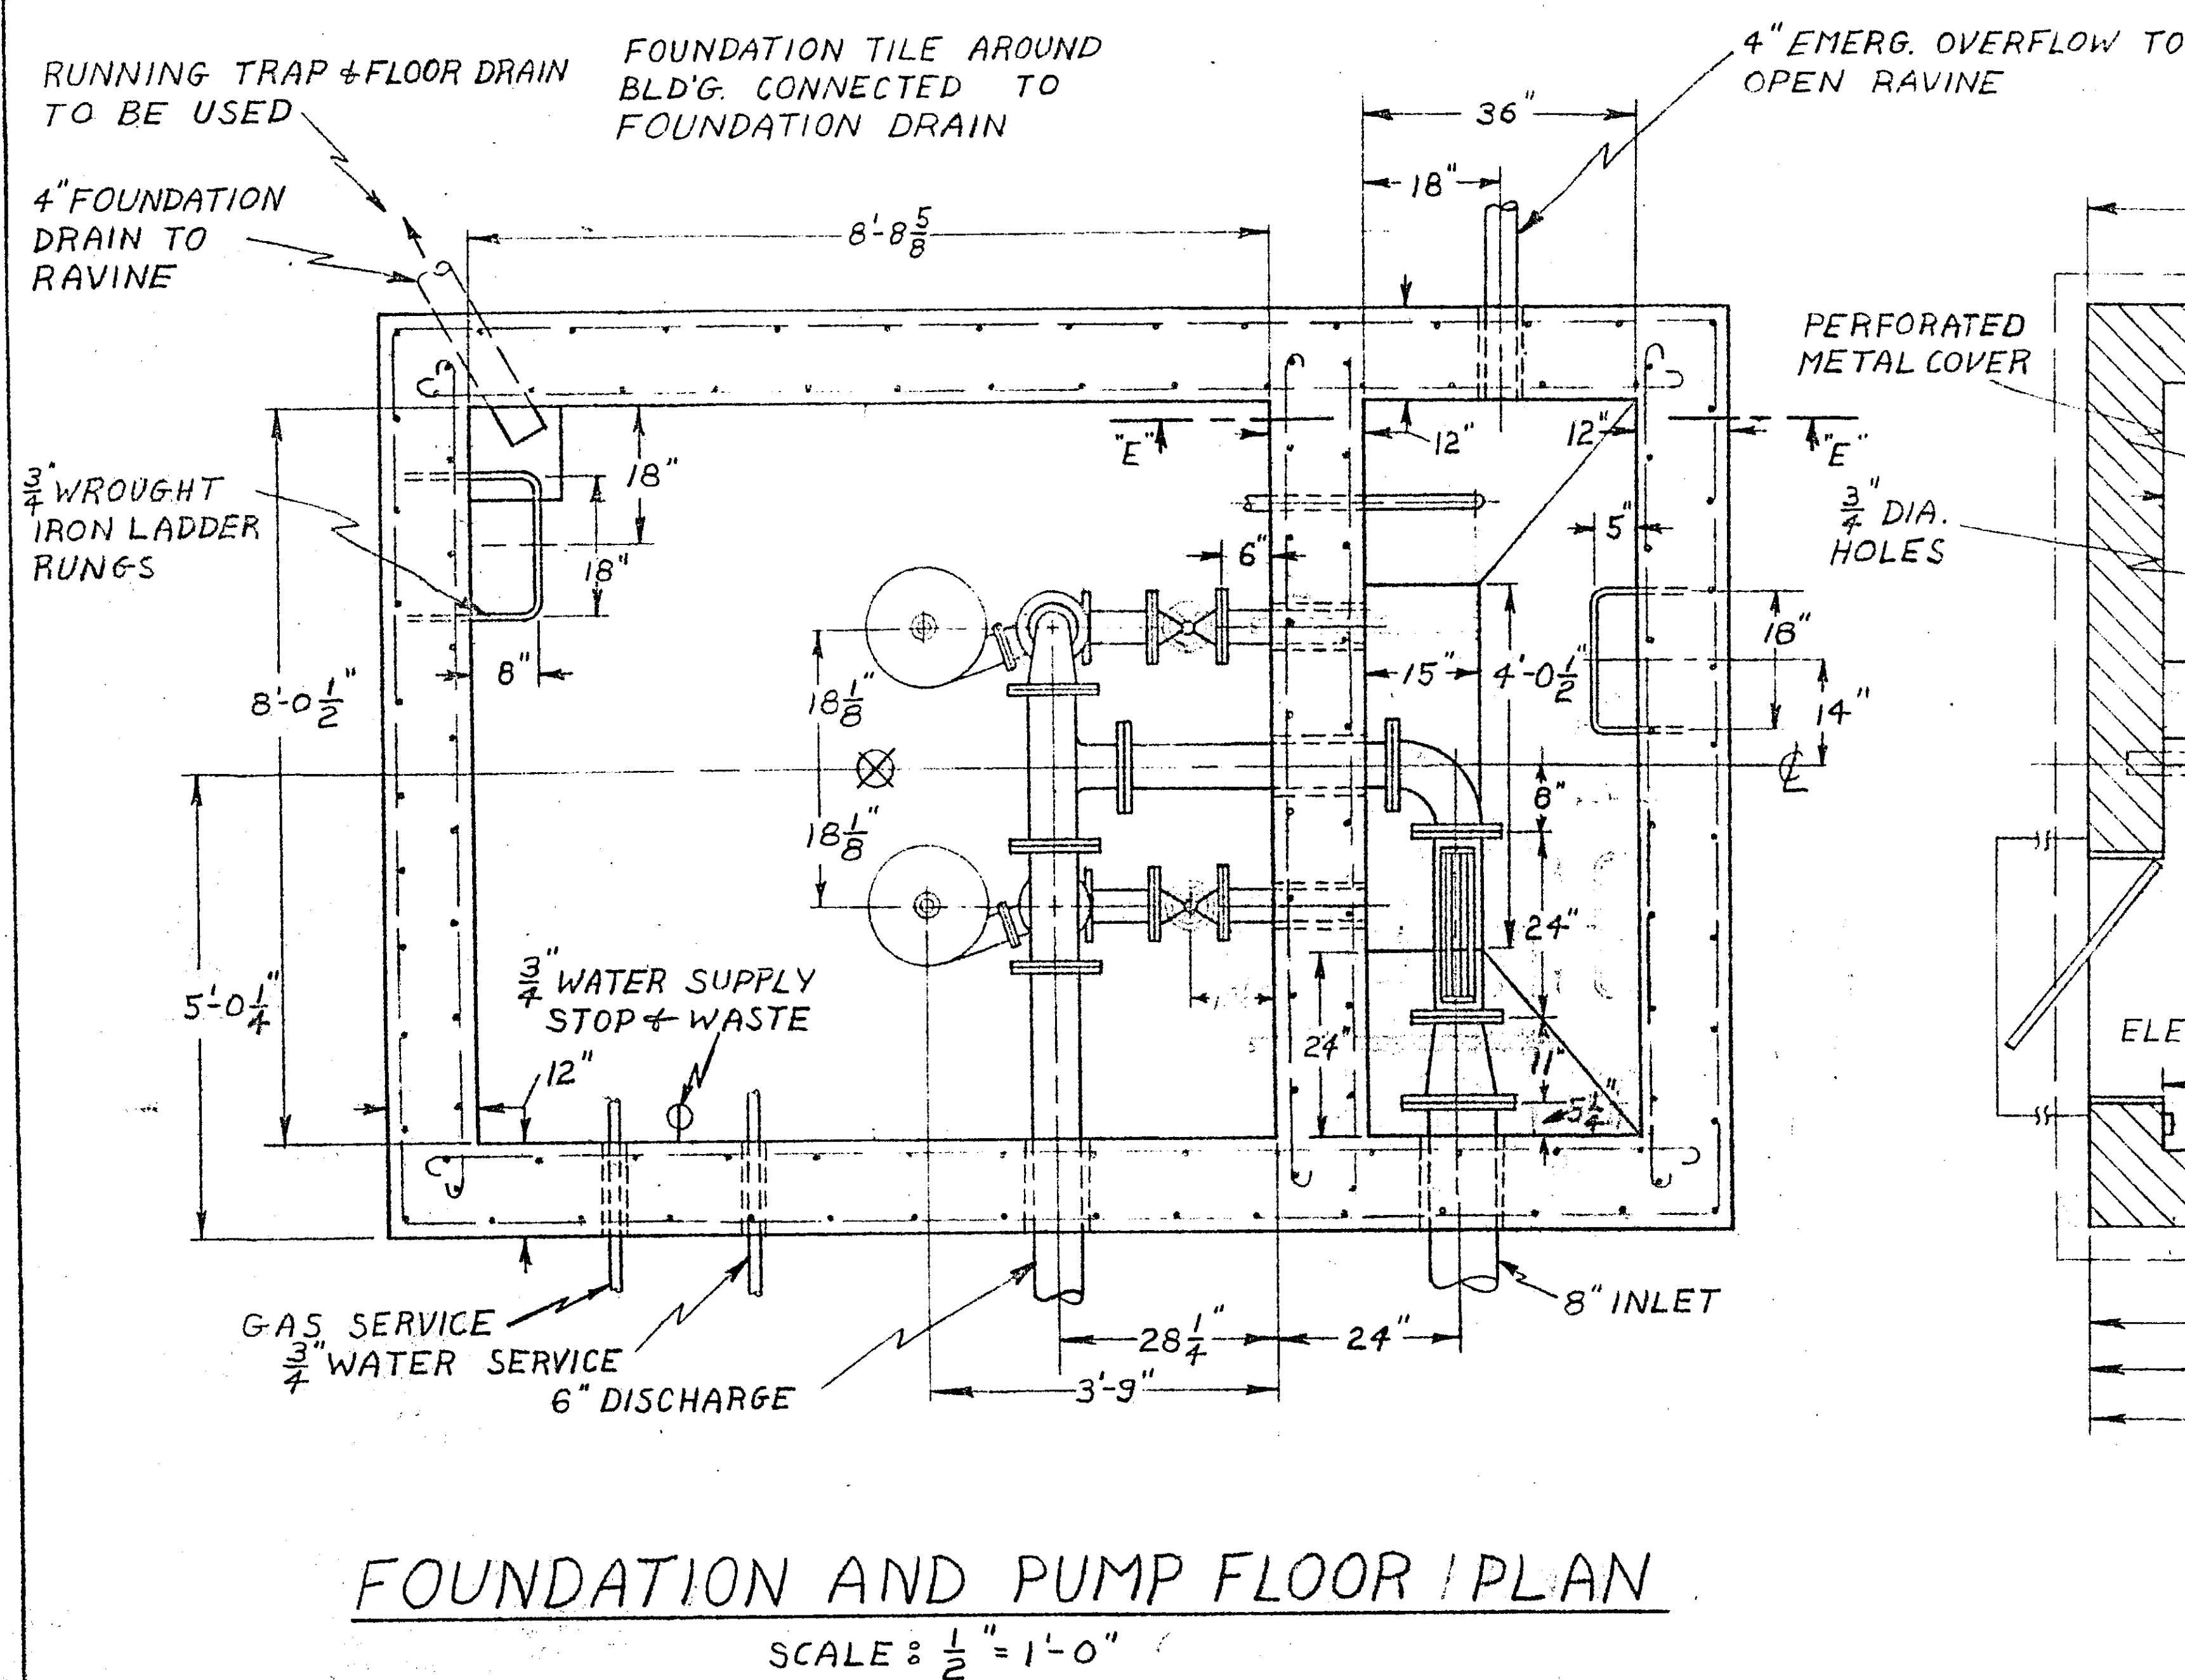
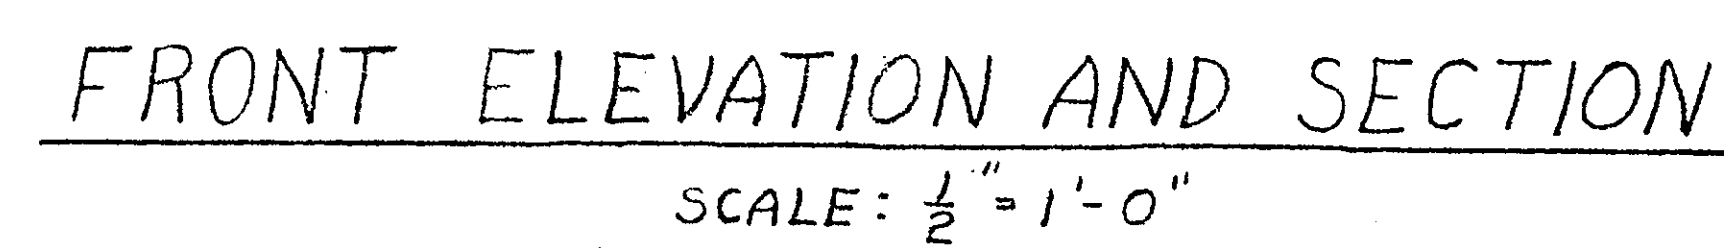


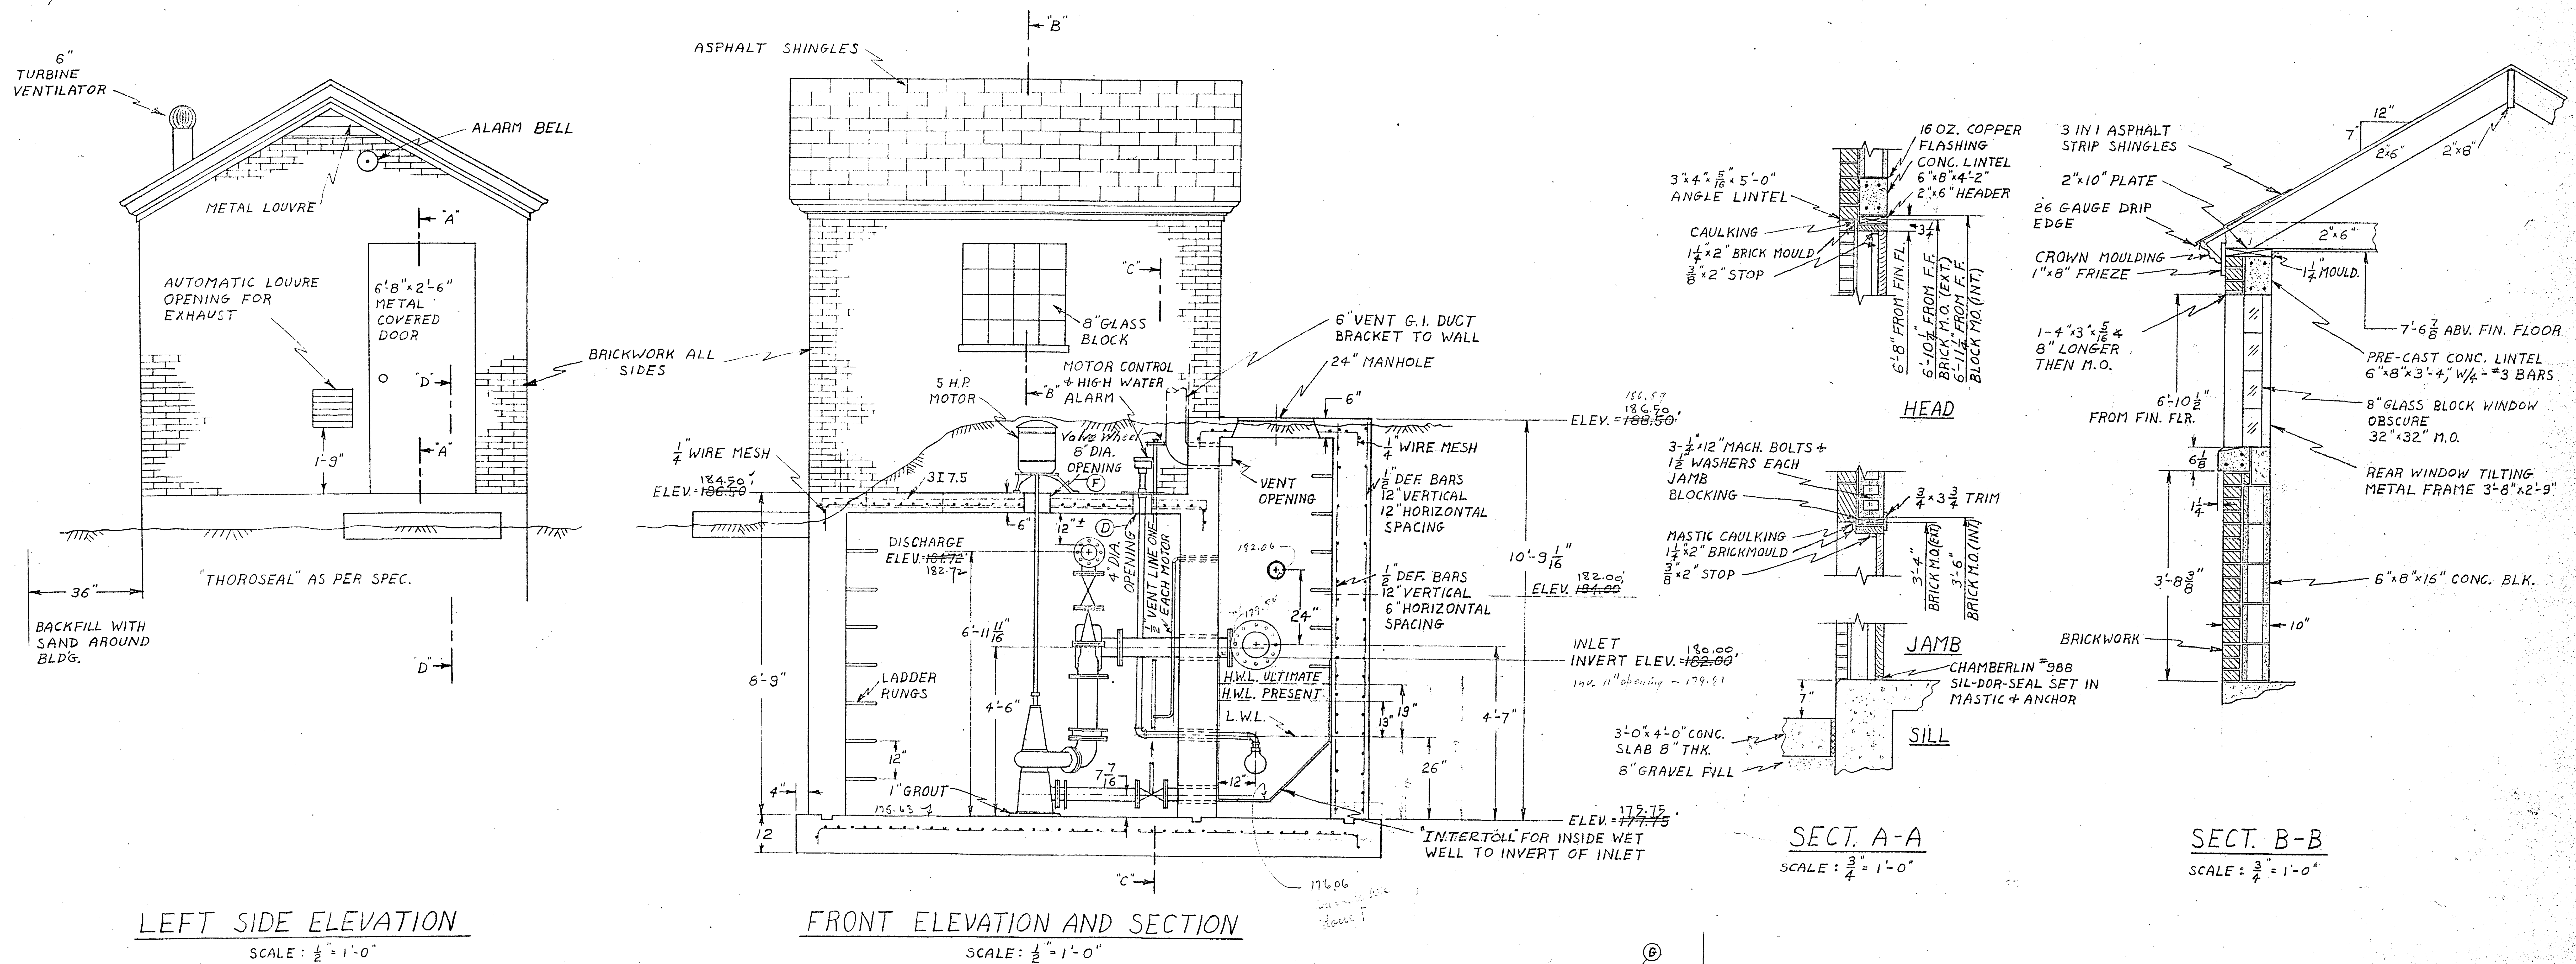

SLEEVE DESIG.	QTY	INSIDE DIA.	LGTH.
A	4	2"	7"
B	4	2"	14"
C	1	4"	14"
D	1	6"	7"
E	3	6"	14"
F	1	8"	7"
G	3	8"	14"
H	1	10"	14"

NOTE: REINFORCING, ALL VERTICAL BARS
ARE $\frac{1}{2}$ " DEF. BARS 12" C-C. HORIZONTAL
BARS ARE $\frac{1}{2}$ " DEF. 6" C-C BELOW
ELEV. 184.00' AND 12" C-C ABOVE.

3450 TOWN OF BETHLE

Note

Orig. Elevations at Pump St.
lowered 2' 00'

~~_____~~

AS SHOWN IN RED

SEWAGE PUMPING STATION DETAILS
"KENHOLM" SUBDIVISION"
DELMAR-ELSMERE SEWER DISTRICT
TOWN OF BETHLEHEM ALBANY CO. N.Y.
SCALE AS SHOWN OCT. 15, 1959

DRAWN BY J. H. Kautz	DATE OCT. 17, 1959	REVISIONS
DESIGN BY Edward W. Boushelle and Sons Civil Engineers and Surveyors		

SHEET