

BETHLEHEM CENTRAL SCHOOL DISTRICT
TRANSPORTATION DEPARTMENT
NEW CONSTRUCTION, ADD'S, ALTER'S, AND SITEWORK





4	1	12/1/20	Issue for 312 C-1
3	1	4/6/20	Issue for 312 C-2
2	1	10/1/19	Revision 1
1	1	10/1/19	Revision 1

Drawn By: JTC	Checked By: JTC
Proj. No. 01-03-06-06-5-010-008	Proj. No. 01-03-06-06-5-010-008
CSA Project # 04102-20	CSA Project # 04102-20
Date: FEBRUARY 3, 2009	Date: FEBRUARY 3, 2009

SITE
UTILITY
PLAN

Sheet No. **TR**
C104

COLLINS+SCOVILLE
ARCHITECTS, P.C.
40 Beaver St., Albany
New York 12207-1311
518.463.8068 FAX 518.463.8069

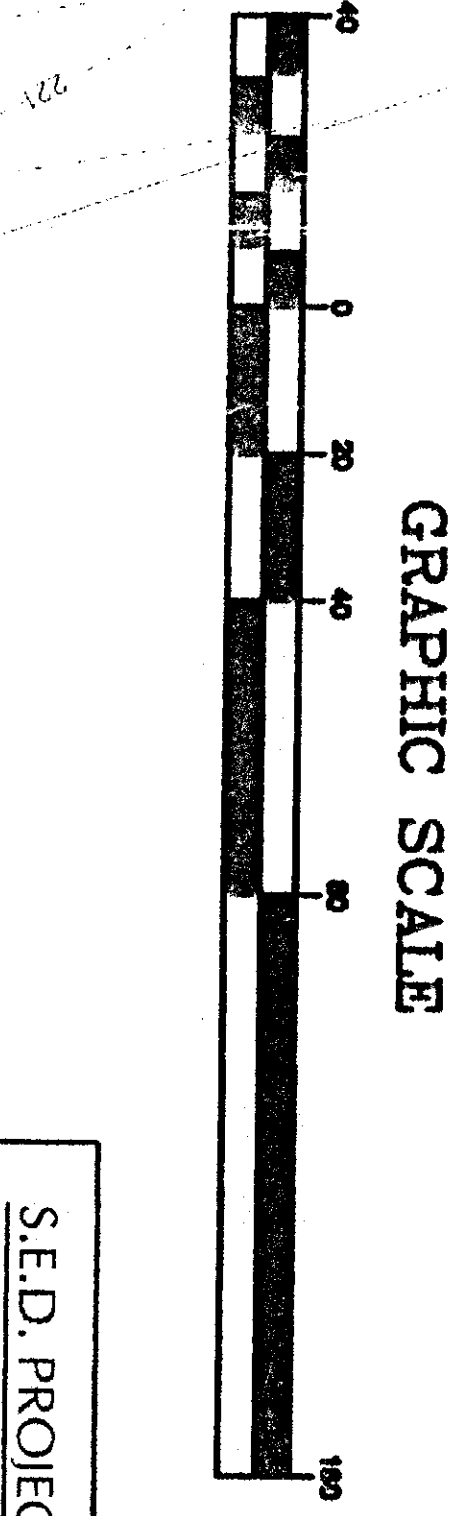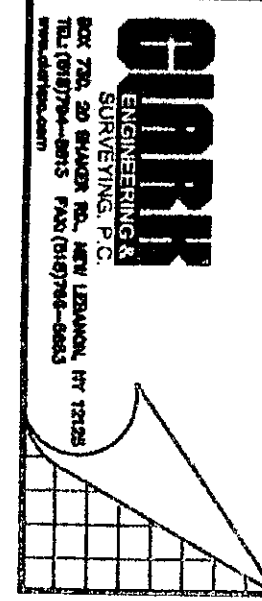

S.E.D. PROJECT CONTROL NUMBERS:
BUS GARAGE: 01-03-06-06-5-010-008
BUS WASH: 01-03-06-06-5-027-001

CONSTRUCTION DOC

