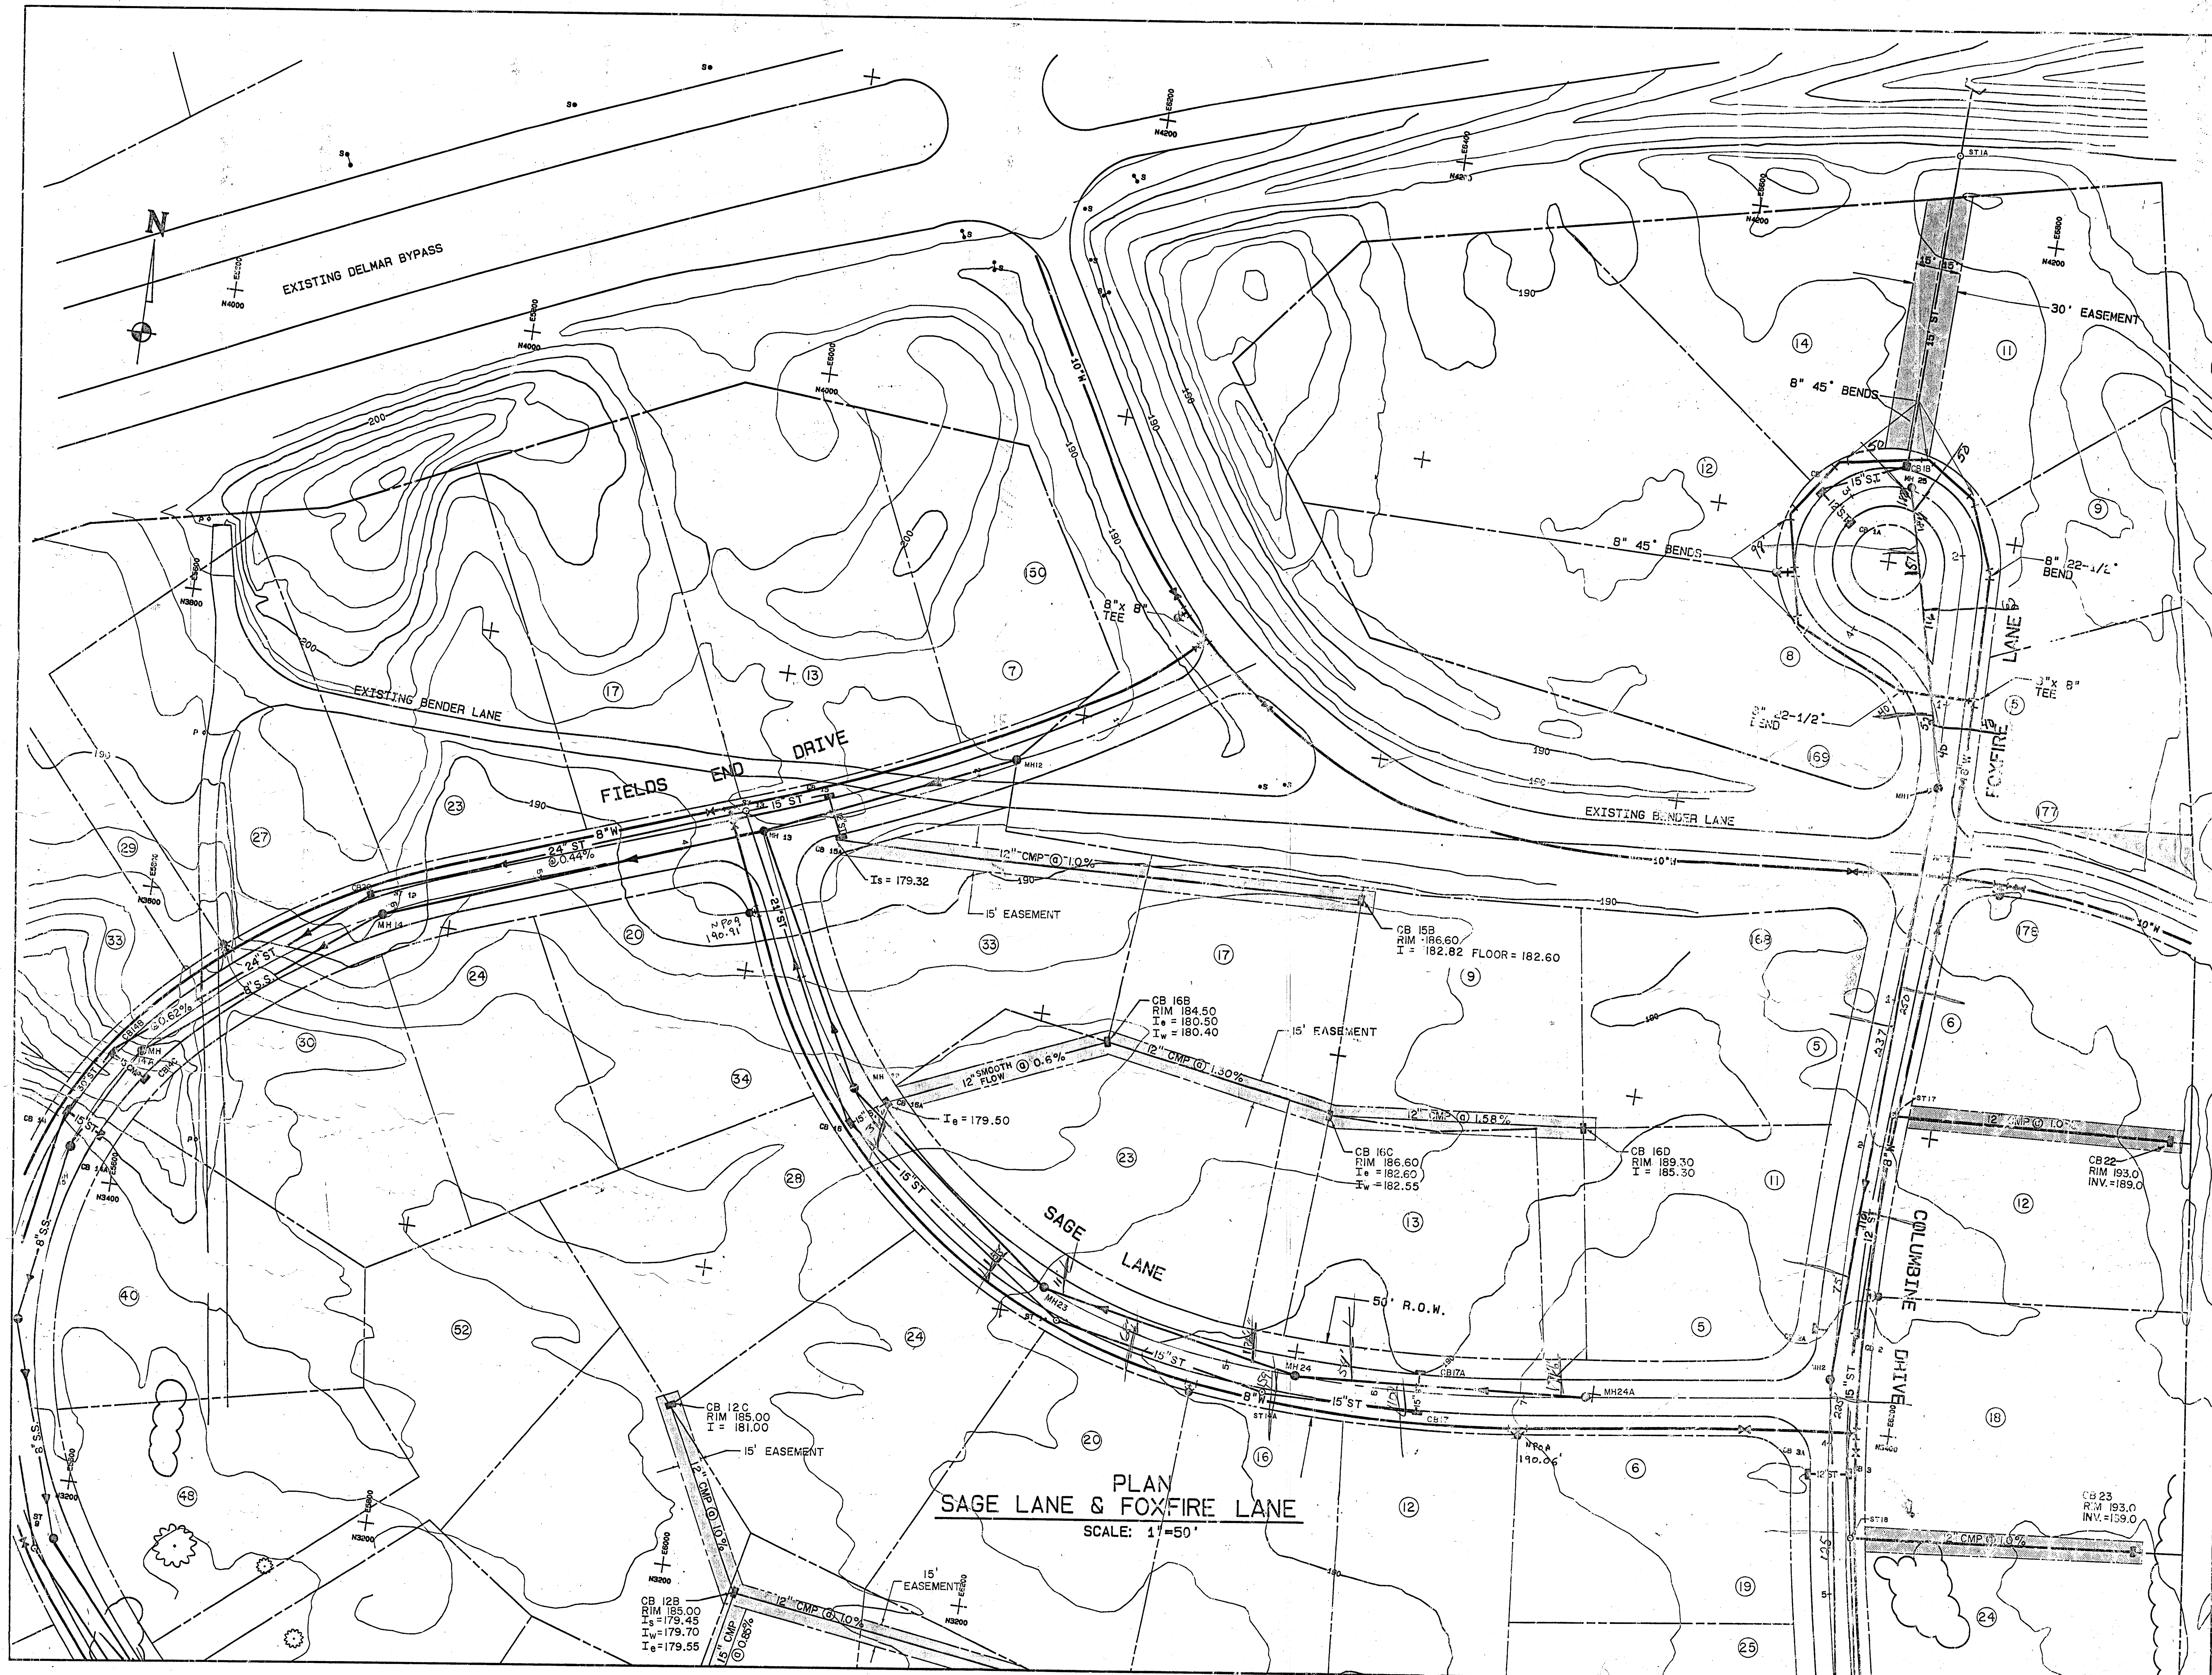


NOTES
ALL CONSTRUCTION DISTURBANCES ON
STATE OR PRIVATE LAND TO BE
RESTORED BY CONTRACTOR

UNAUTHORIZED ALTERATIONS OR ADDITIONS TO THIS DOCUMENT
IS A VIOLATION OF SECTION 2 OF THE
NEW YORK STATE EDUCATION LAW


REVISIONS			
DATE	BY	DESCRIPTION	SYMBOL
6/87	JB	PROPERTY LINE FINAL CORRECTIONS	NC1
12/93	JB	UTILITIES EDITED PER FINAL GRADING	
3/12/96	JB	FINAL REVISIONS	173

J. KENNETH FRASER
AND ASSOCIATES, P.C.
CONSULTING ENGINEERS
RENSSELAER, NEW YORK

R & R
ASSOCIATES

THE MEADOWS
SUBDIVISION

TOWN OF BETHLEHEM
NEW YORK

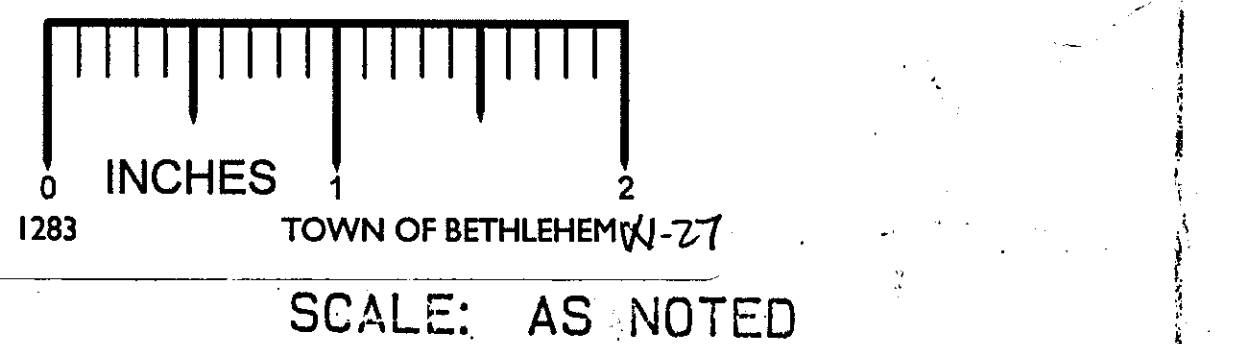



PROJ. ENG'R: JKF
DRAWN BY: FLS
ASSEMBLED BY: FLS
CHECKED BY: JKF
REF. NO. 238645.005