


ADAMS PLACE  
WATER DISTRICT NO. 1  
TOWN OF BETHLEHEM  
RECORD OF INSTALLATION  
TOWN OF BETHLEHEM ENGINEERING  
DEPARTMENT  
SCALE: 1" = 50' FEBRUARY, 1982  
DWN. BY: PDH



ADAMS

PLACE

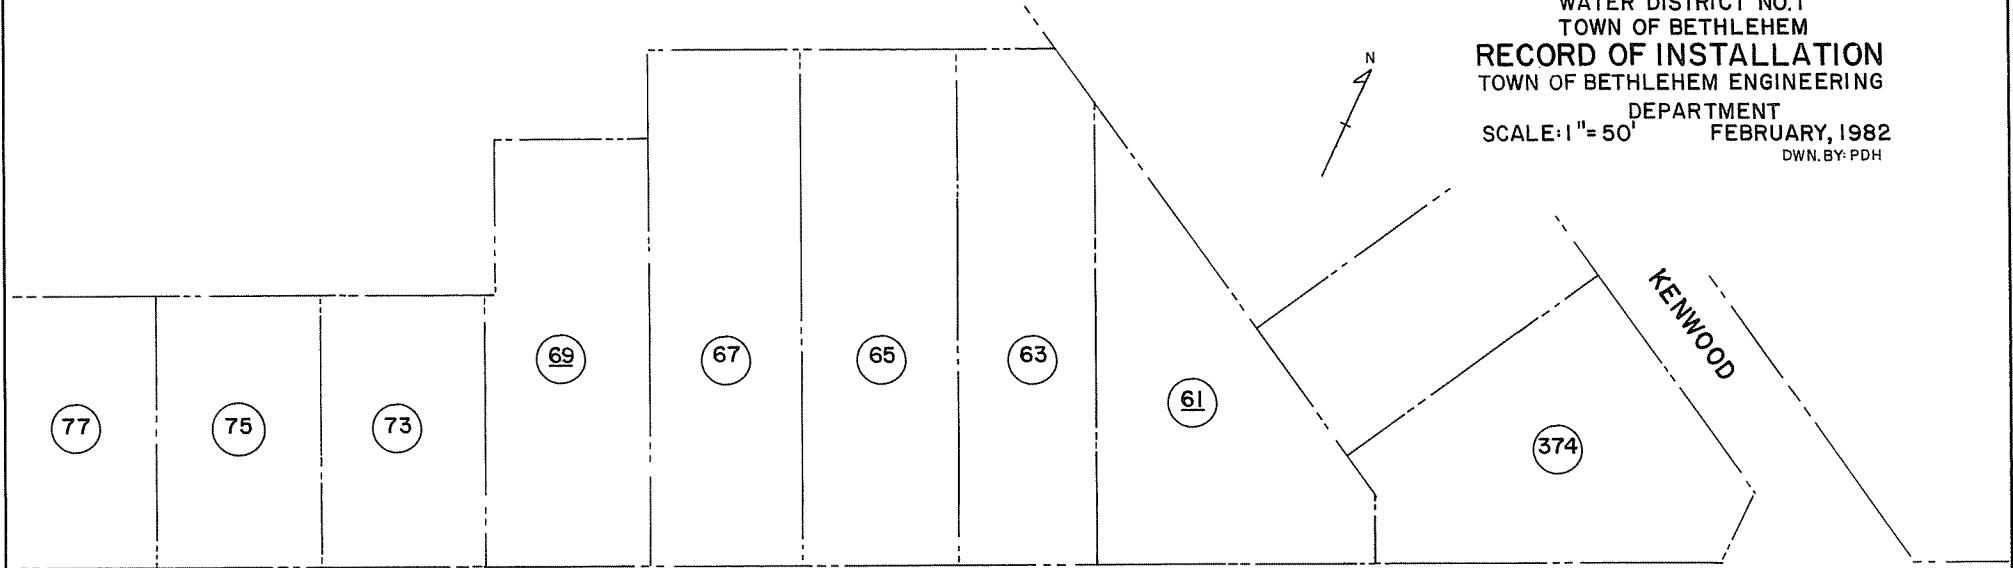