


ADAMS PLACE
WATER DISTRICT NO. 1
TOWN OF BETHLEHEM

RECORD OF INSTALLATION
TOWN OF BETHLEHEM ENGINEERING
DEPARTMENT
SCALE: 1"=50'
FEBRUARY, 1982
DWN.BY: PDH

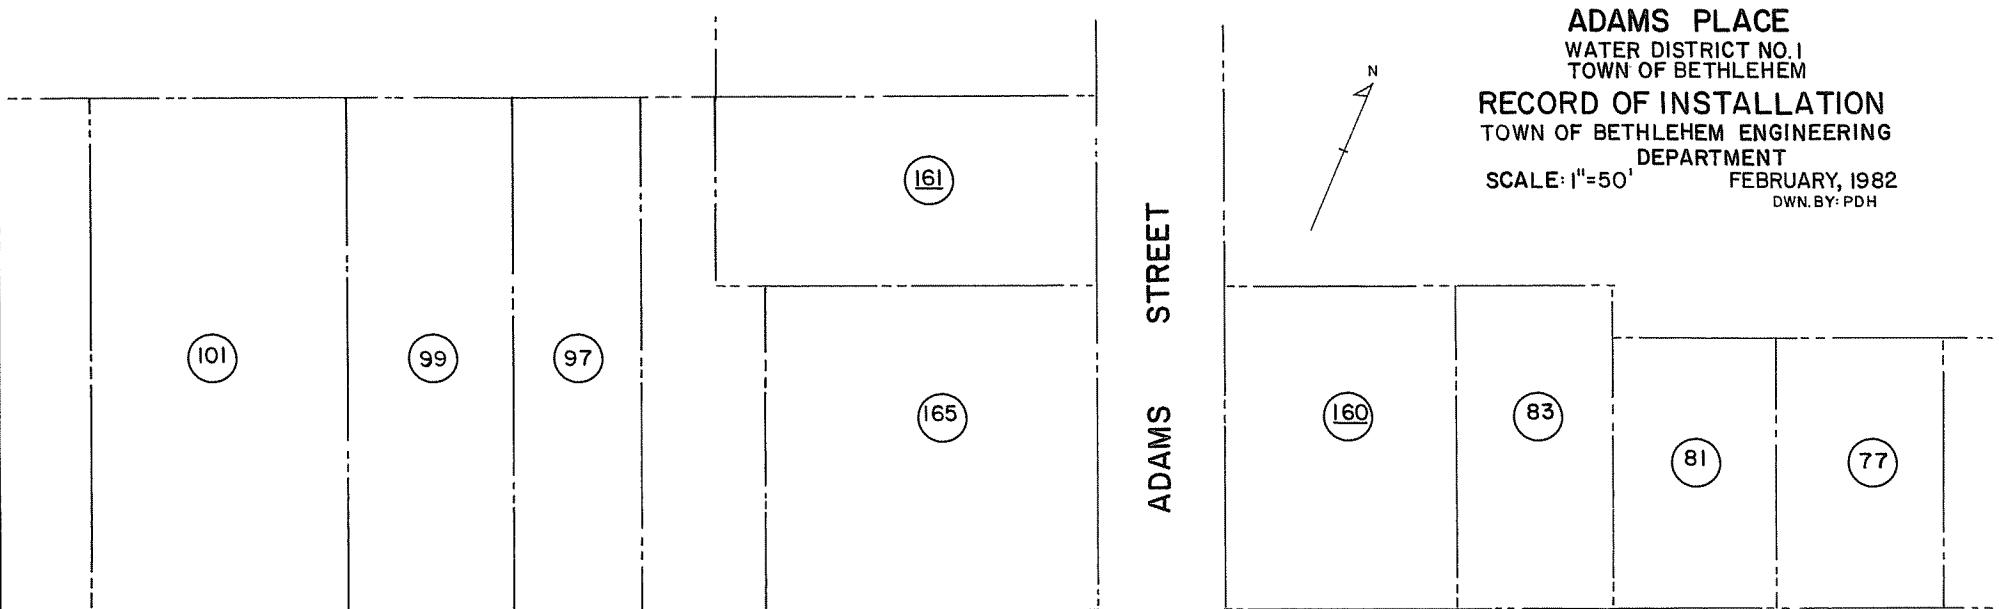

ADAMS

PLACE

