


ADAMS PLACE  
WATER DISTRICT NO. 1  
TOWN OF BETHLEHEM

**RECORD OF INSTALLATION  
TOWN OF BETHLEHEM ENGINEERING  
DEPARTMENT**

SCALE: 1"=50' FEBRUARY, 1982  
DWN. BY: PDH

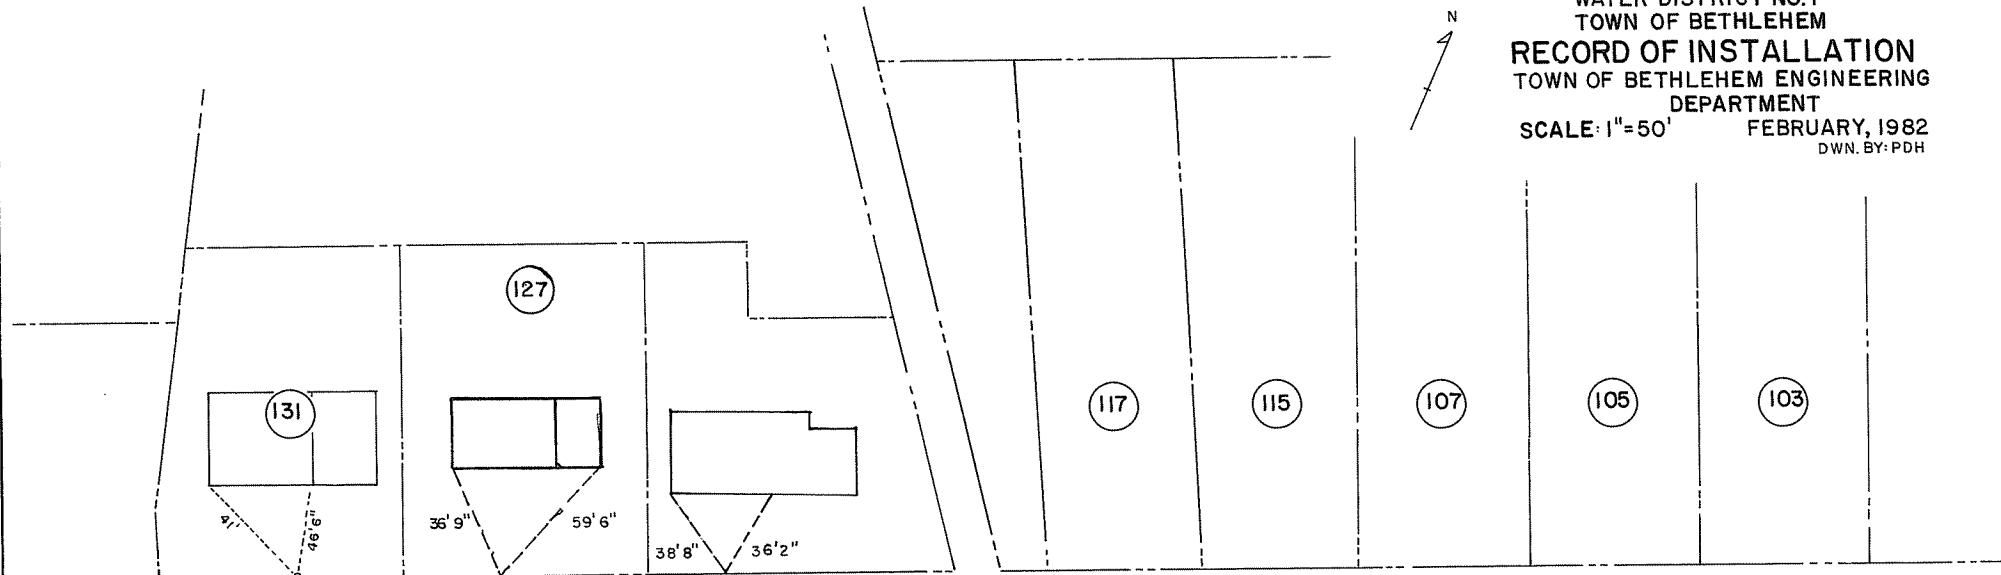

ADAMS

**PLACE**

