


ADAMS PLACE
WATER DISTRICT NO.1
TOWN OF BETHLEHEM

RECORD OF INSTALLATION
TOWN OF BETHLEHEM ENGINEERING

DEPARTMENT


SCALE: 1"=50' FEBRUARY, 1982
DWN. BY: PDH

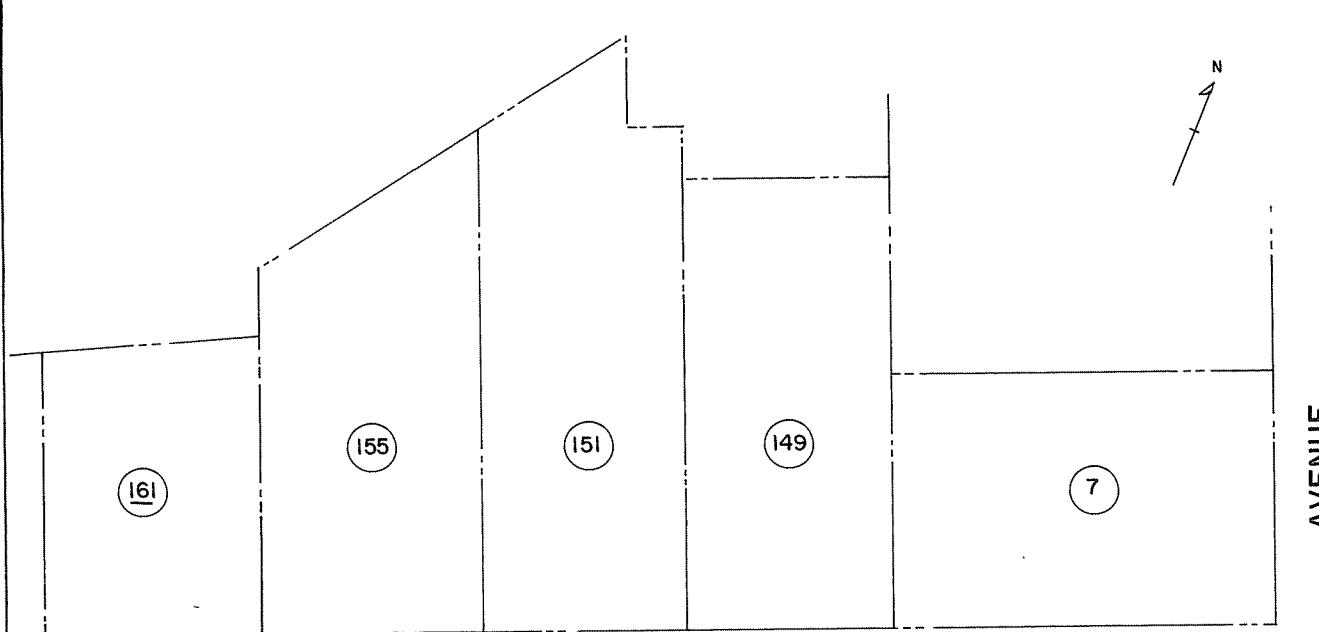


ADAMS

PLACE


AVENUE

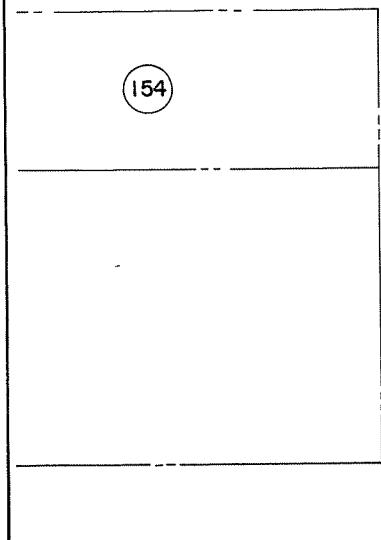

FOREST ROAD

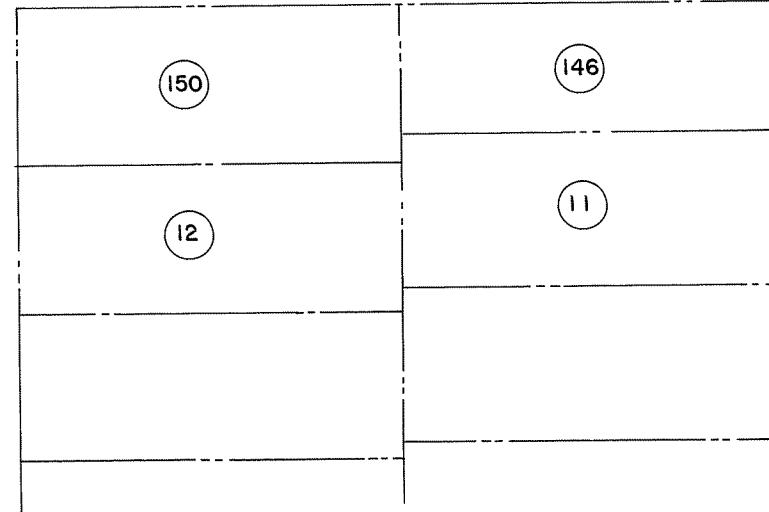

ROWELAND

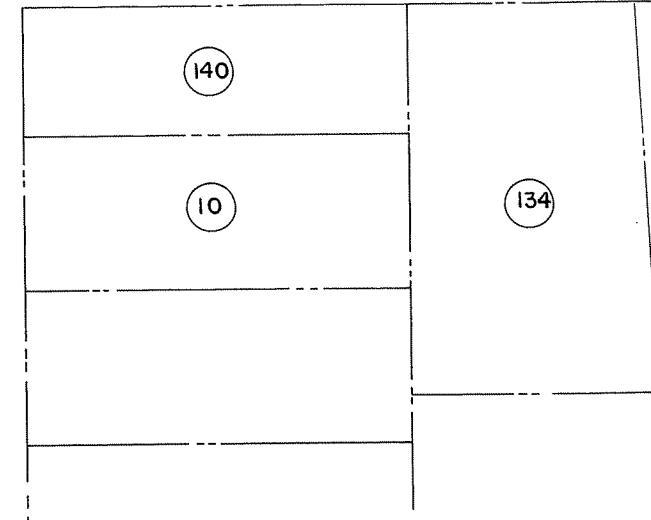

6