



ADAMS STREET  
WATER DISTRICT NO. I  
TOWN OF BETHLEHEM  
RECORD OF INSTALLATION  
TOWN OF BETHLEHEM ENGINEERING  
DEPARTMENT  
SCALE: 1"=50' JANUARY, 1982  
DWN. BY: PDH

ADAMS ST.

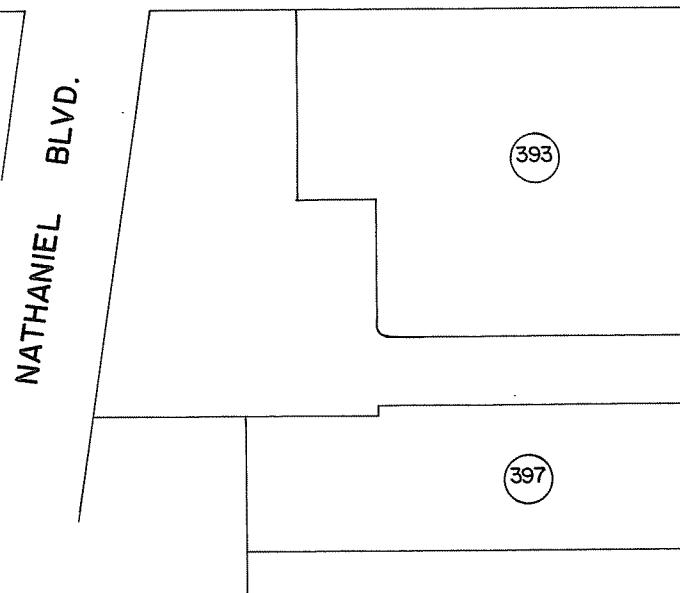

AVENUE

ADAMS STREET

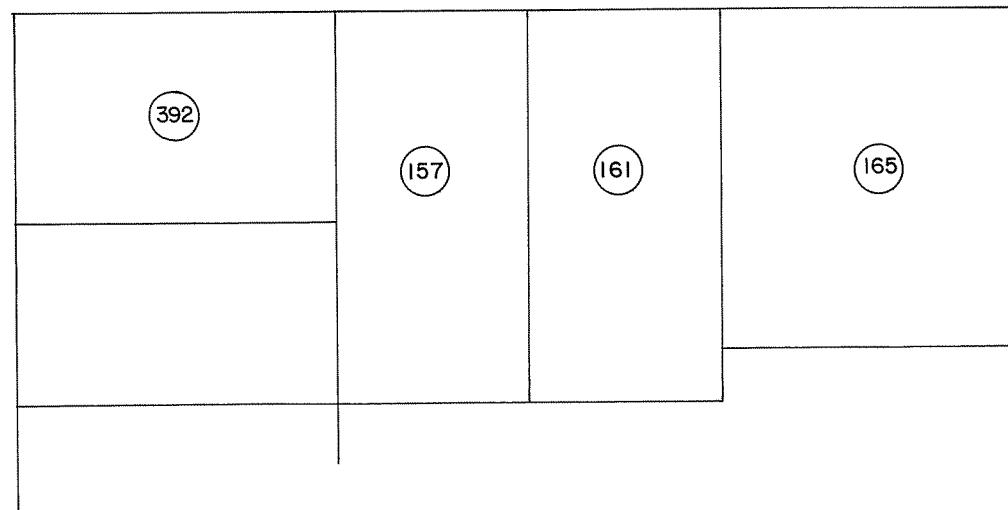

PLACE