


ADAMS STREET
WATER DISTRICT NO.1
TOWN OF BETHLEHEM

RECORD OF INSTALLATION
TOWN OF BETHLEHEM ENGINEERING
DEPARTMENT

SCALE: 1" = 50'

JANUARY, 1982
DWN. BY: PDH

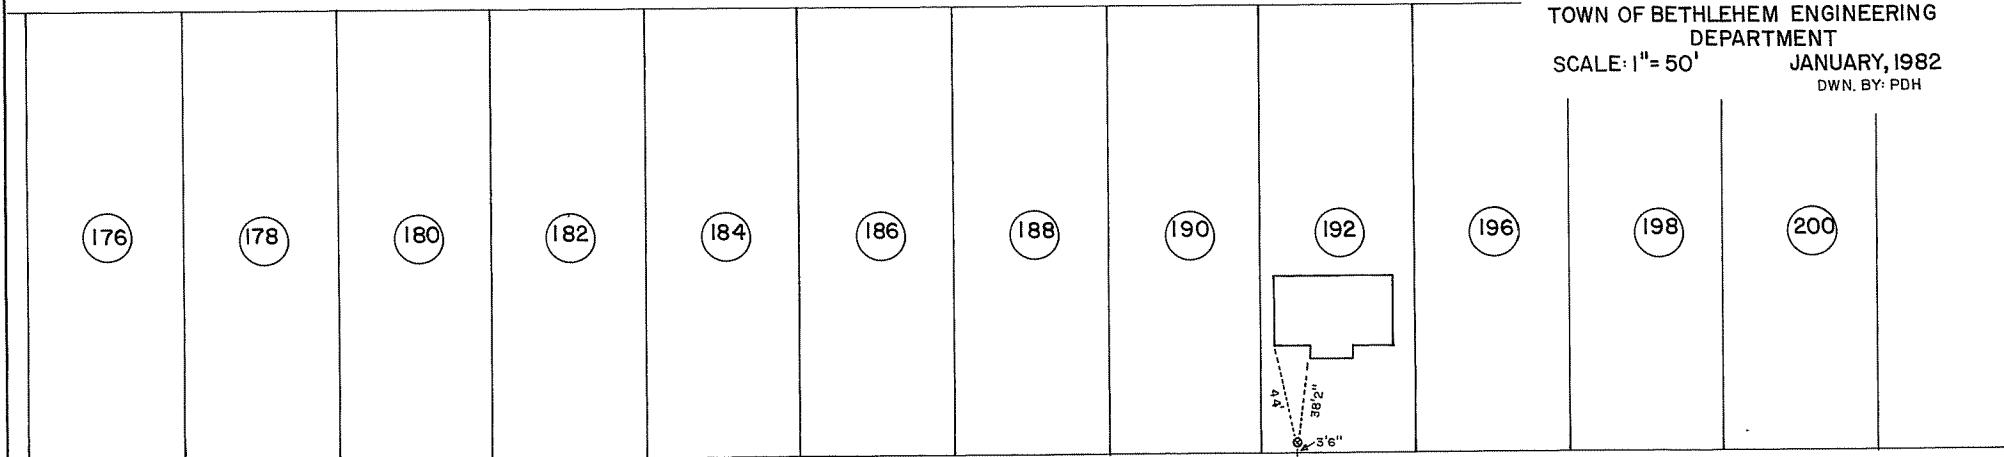

ADAMS

STREET

