



ADAMS STREET
WATER DISTRICT NO. 1
TOWN OF BETHLEHEM

RECORD OF INSTALLATION
TOWN OF BETHLEHEM ENGINEERING
DEPARTMENT
SCALE: 1"=50' JANUARY, 1982
DWN. BY: PDH

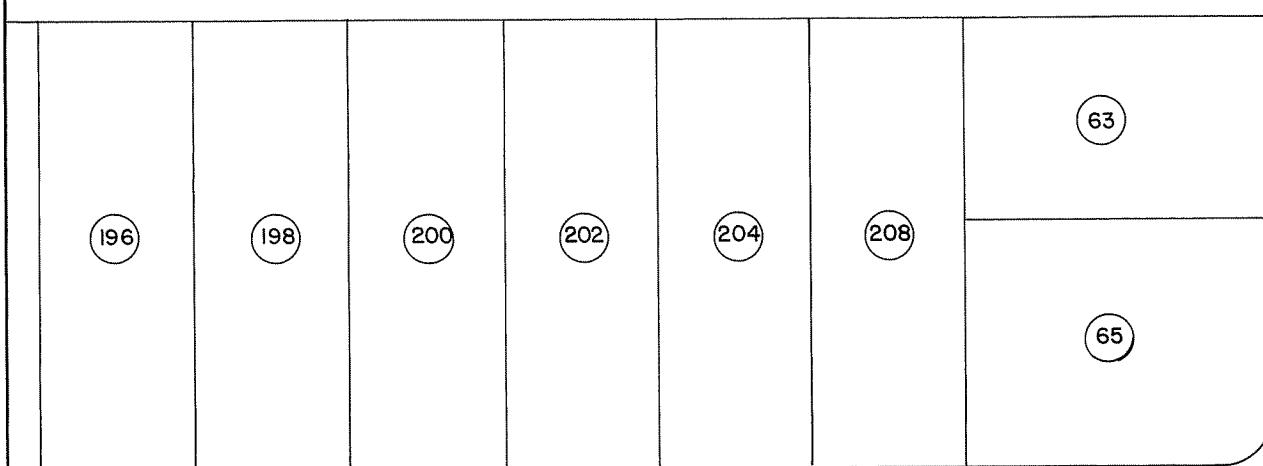

ADAMS STREET

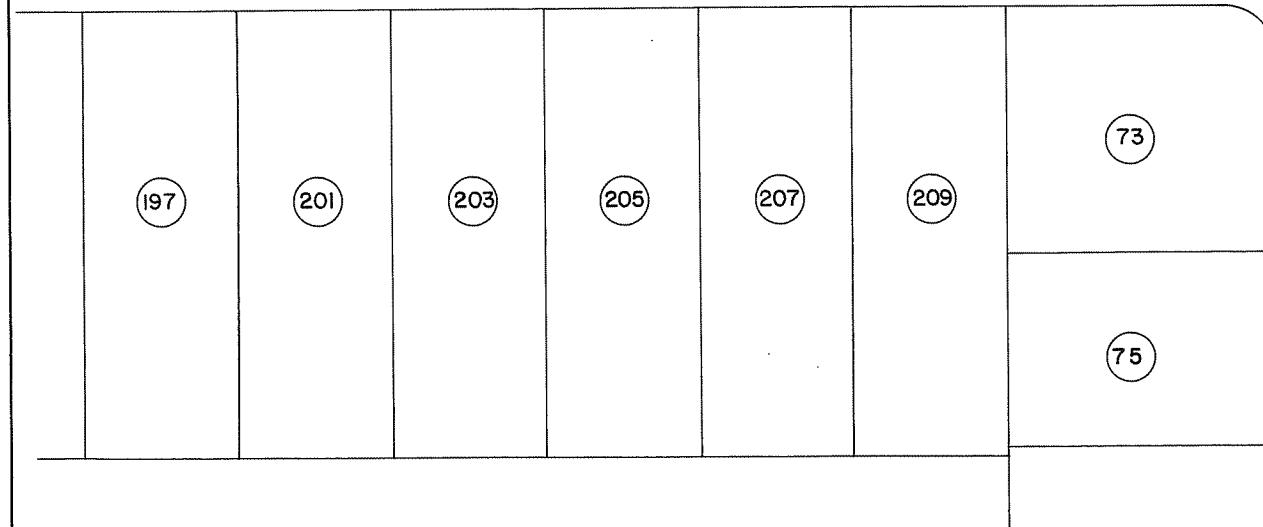

DELMAR

