


ALBIN ROAD
WATER DISTRICT NO. 1
TOWN OF BETHLEHEM
RECORD OF INSTALLATION
TOWN OF BETHLEHEM ENGINEERING
DEPARTMENT
SCALE: 1"=50' DECEMBER, 1982
DWN. BY: PDH


AVENUE

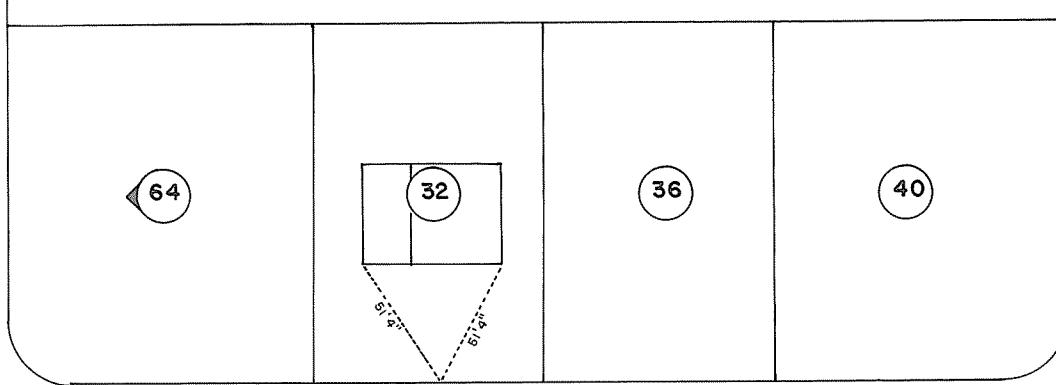

ALBIN

ROAD

WISCONSIN

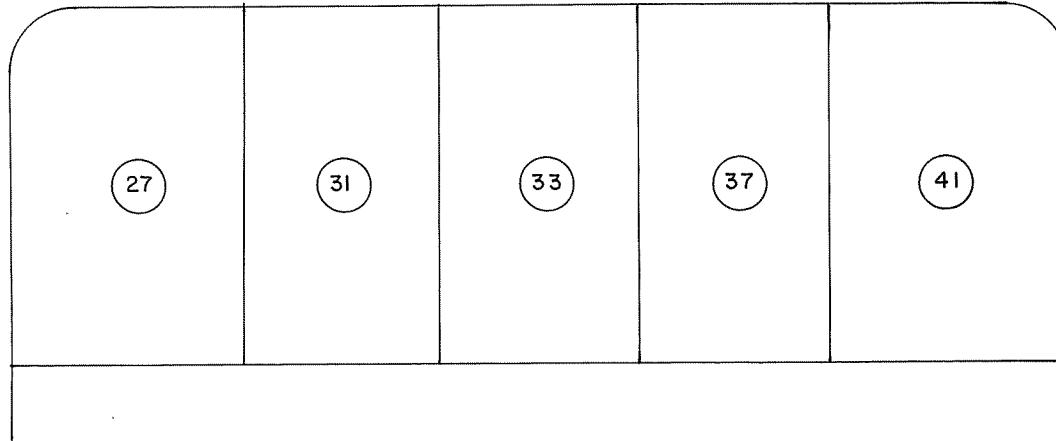

PARKWYN DRIVE

McGUFFEY LANE

BETHLEHEM CENTRAL SCHOOL
DISTRICT

4