


ALDEN COURT
WATER DISTRICT NO. 1
TOWN OF BETHLEHEM
RECORD OF INSTALLATION
TOWN OF BETHLEHEM ENGINEERING
DEPARTMENT
SCALE 1"=50' DECEMBER, 1981
DWN BY: PDH

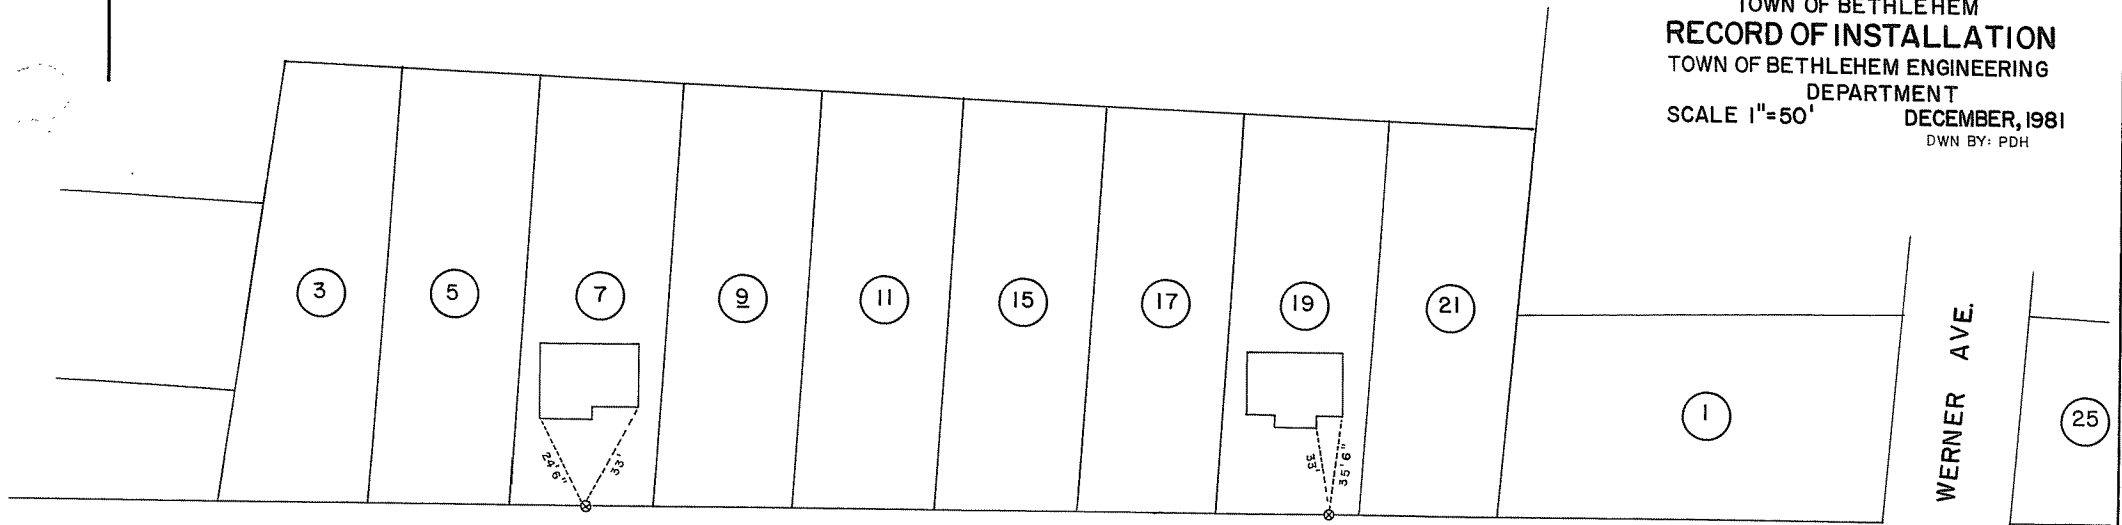

← KENWOOD AVE.

ALDEN

COURT

