

ALDEN COURT

WATER DISTRICT NO. I
TOWN OF BETHLEHEM

RECORD OF INSTALLATION




TOWN OF BETHLEHEM ENGINEERING

DEPARTMENT

SCALE 1"=50' DECEMBER, 1981



DWN BY: PDH

N

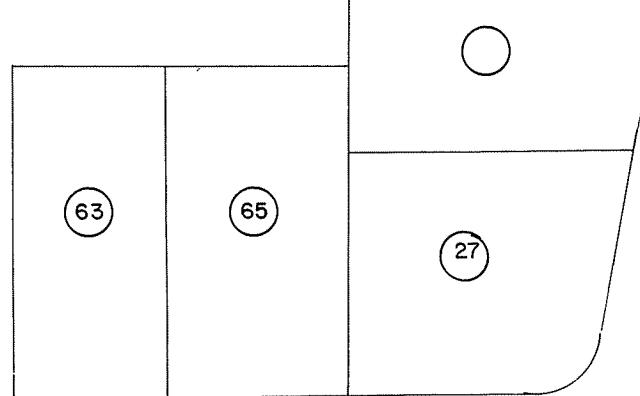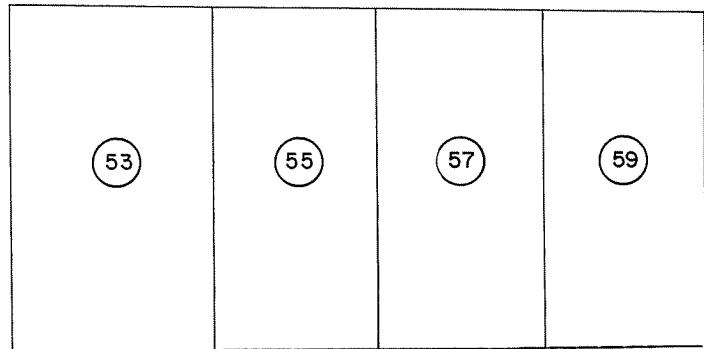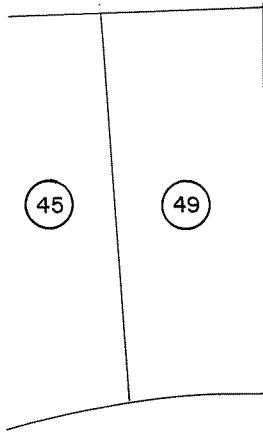

ALDEN

COURT

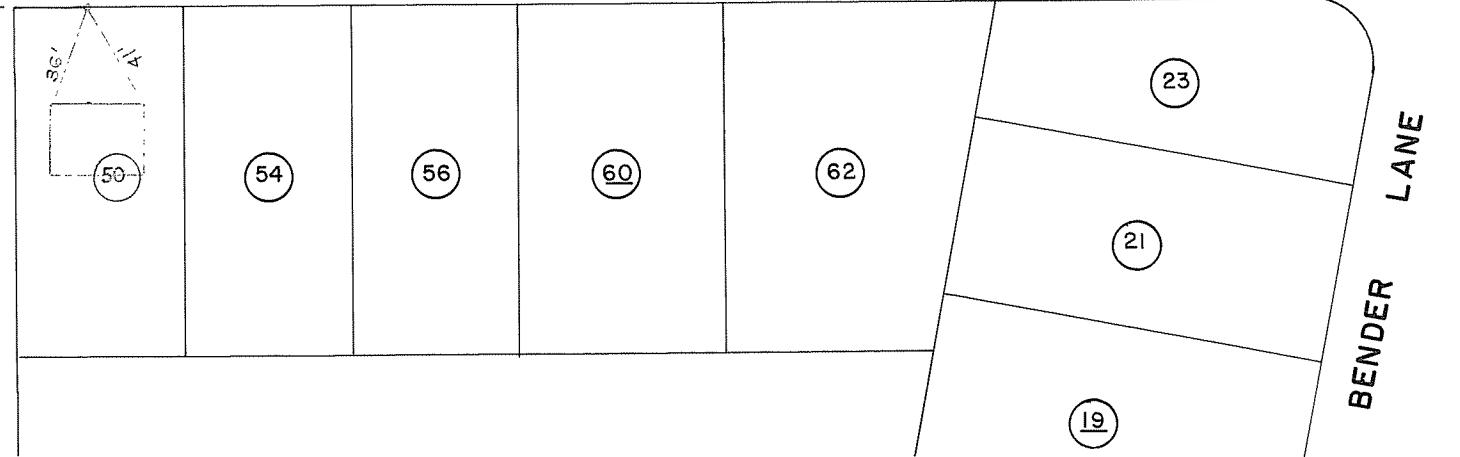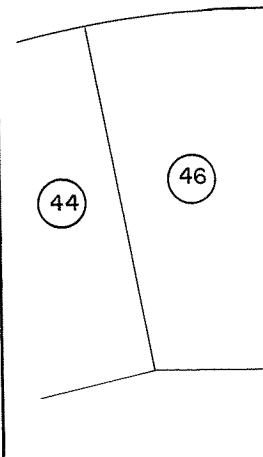

19