


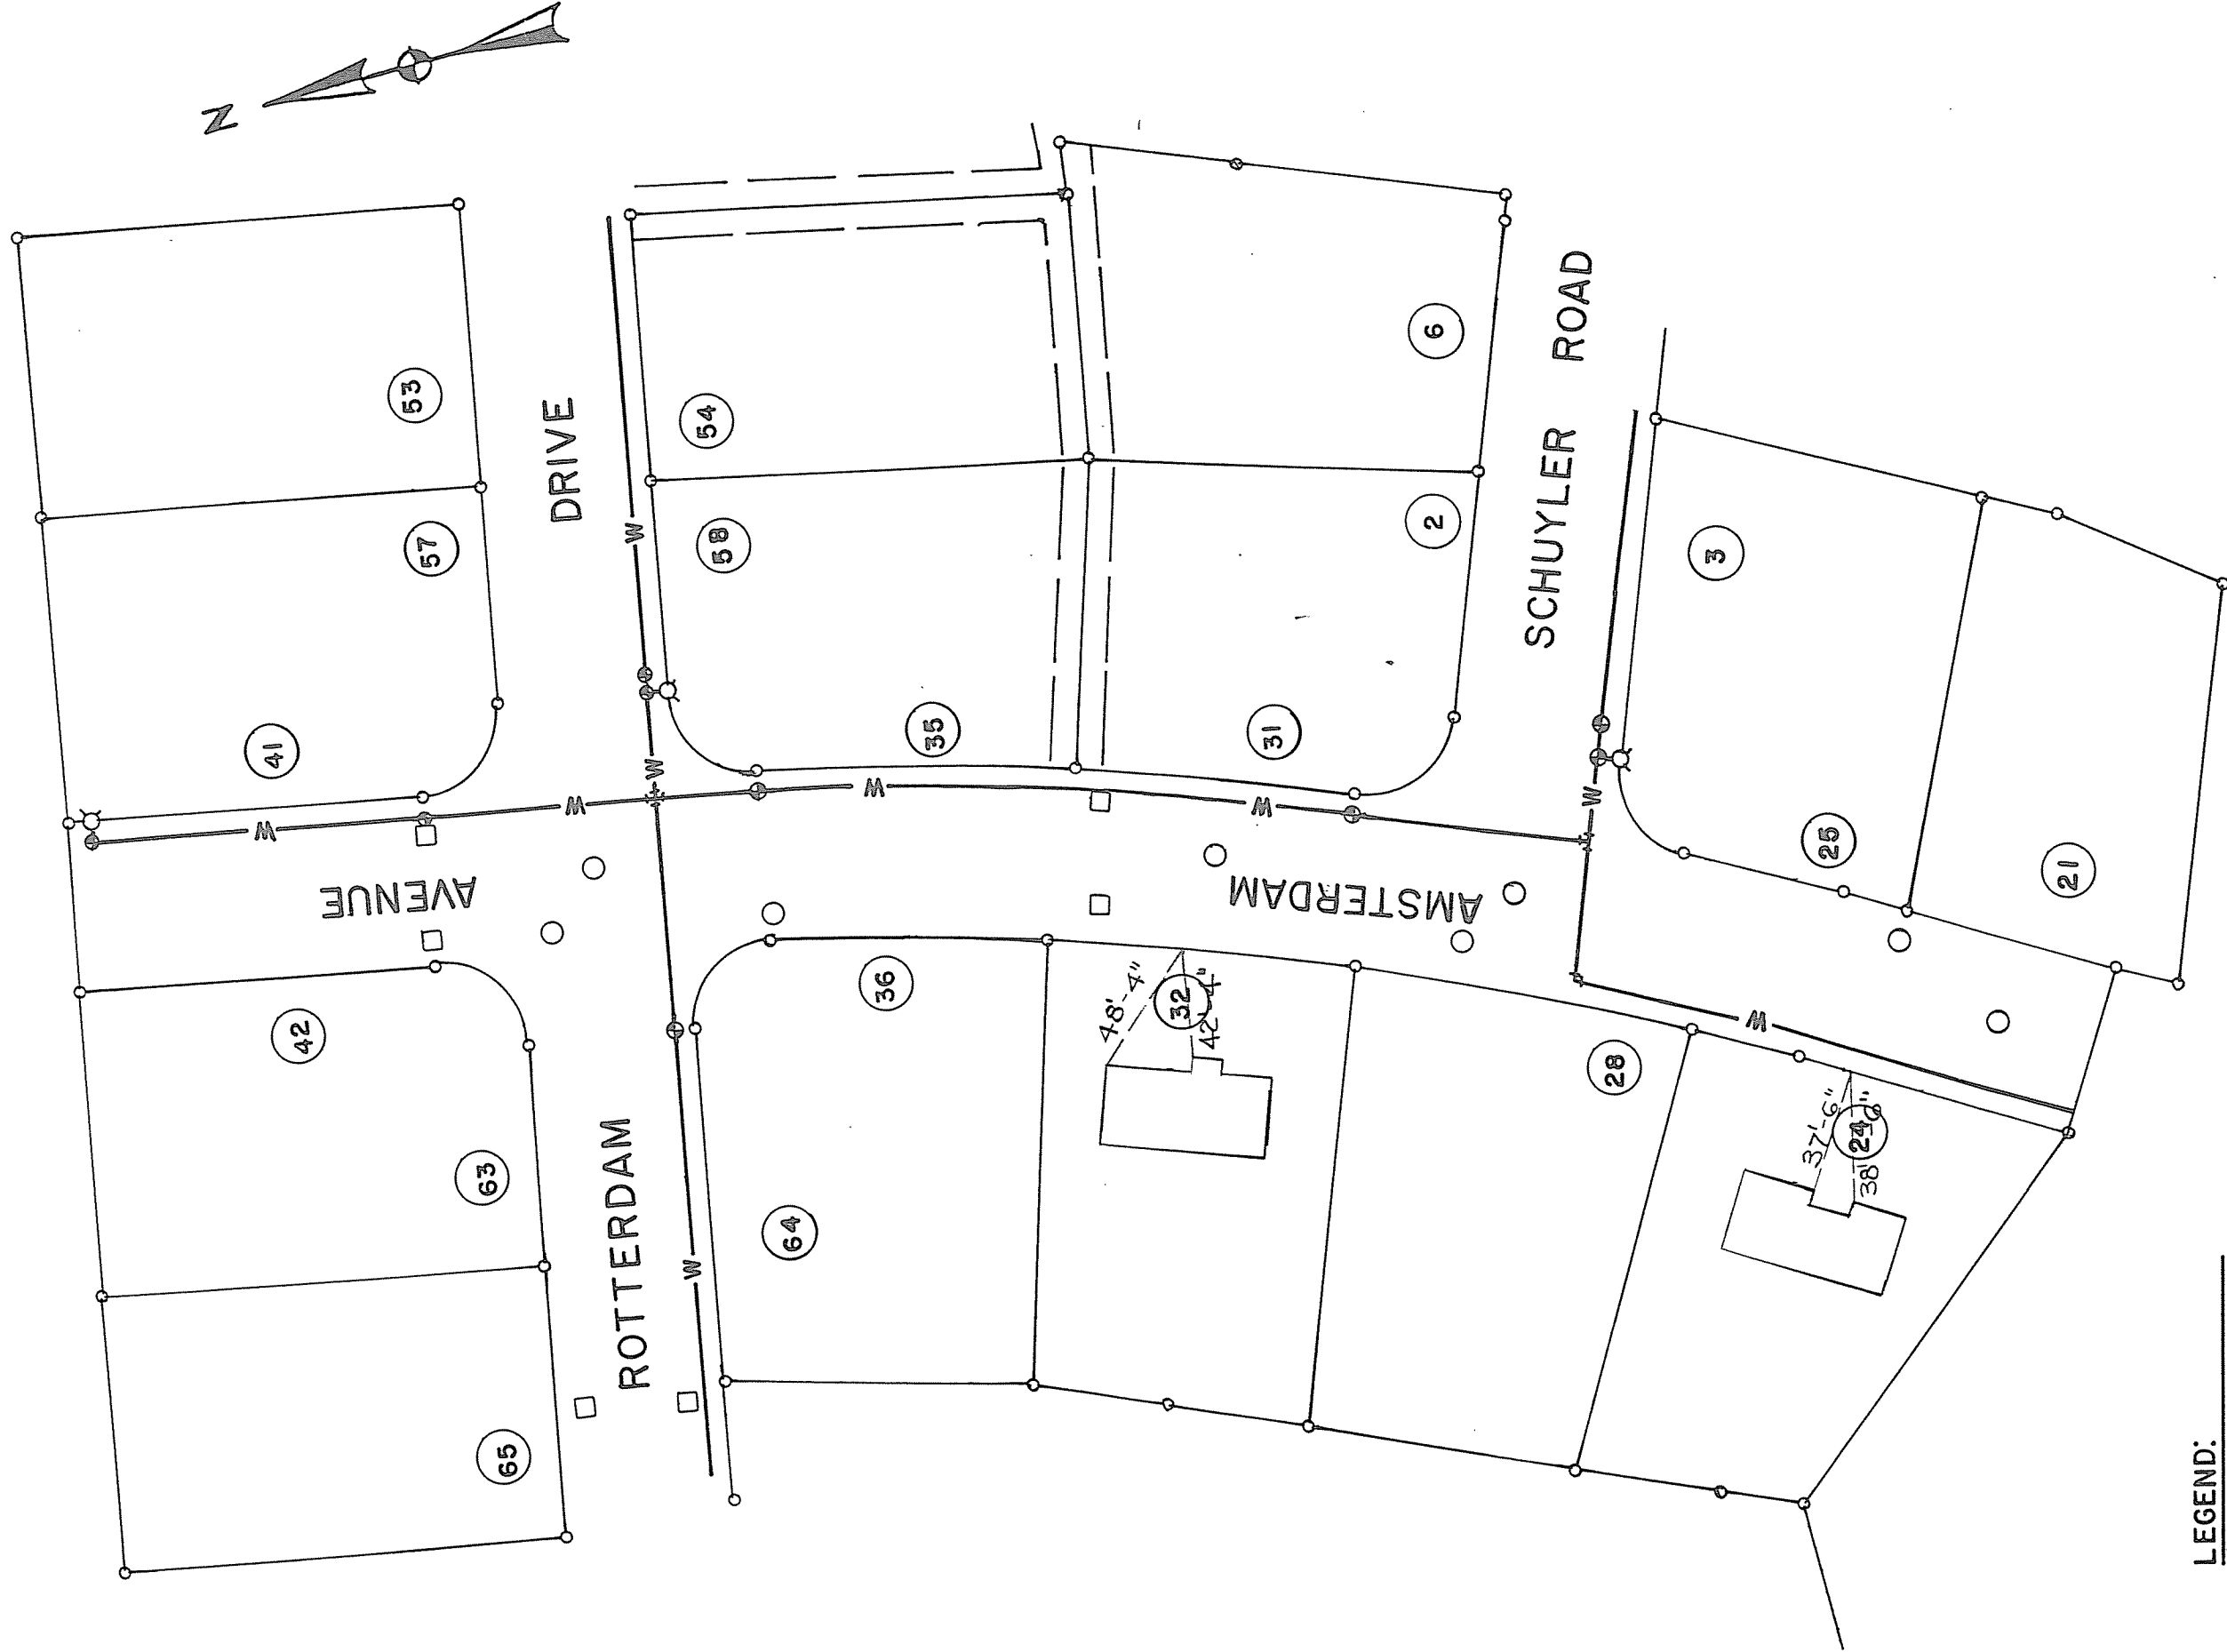

LEGEND:

8" D. W. L.P. WATER MAIN

- ⊕ VALVE
- ⊙ HYDRANT
- MANHOLE
- CATCH BASIN
- ⊥ ELBOW CONN.
- ⊥ TEE CONN.
- ⊥ CROSS CONN.
- ▲ THRUST BLOCK

AMSTERDAM DRIVE WATER MAIN

MAY 1994 RECORD
SCALE: 1" = 50' DRAWING
BY TRINITY CONSTRUCTION
DRAWN BY M.G.
CHECKED BY D.M.S.