


AXBRIDGE RD.
HUNTERSFIELD RD

NORTH

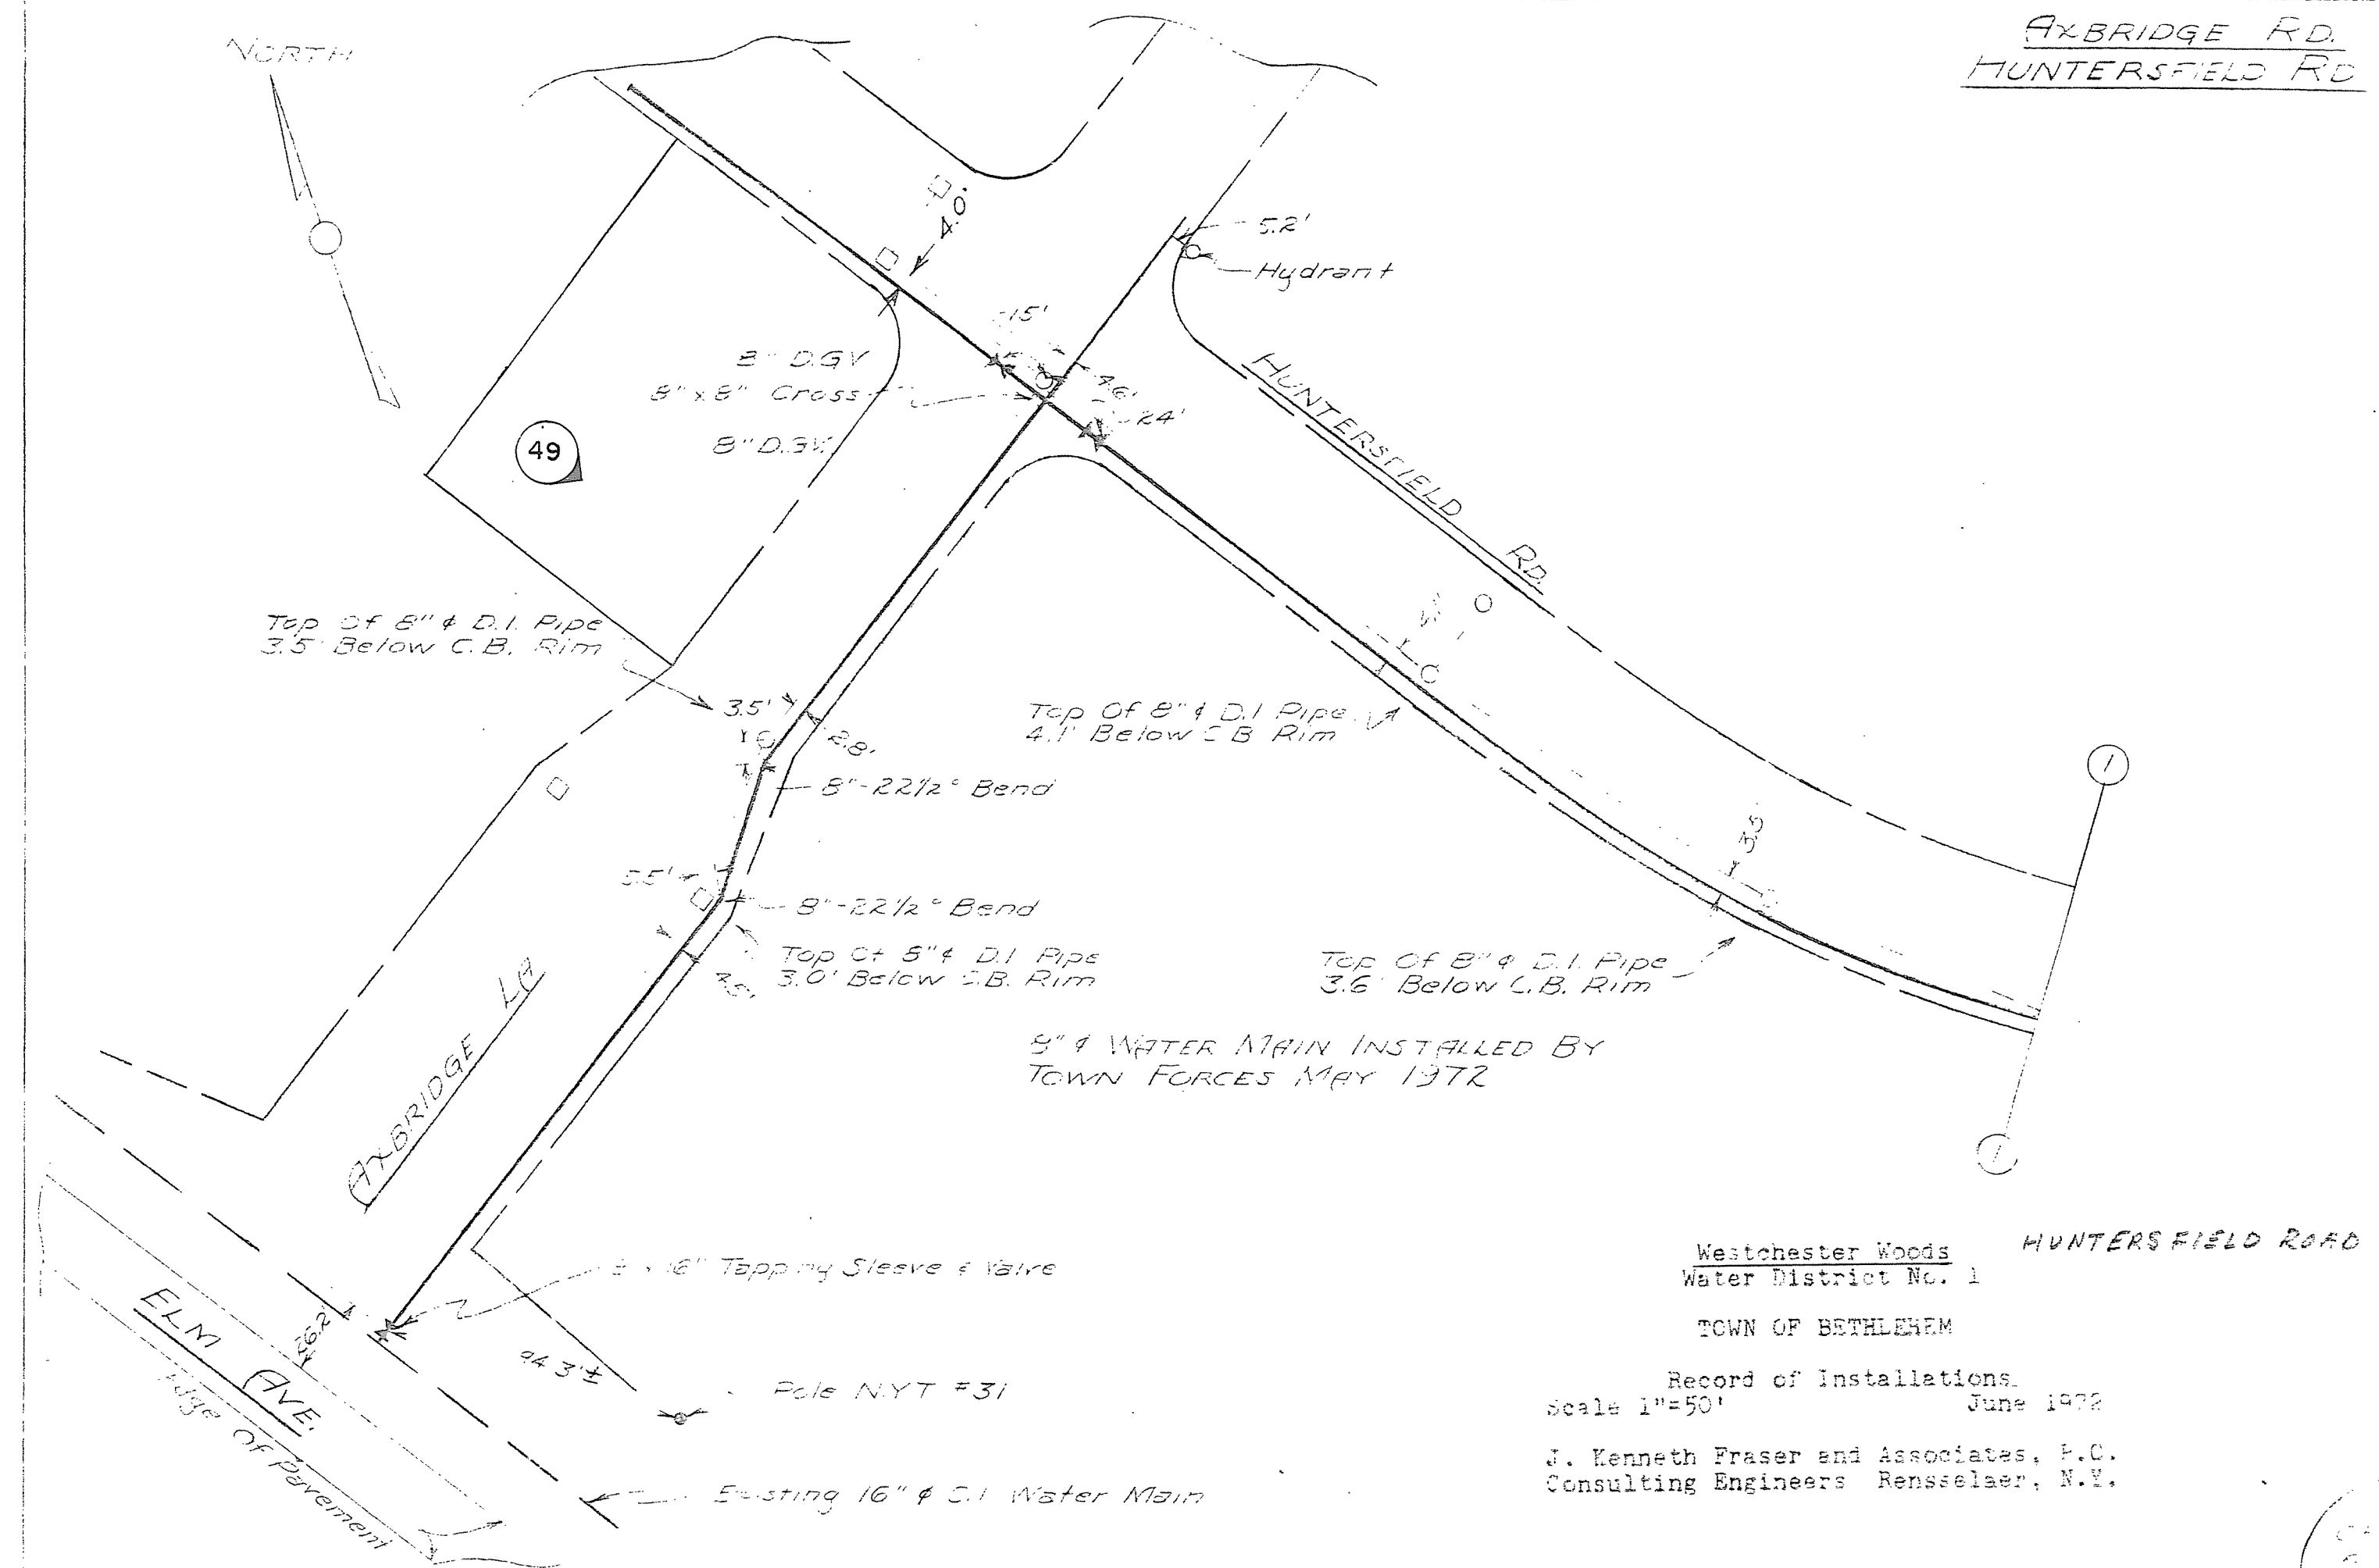

Westchester Woods
Water District No. 1

HUNTERSFIELD ROAD

TOWN OF BETHLEHEM

Record of Installations.
Scale 1"=50' June 1972

J. Kenneth Fraser and Associates, P.C.
Consulting Engineers Rensselaer, N.Y.