


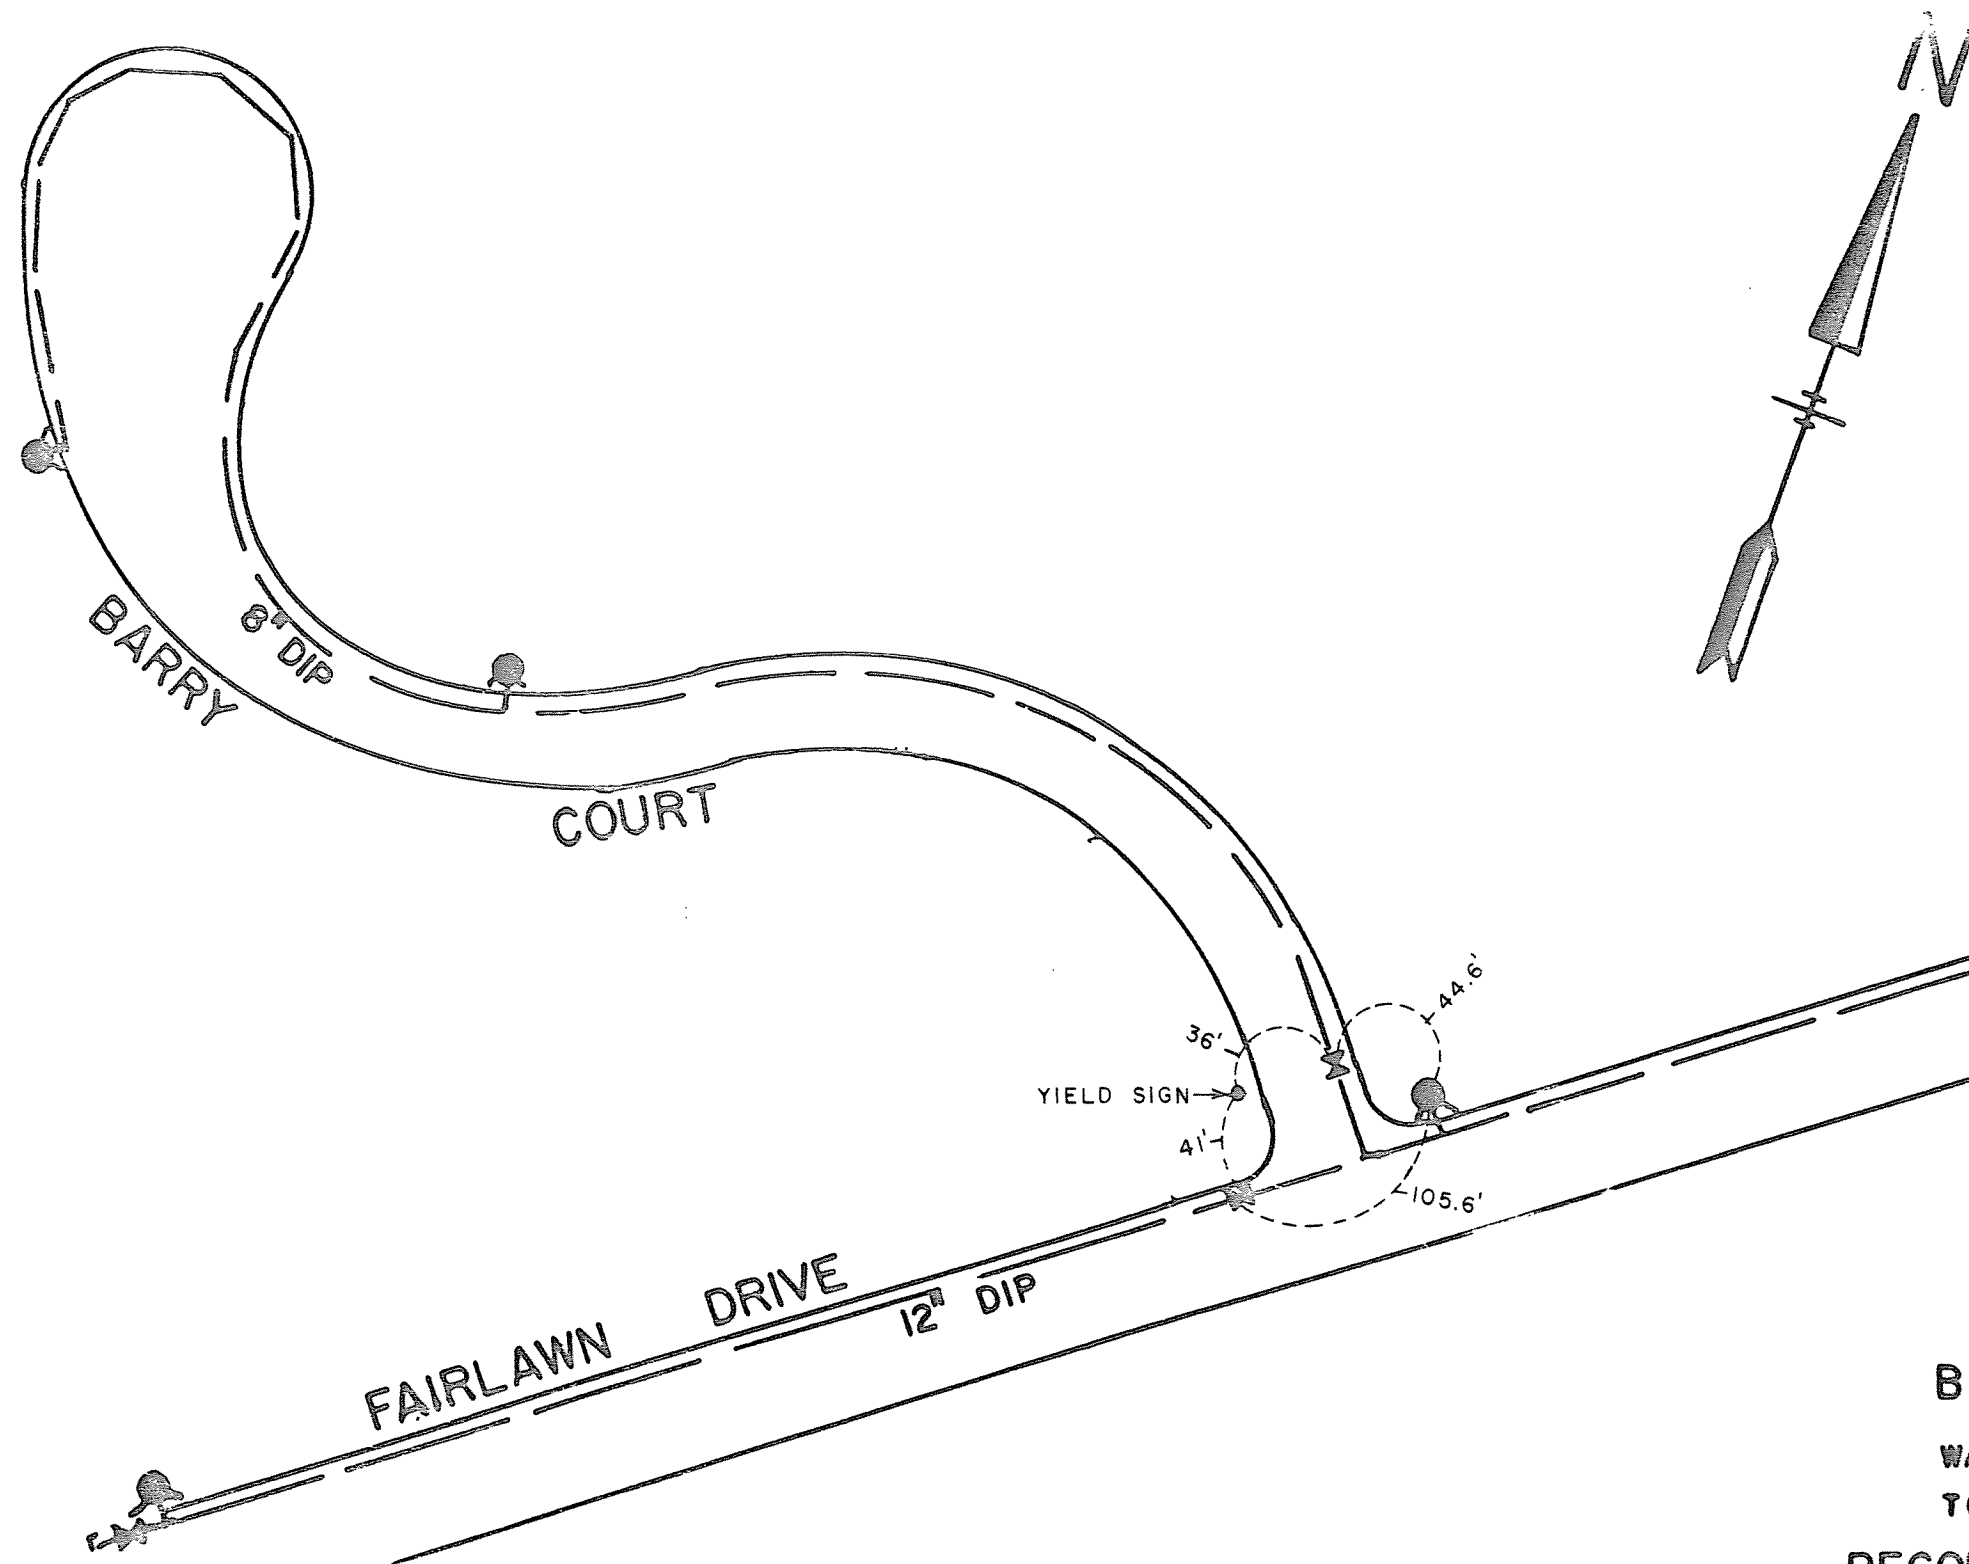

BARRY COURT

WATER DISTRICT NO.1

TOWN OF BETHLEHEM

RECORD OF INSTALLATION

TOWN OF BETHLEHEM ENGINEERING DEPT.

SCALE: 1" = 100'

SEPT, 1984

DWN. BY: JS