
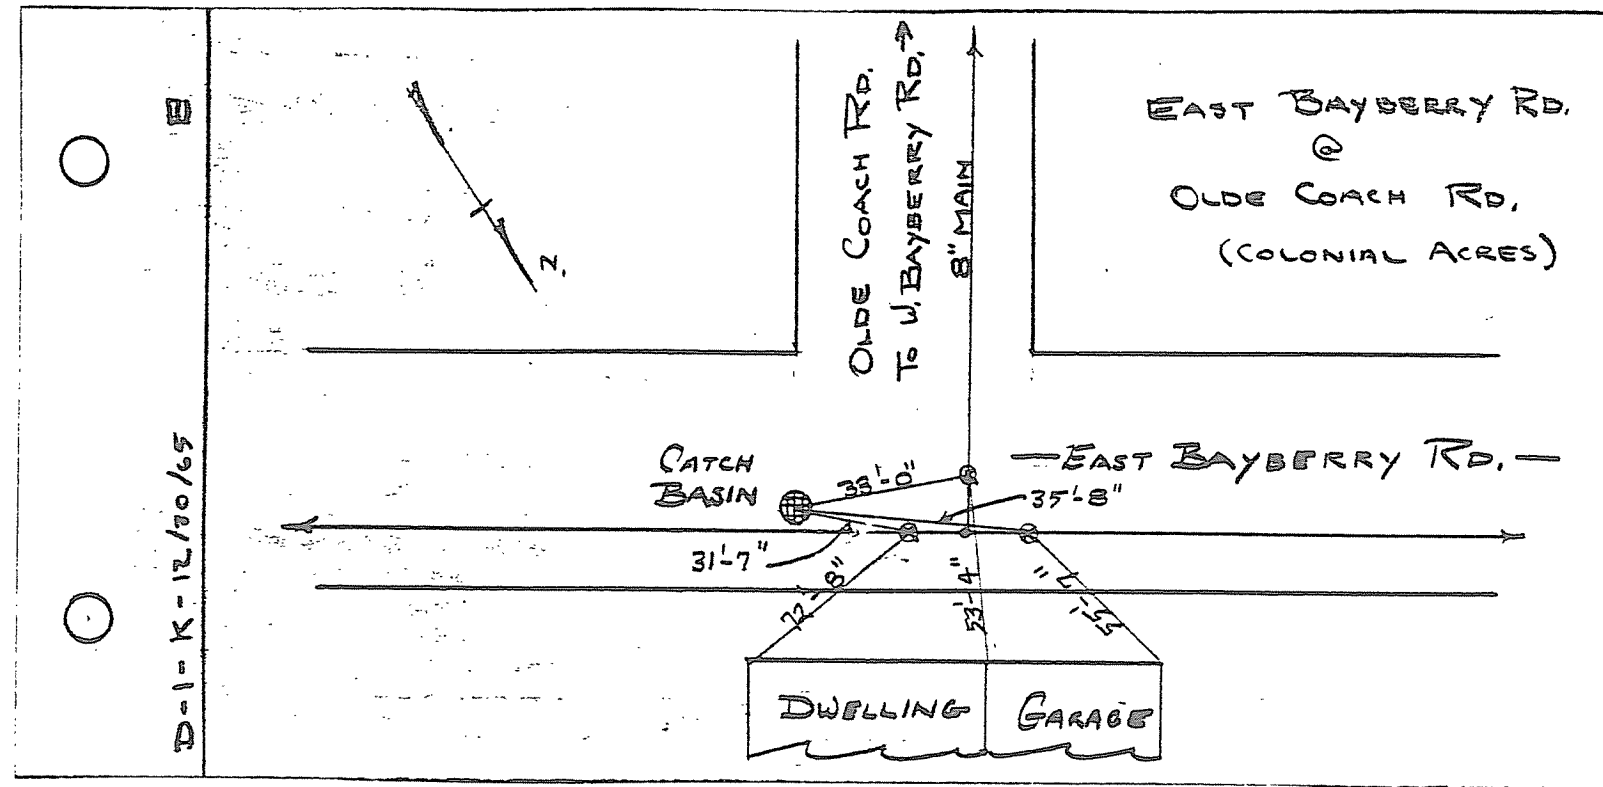


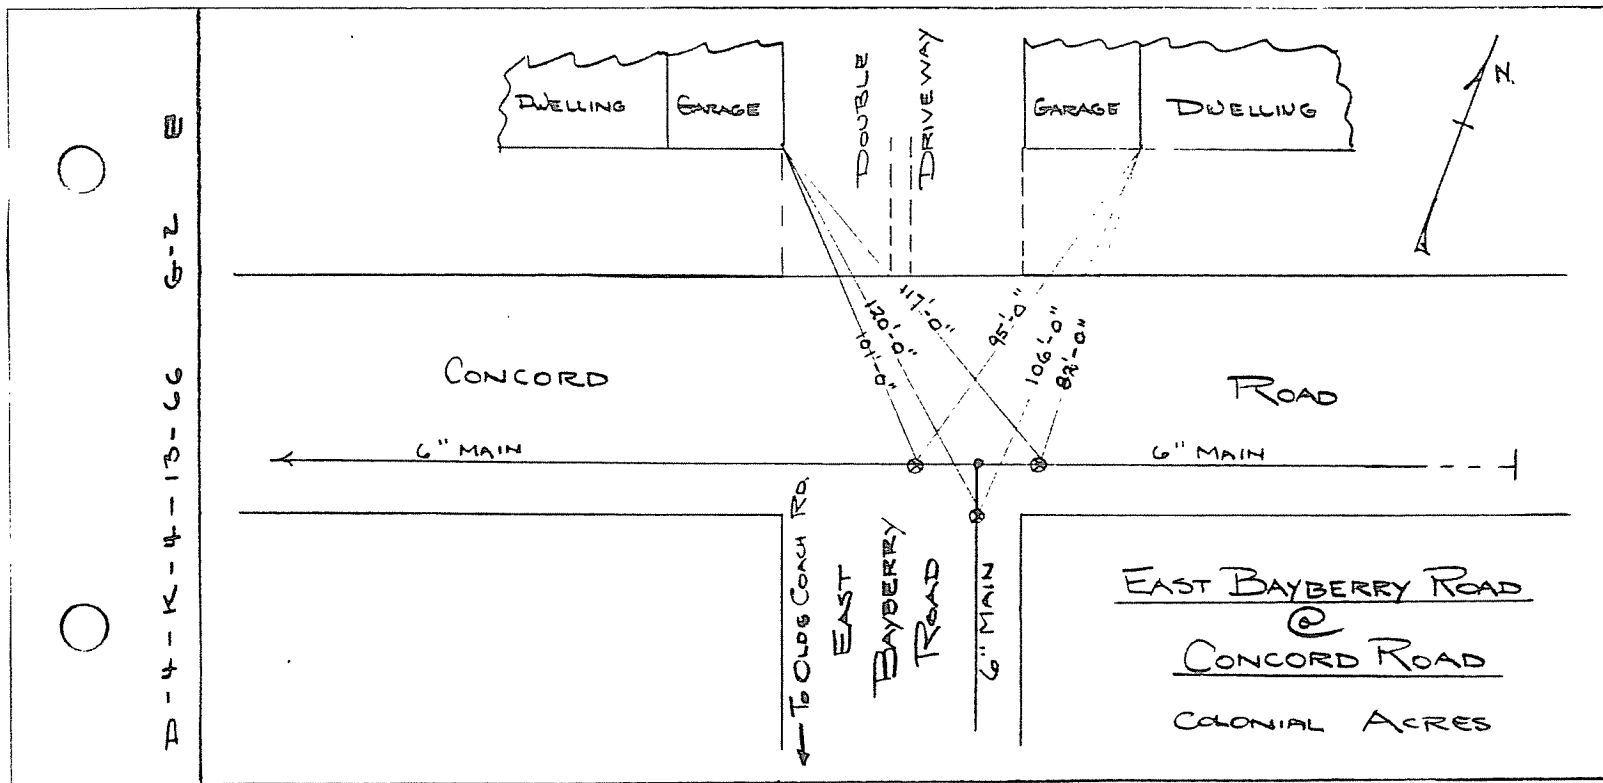

BAYBERRY ROAD-EAST
WATER MAIN