





West Bayberry Road @ Cambridge Drive

Colonial Acres

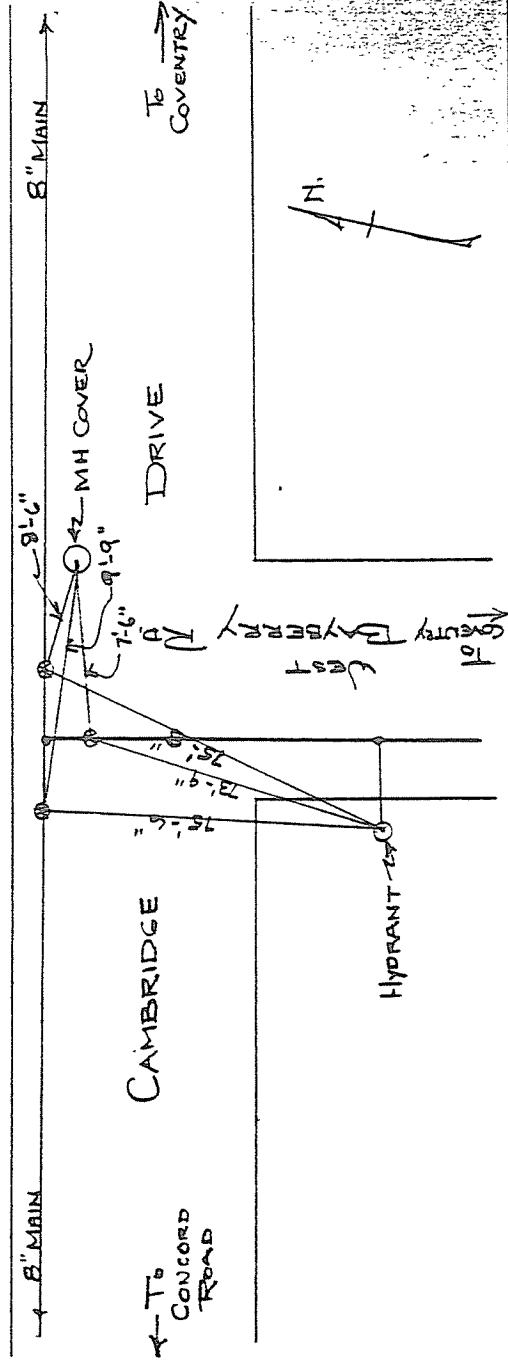

West Bayberry Road @ Coventry Road

Colonial Acres

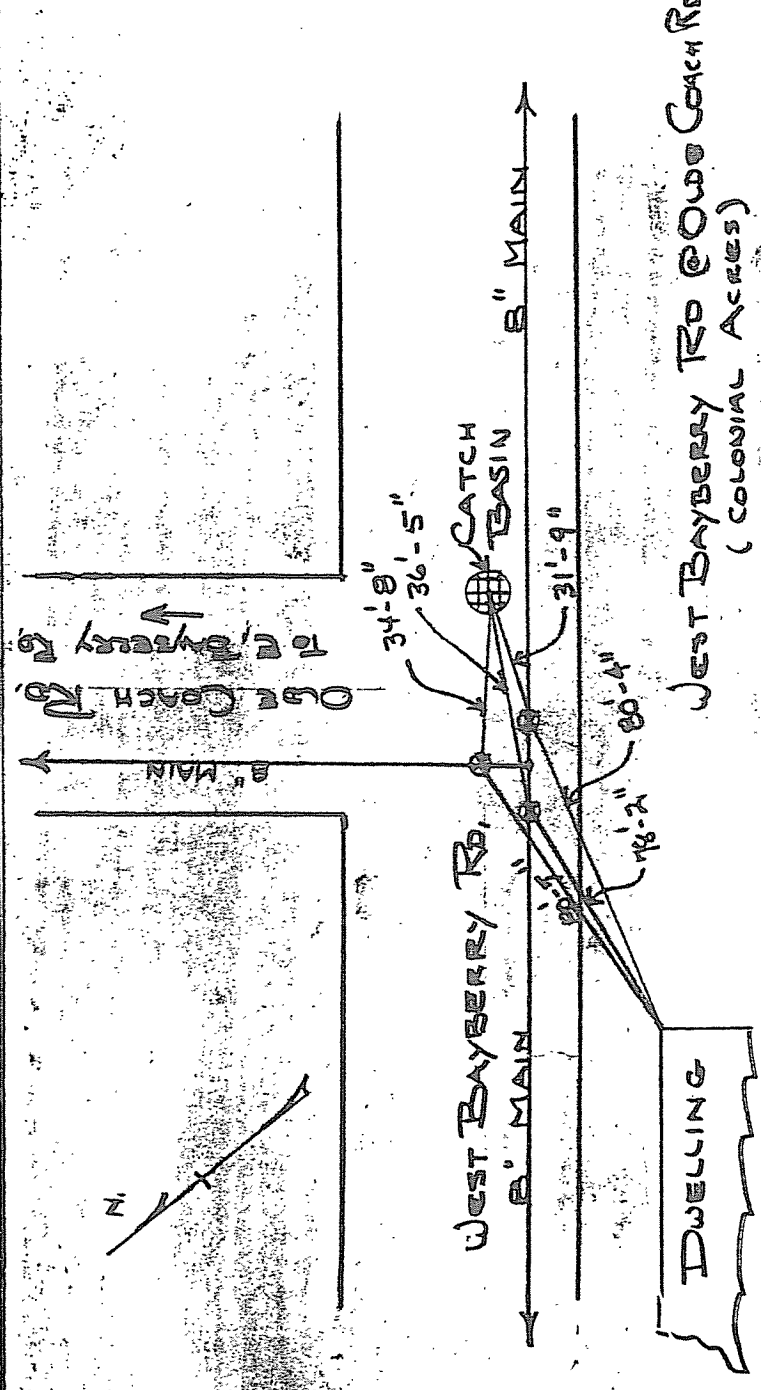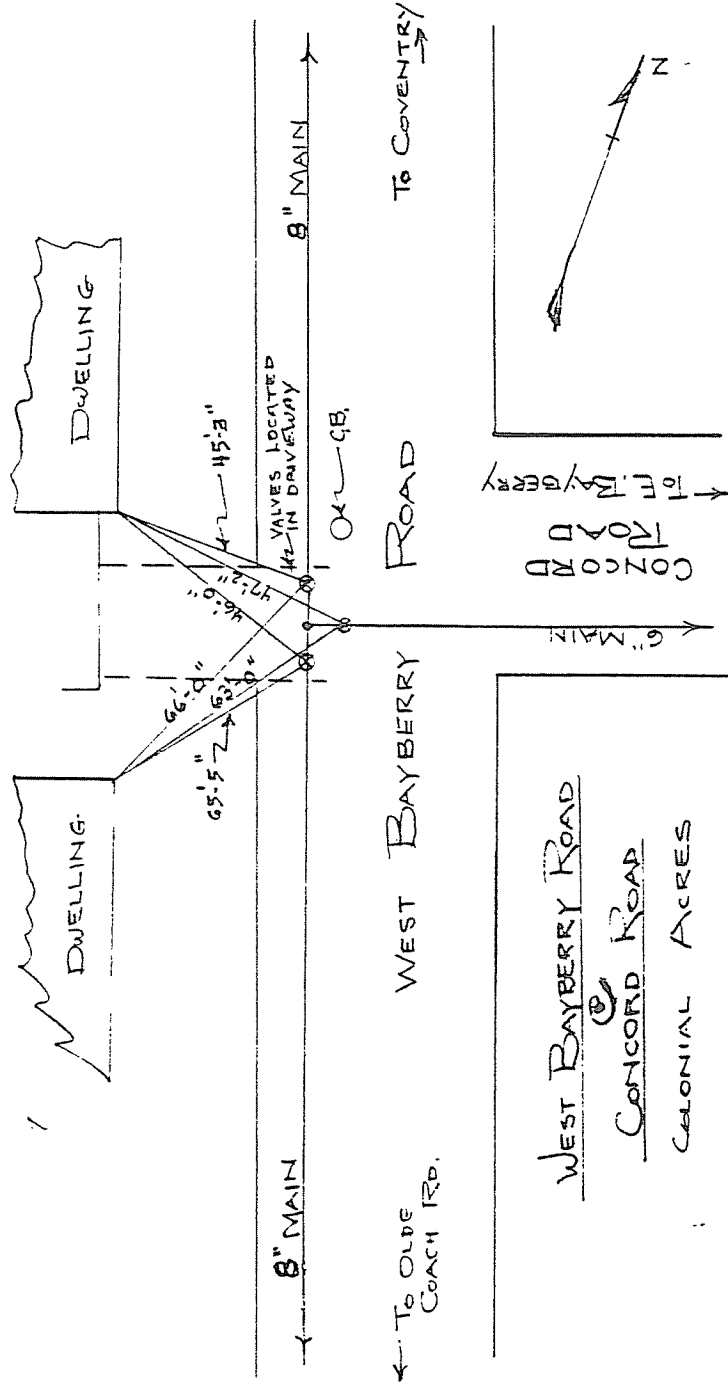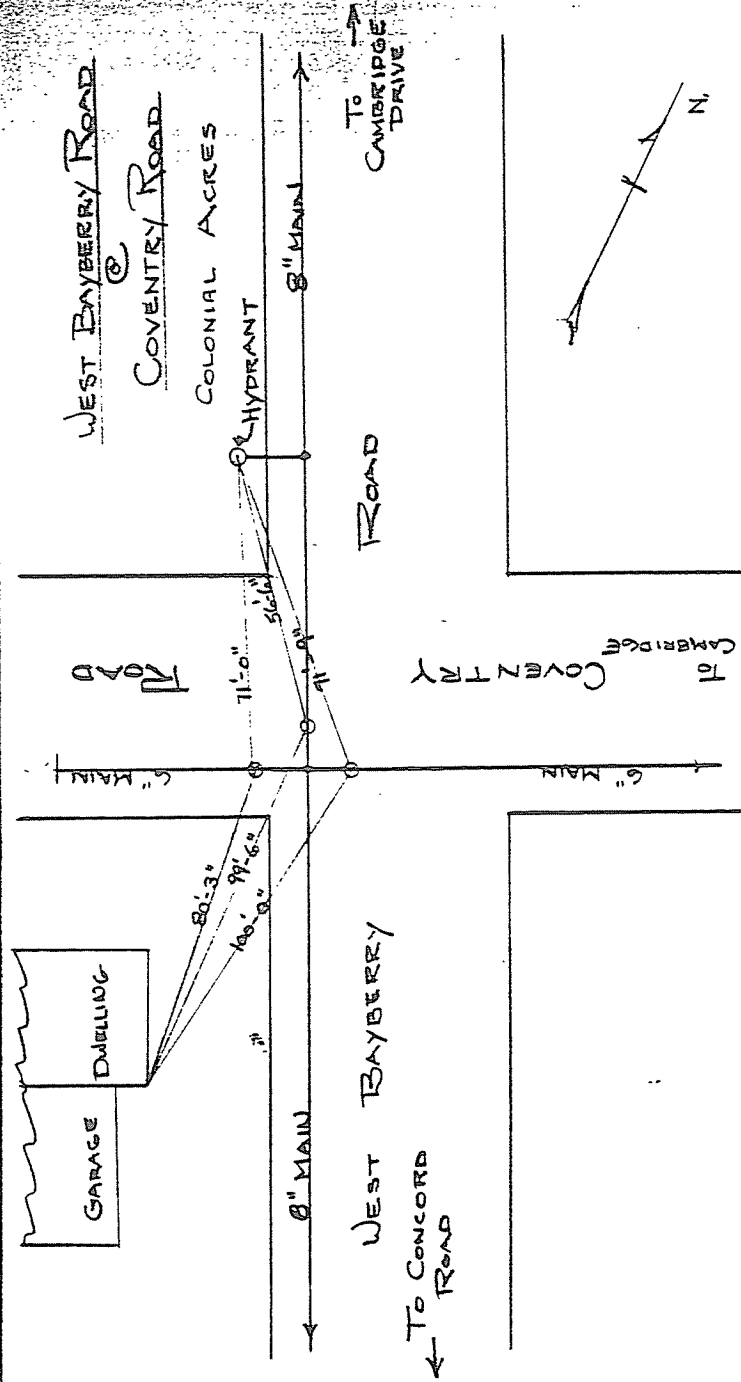

BAYBERRY ROAD - WEST

WATER MAIN