


BEACON ROAD
WATER DISTRICT NO. 1
TOWN OF BETHLEHEM
RECORD OF INSTALLATION
TOWN OF BETHLEHEM ENGINEERING
DEPARTMENT
SCALE: 1" = 50' DECEMBER, 1982
DWN. BY: PDH

N

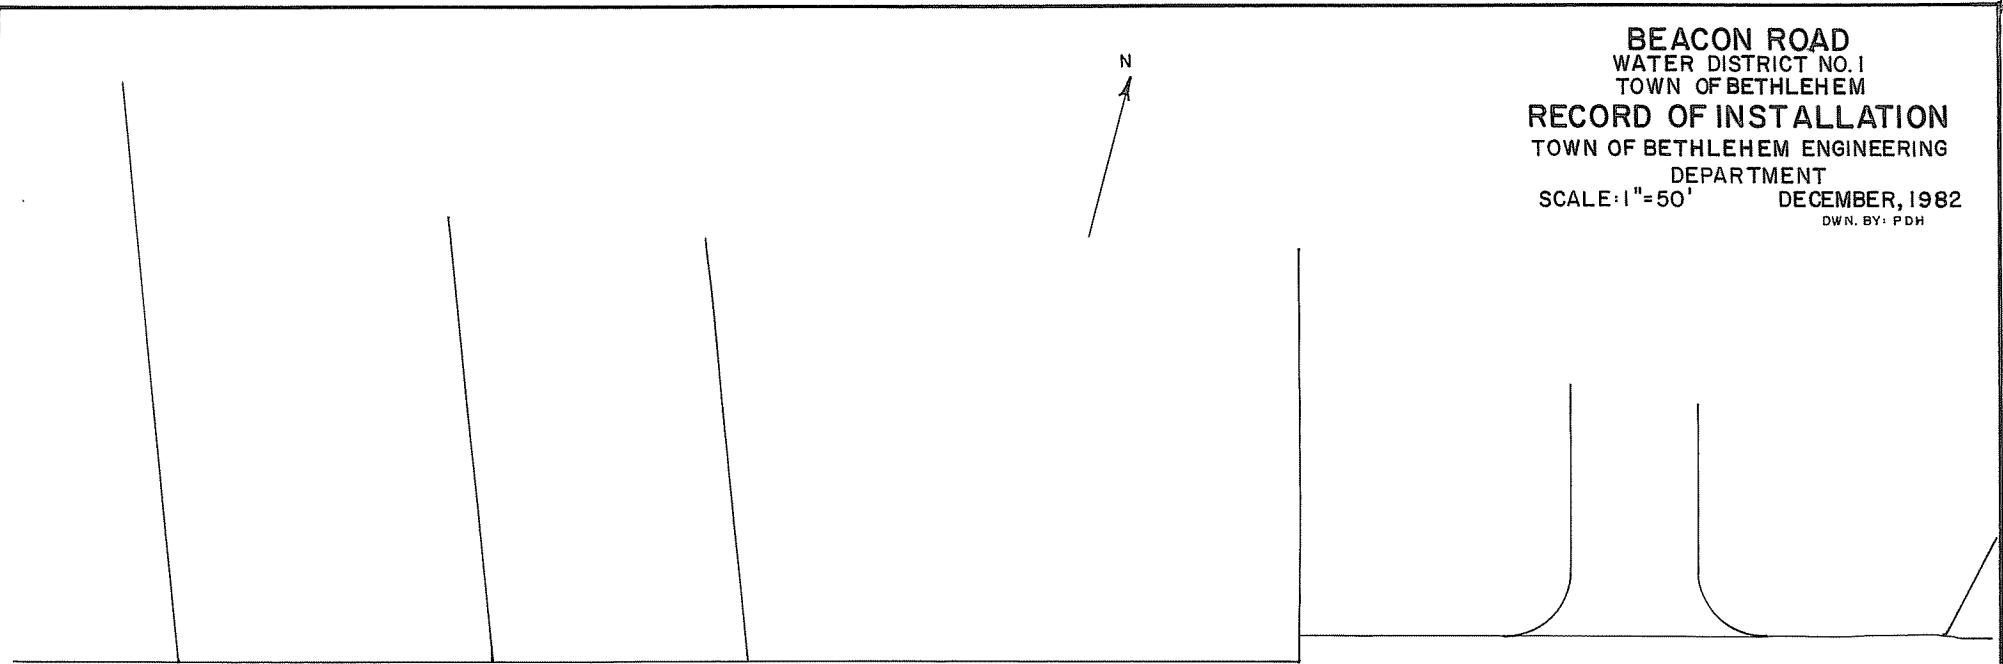

BEACON

ROAD

