


BEACON ROAD  
WATER DISTRICT NO. 1  
TOWN OF BETHLEHEM  
RECORD OF INSTALLATION  
TOWN OF BETHLEHEM ENGINEERING  
DEPARTMENT  
SCALE: 1"=50'  
DECEMBER, 1982  
DWN. BY: PDH

N

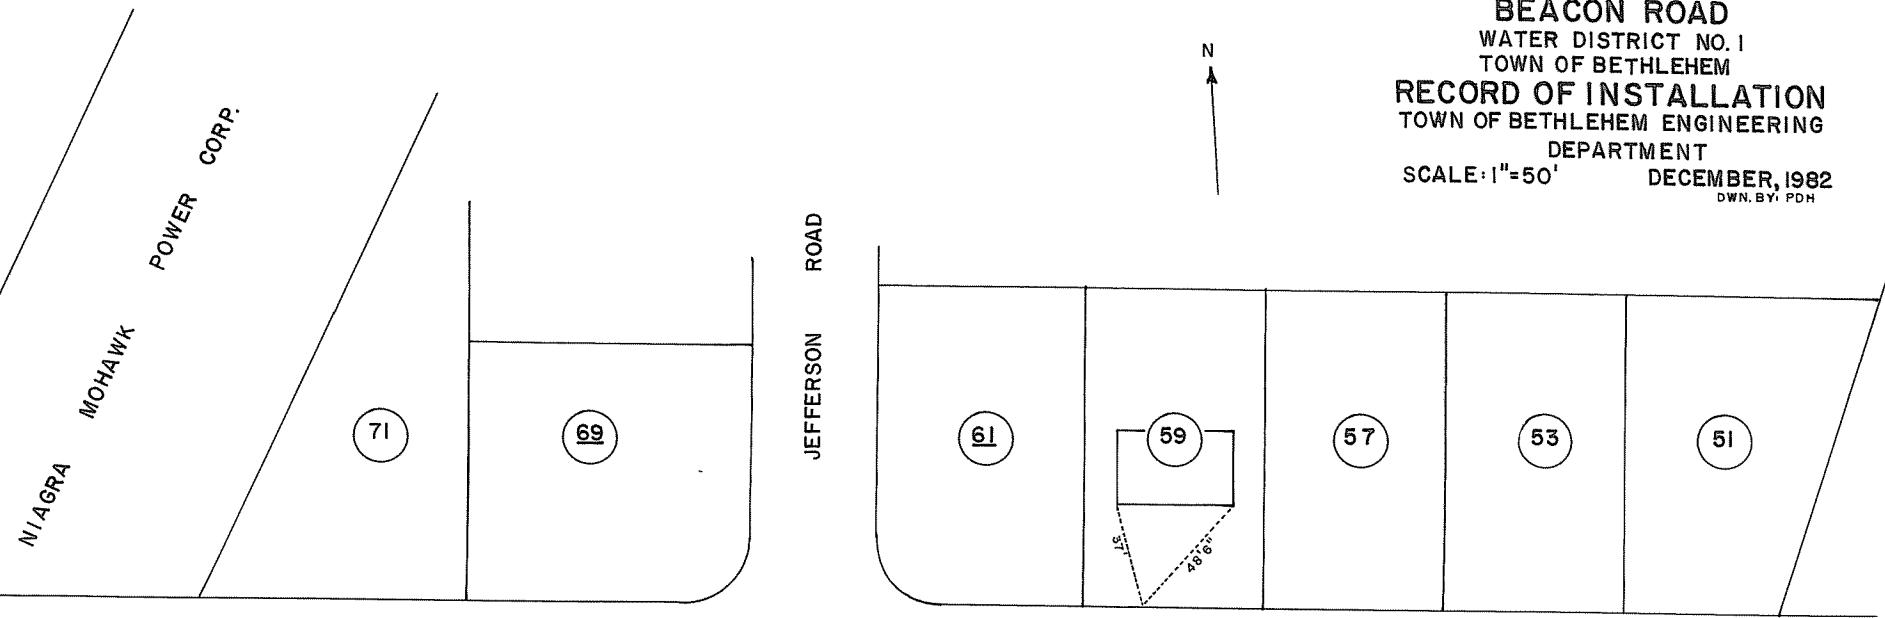

BEACON

ROAD

NYT 12  
45'5" 25'5"  
MH

68

66

92'6"  
97'6"