

BELLEVUE STREET
WATER DISTRICT NO. I

TOWN OF BETHLEHEM


RECORD OF INSTALLATION

TOWN OF BETHLEHEM ENGINEERING
DEPARTMENT

SCALE: 1" = 50'

JUNE, 1984

DWN. BY: KT

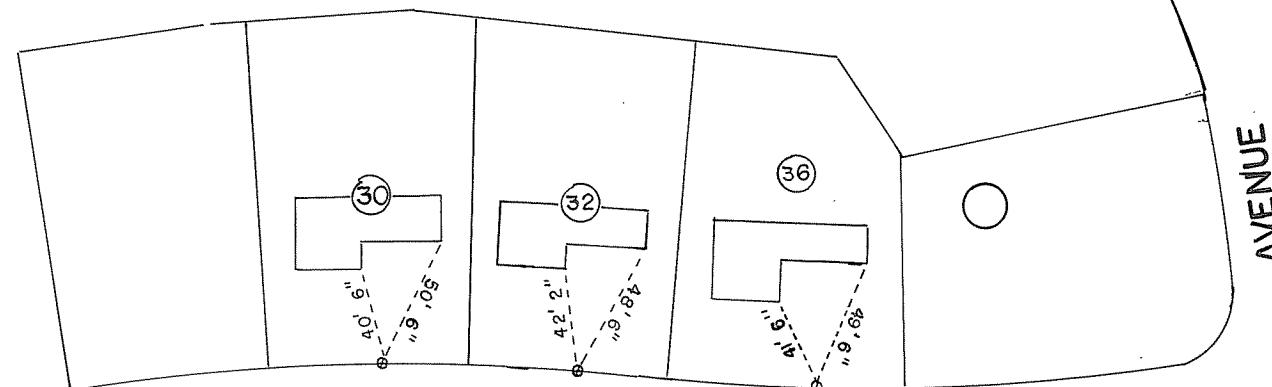

BELLEVUE

STREET

DORCHESTER

