


CONSTRUCTED FEB. 1978 TO
APRIL 1978
CONTRACTOR: COUNTY EXCAV. INC.
SOIL: 1' TO 4' OF SAND ON TOP OF CLAY

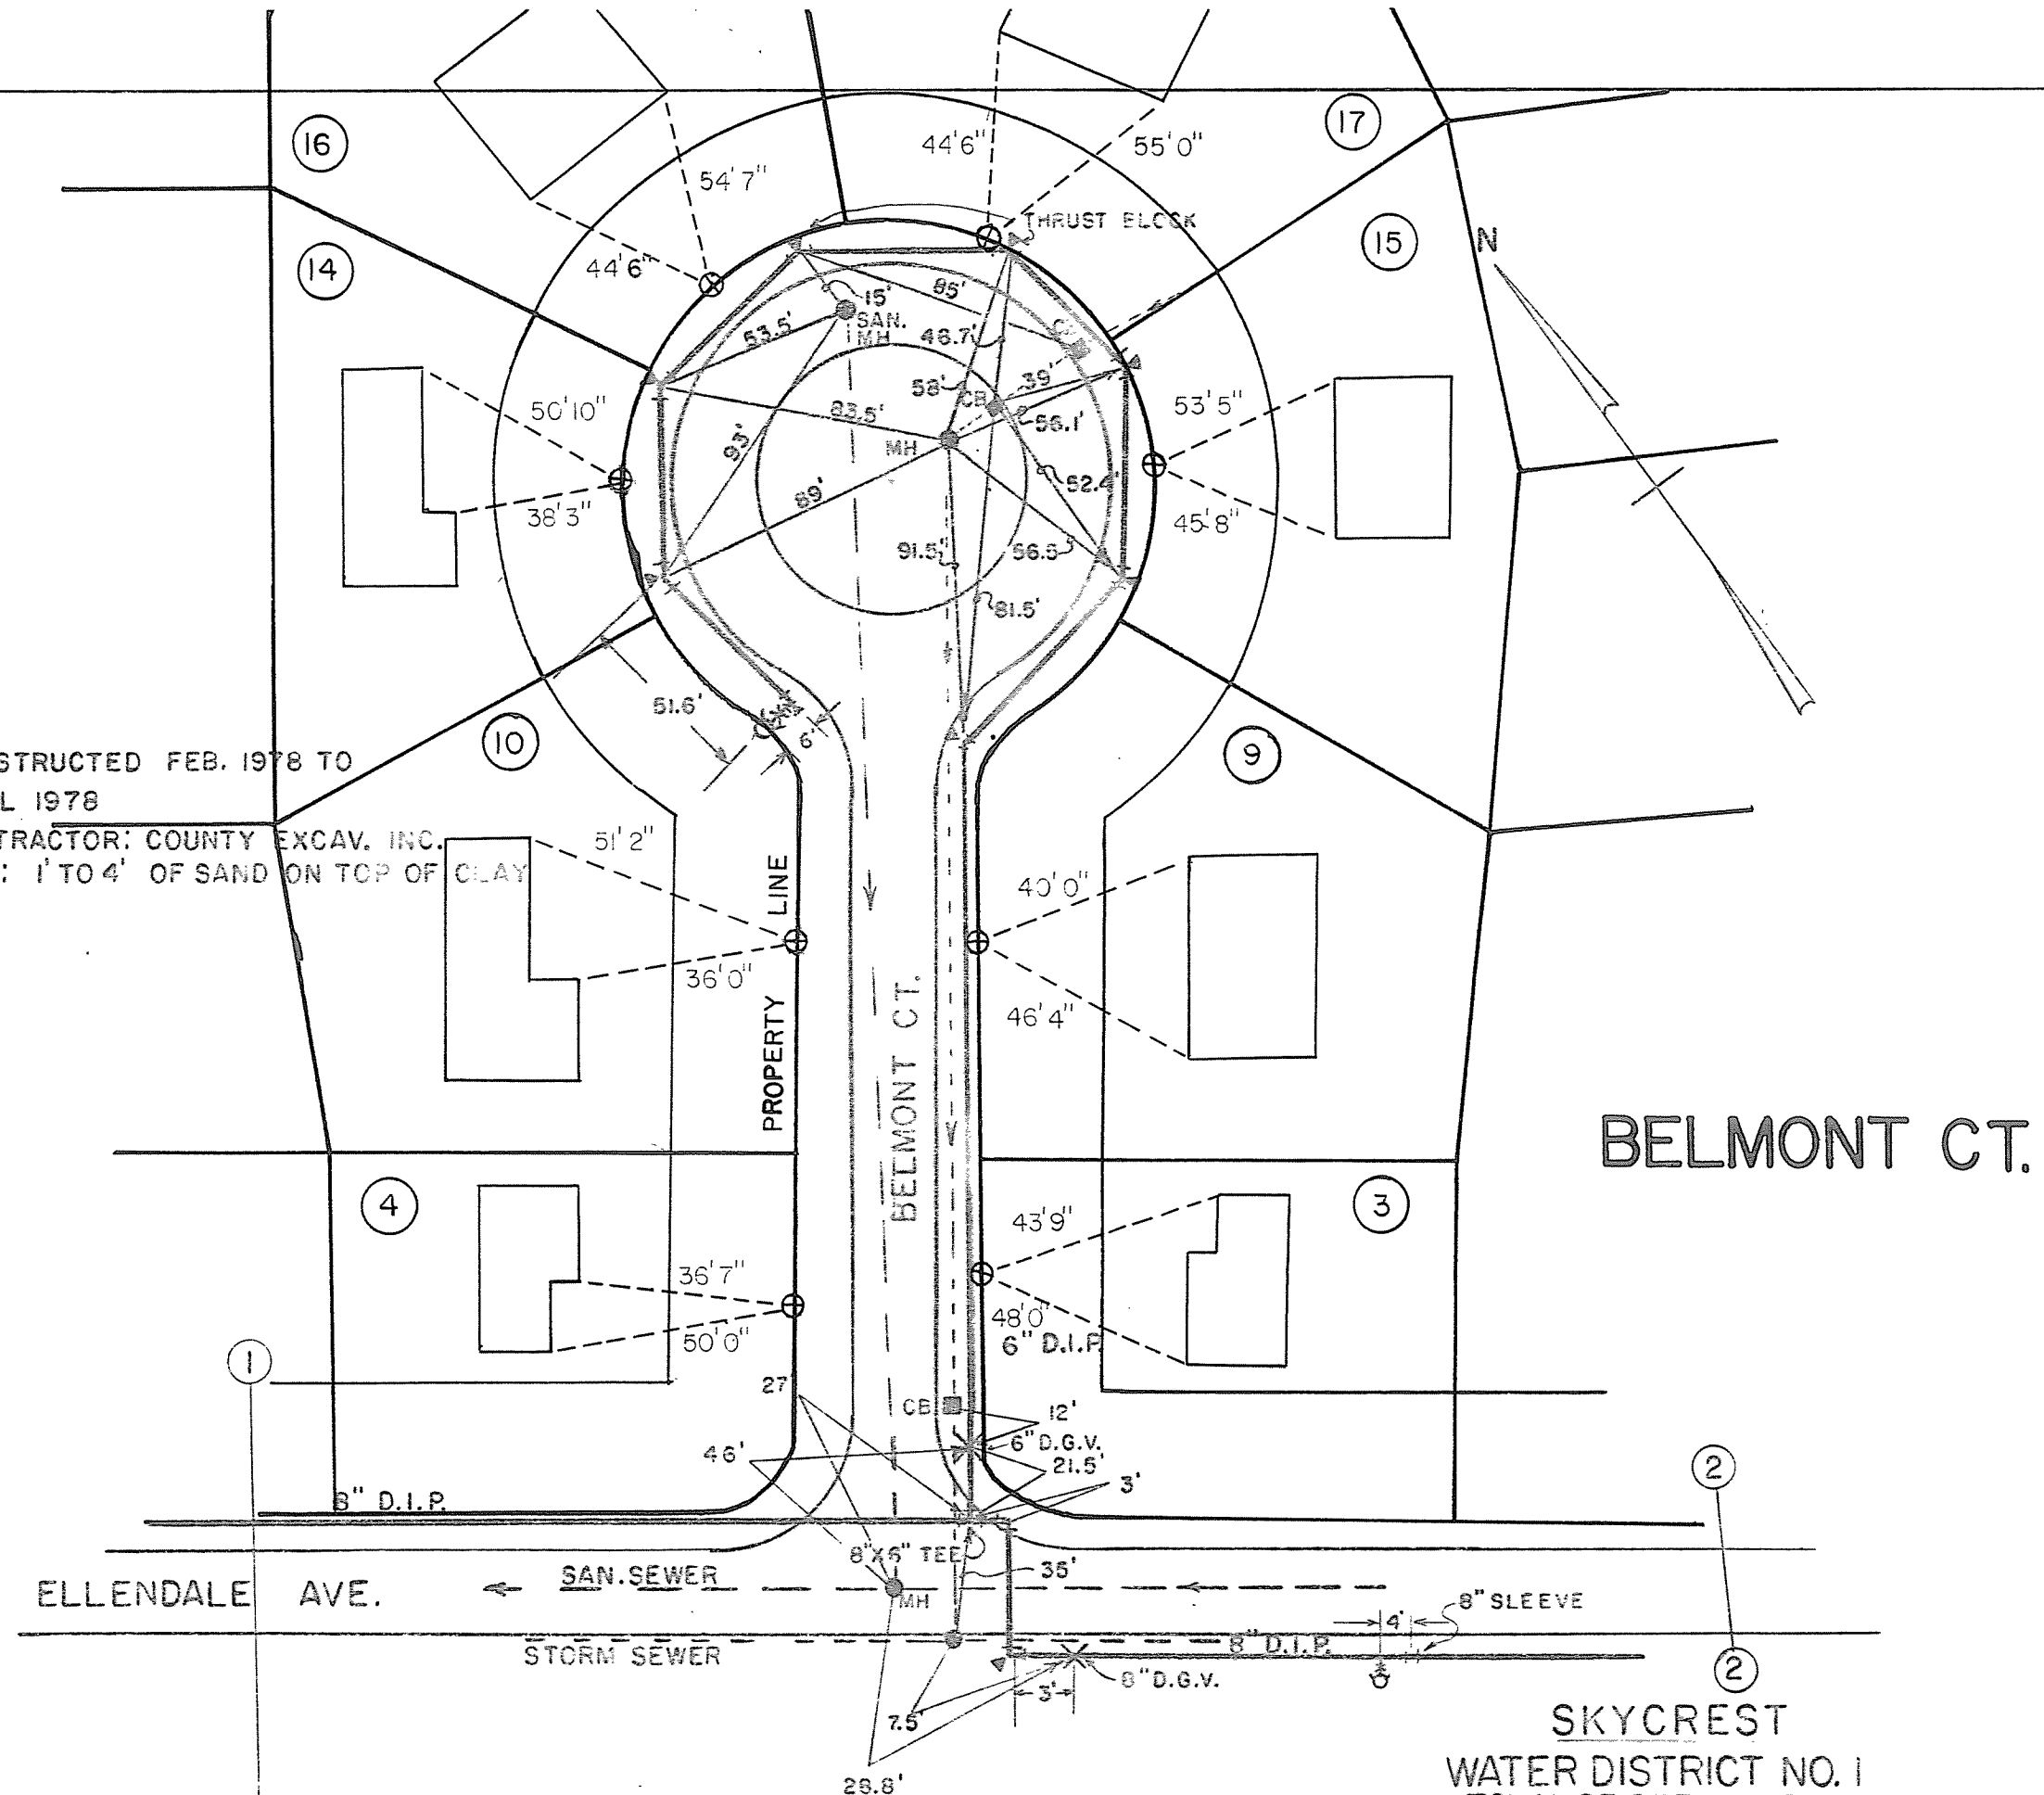

SKYCREST
WATER DISTRICT NO. 1
TOWN OF BETHLEHEM
RECORD OF INSTALLATION
SCALE: 1" = 50' APRIL 1978
J. KENNETH FRASER & ASSOCIATES, P. C.
CONSULTING ENGINEERS RENSSELAER, N.Y.

DRAWN BY: H.P.J.
CHECKED BY: W.T.B.