


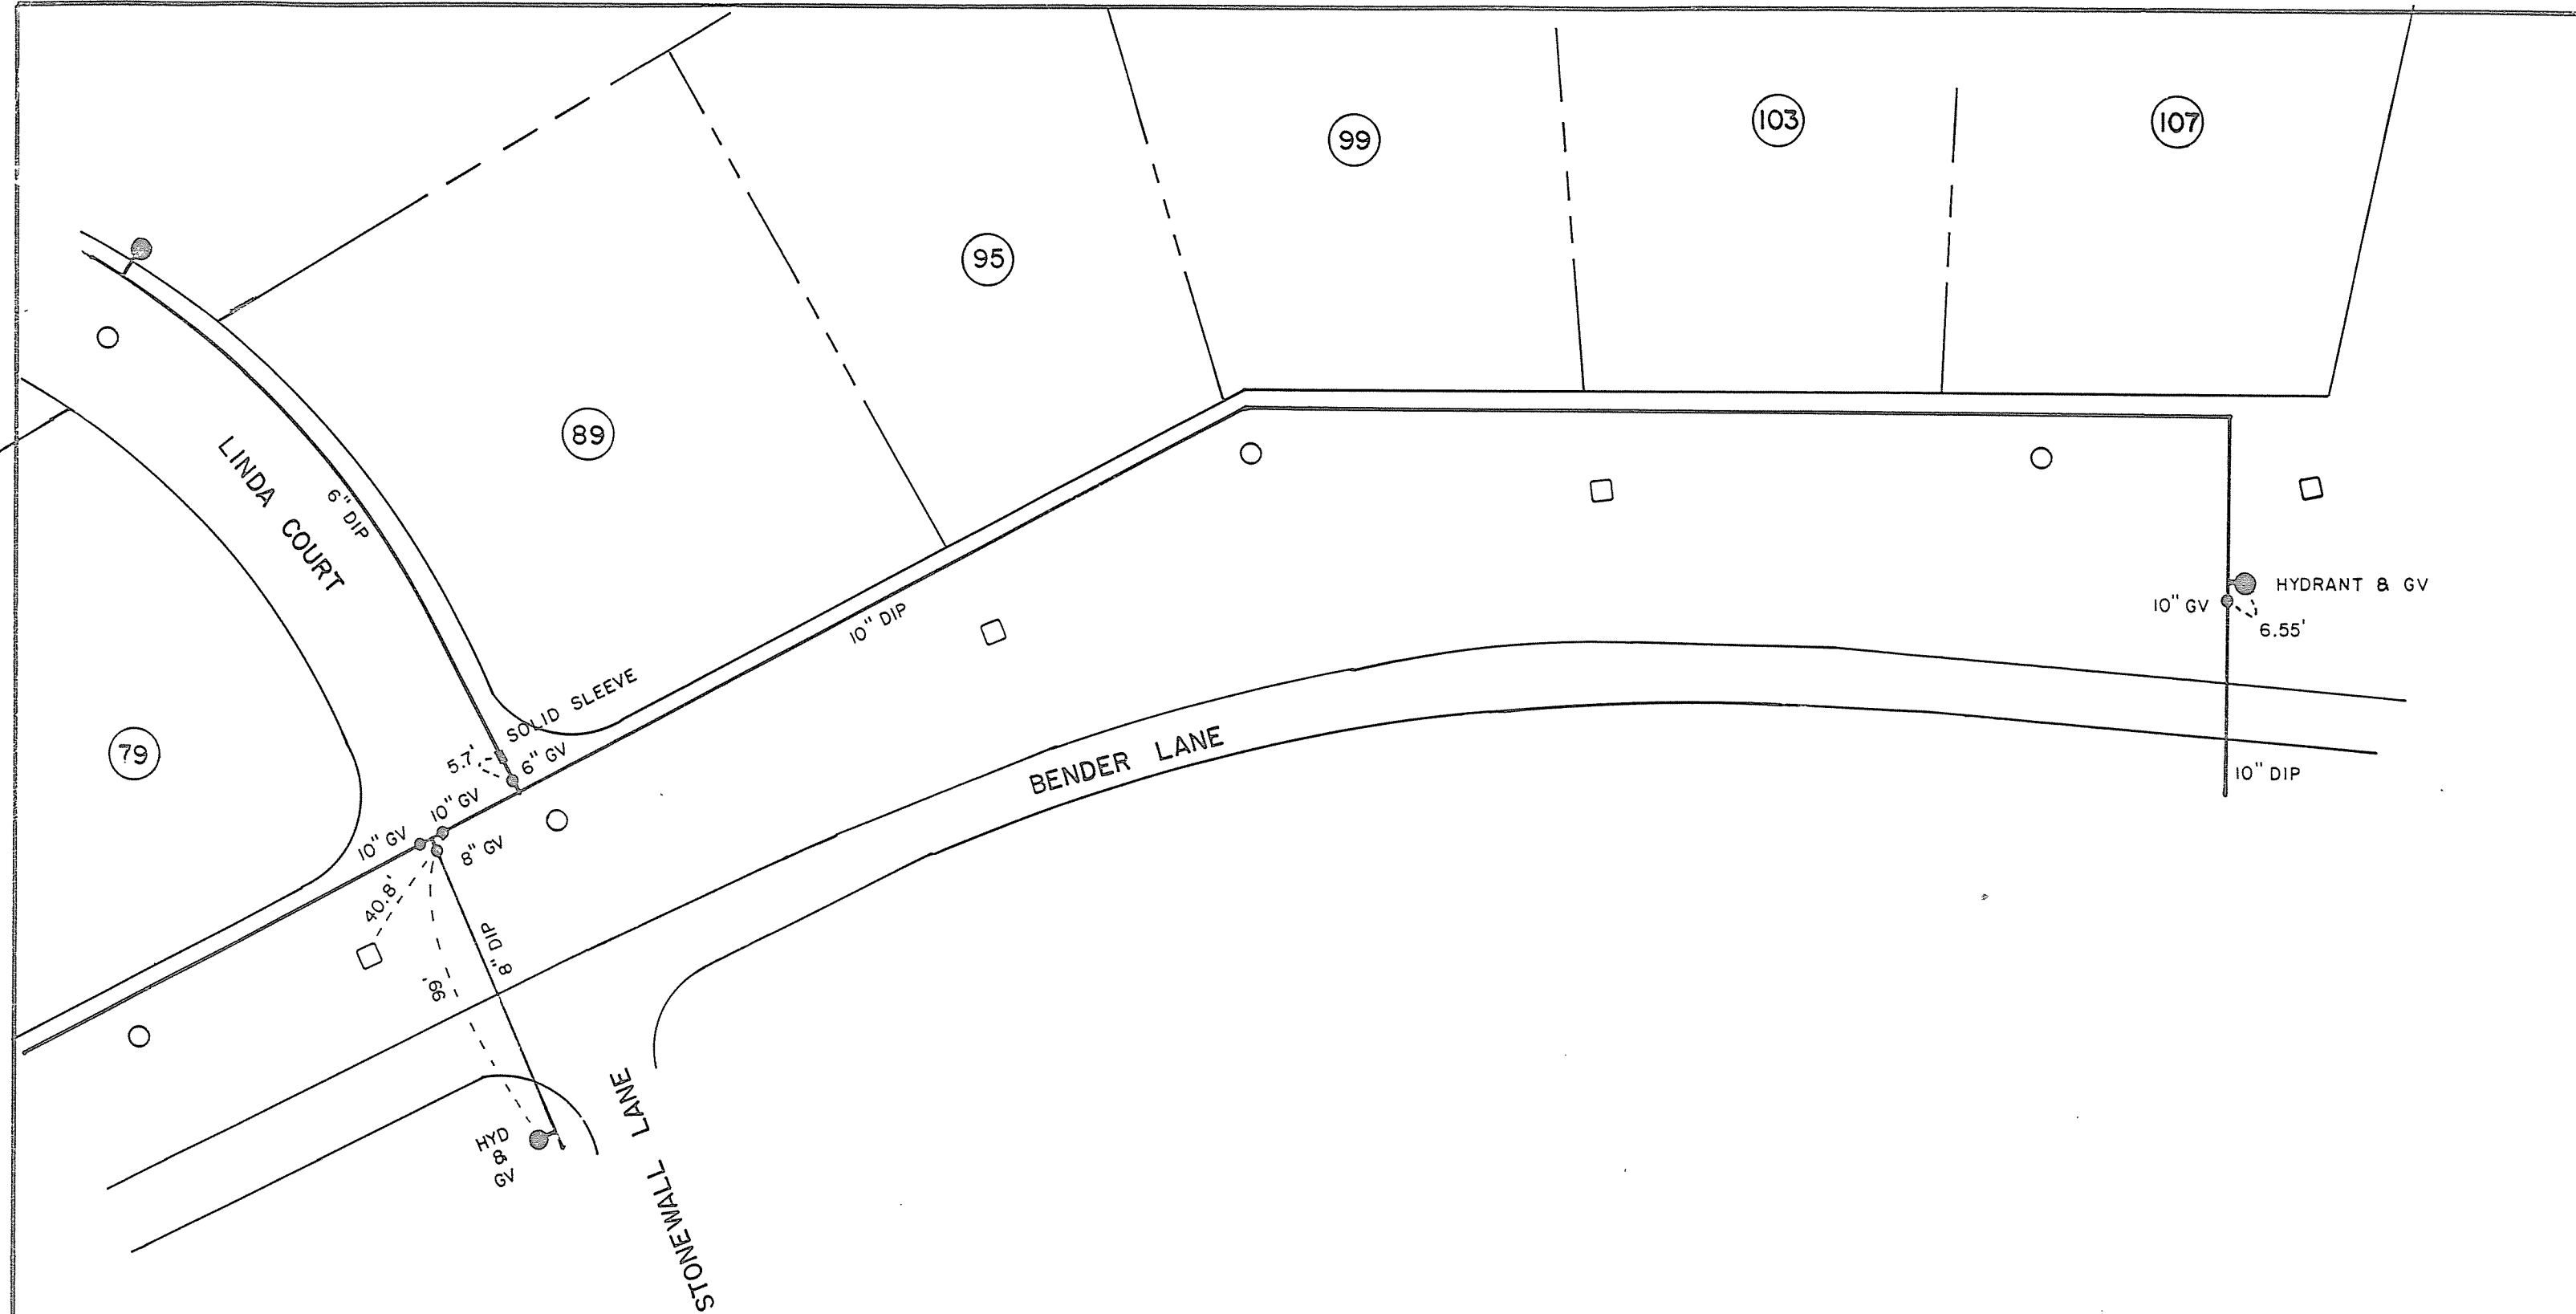

BENDER LANE
 WATER MAIN
 MARCH 1988
 1" = 50'