


BENDER LANE
WATER DISTRICT NO.1
TOWN OF BETHLEHEM
RECORD OF INSTALLATION
TOWN OF BETHLEHEM ENGINEERING
DEPARTMENT
SCALE: 1"=50' DECEMBER, 1982
DWN. BY: PDH



ALDEN
COURT

27

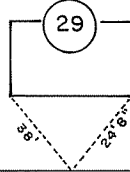

29

31

33

ALBANY

37

41

BENDER

LANE

22

26

32

36

CITY
OF