

CITY OF ALBANY

BENDER

DEVON ROAD

LANE

WINDSOR COURT

37

41

43

45


47

49

51

3

48

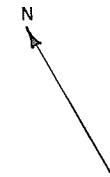

BENDER LANE  
WATER DISTRICT NO. 1  
TOWN OF BETHLEHEM  
**RECORD OF INSTALLATION**  
TOWN OF BETHLEHEM ENGINEERING  
DEPARTMENT  
SCALE: 1" = 50' DECEMBER, 1982  
DWN. BY: PDH