


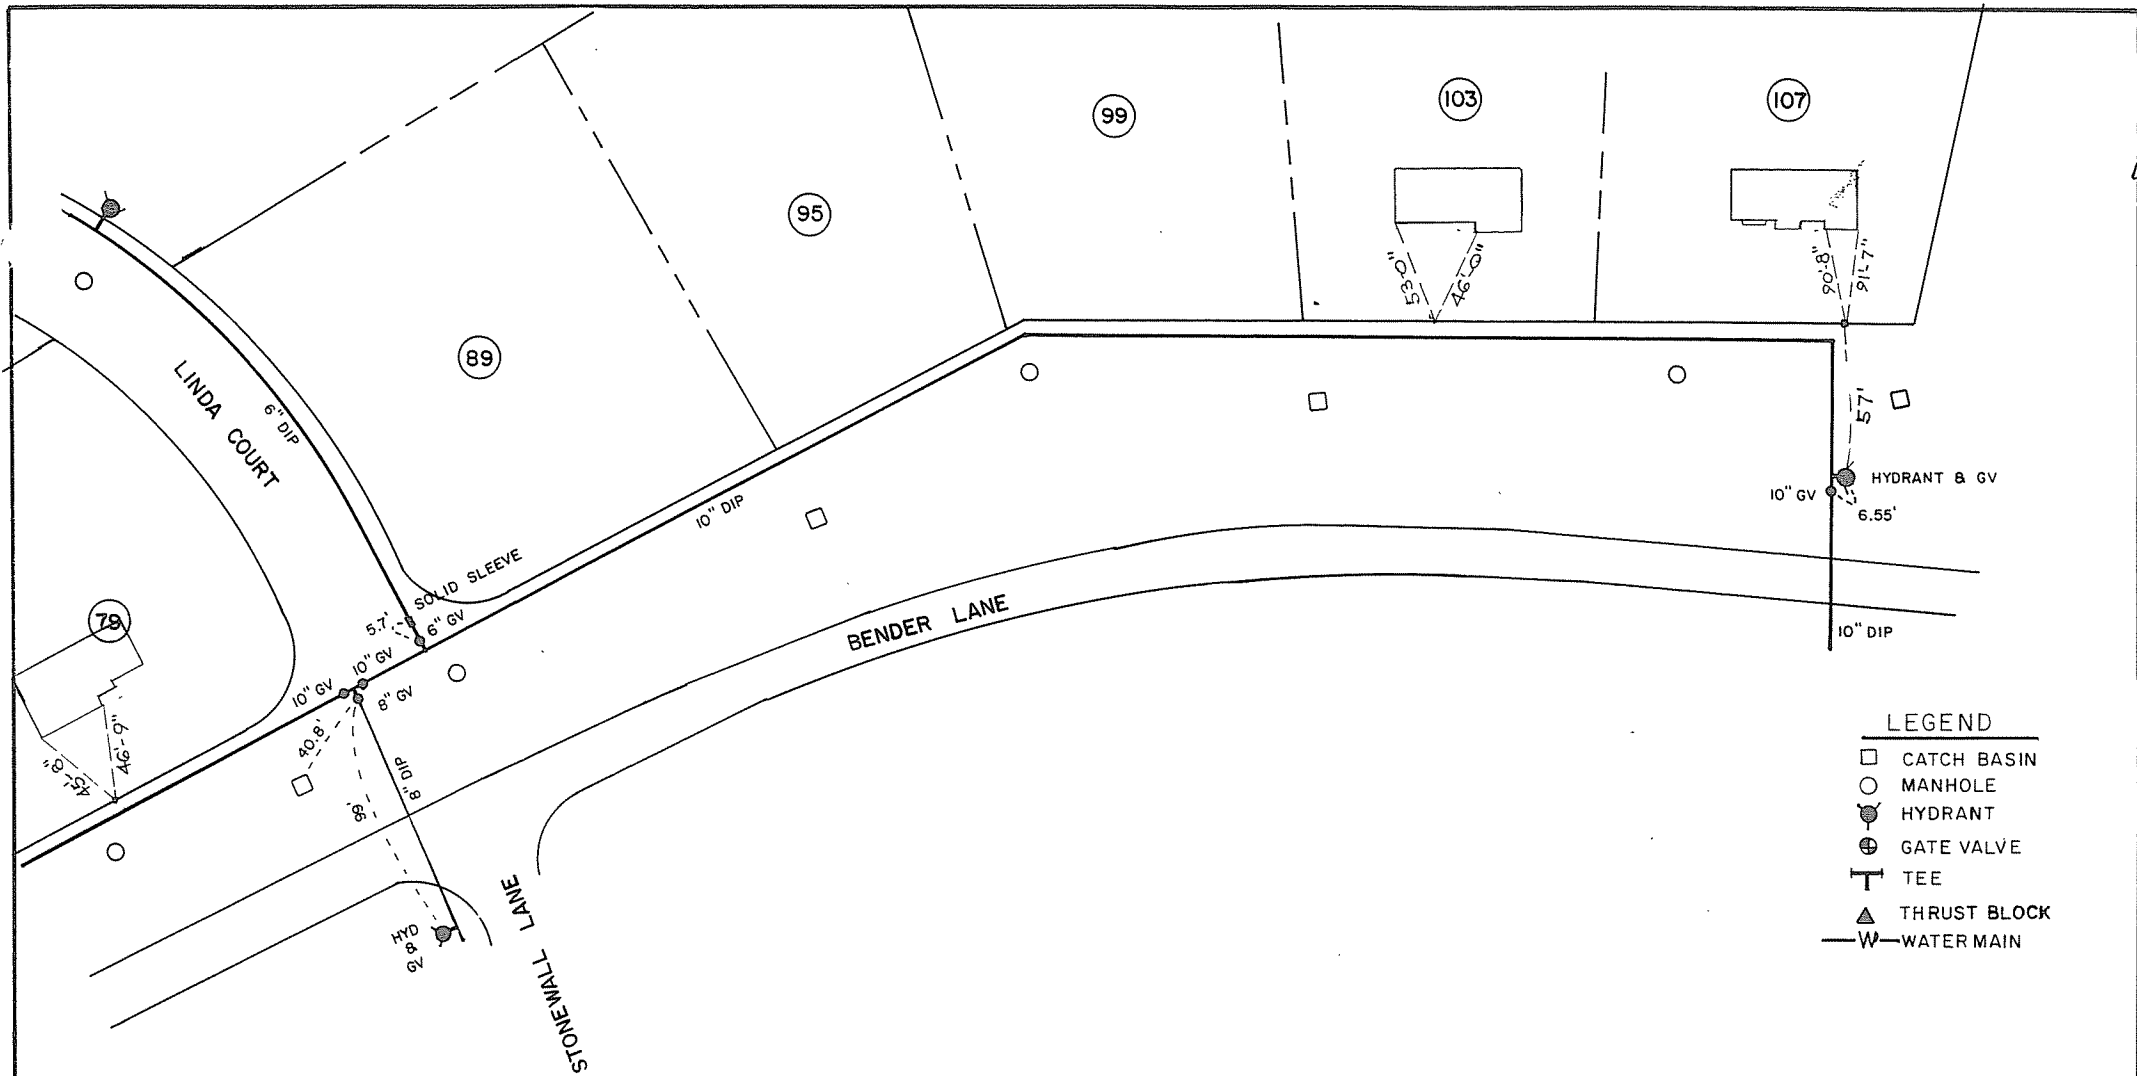

LEGEND

- CATCH BASIN
- MANHOLE
- HYDRANT
- ⊕ GATE VALVE
- T TEE
- ▲ THRUST BLOCK
- W— WATER MAIN

BENDER LANE

WATER MAIN

MARCH 1988

1" = 50'