


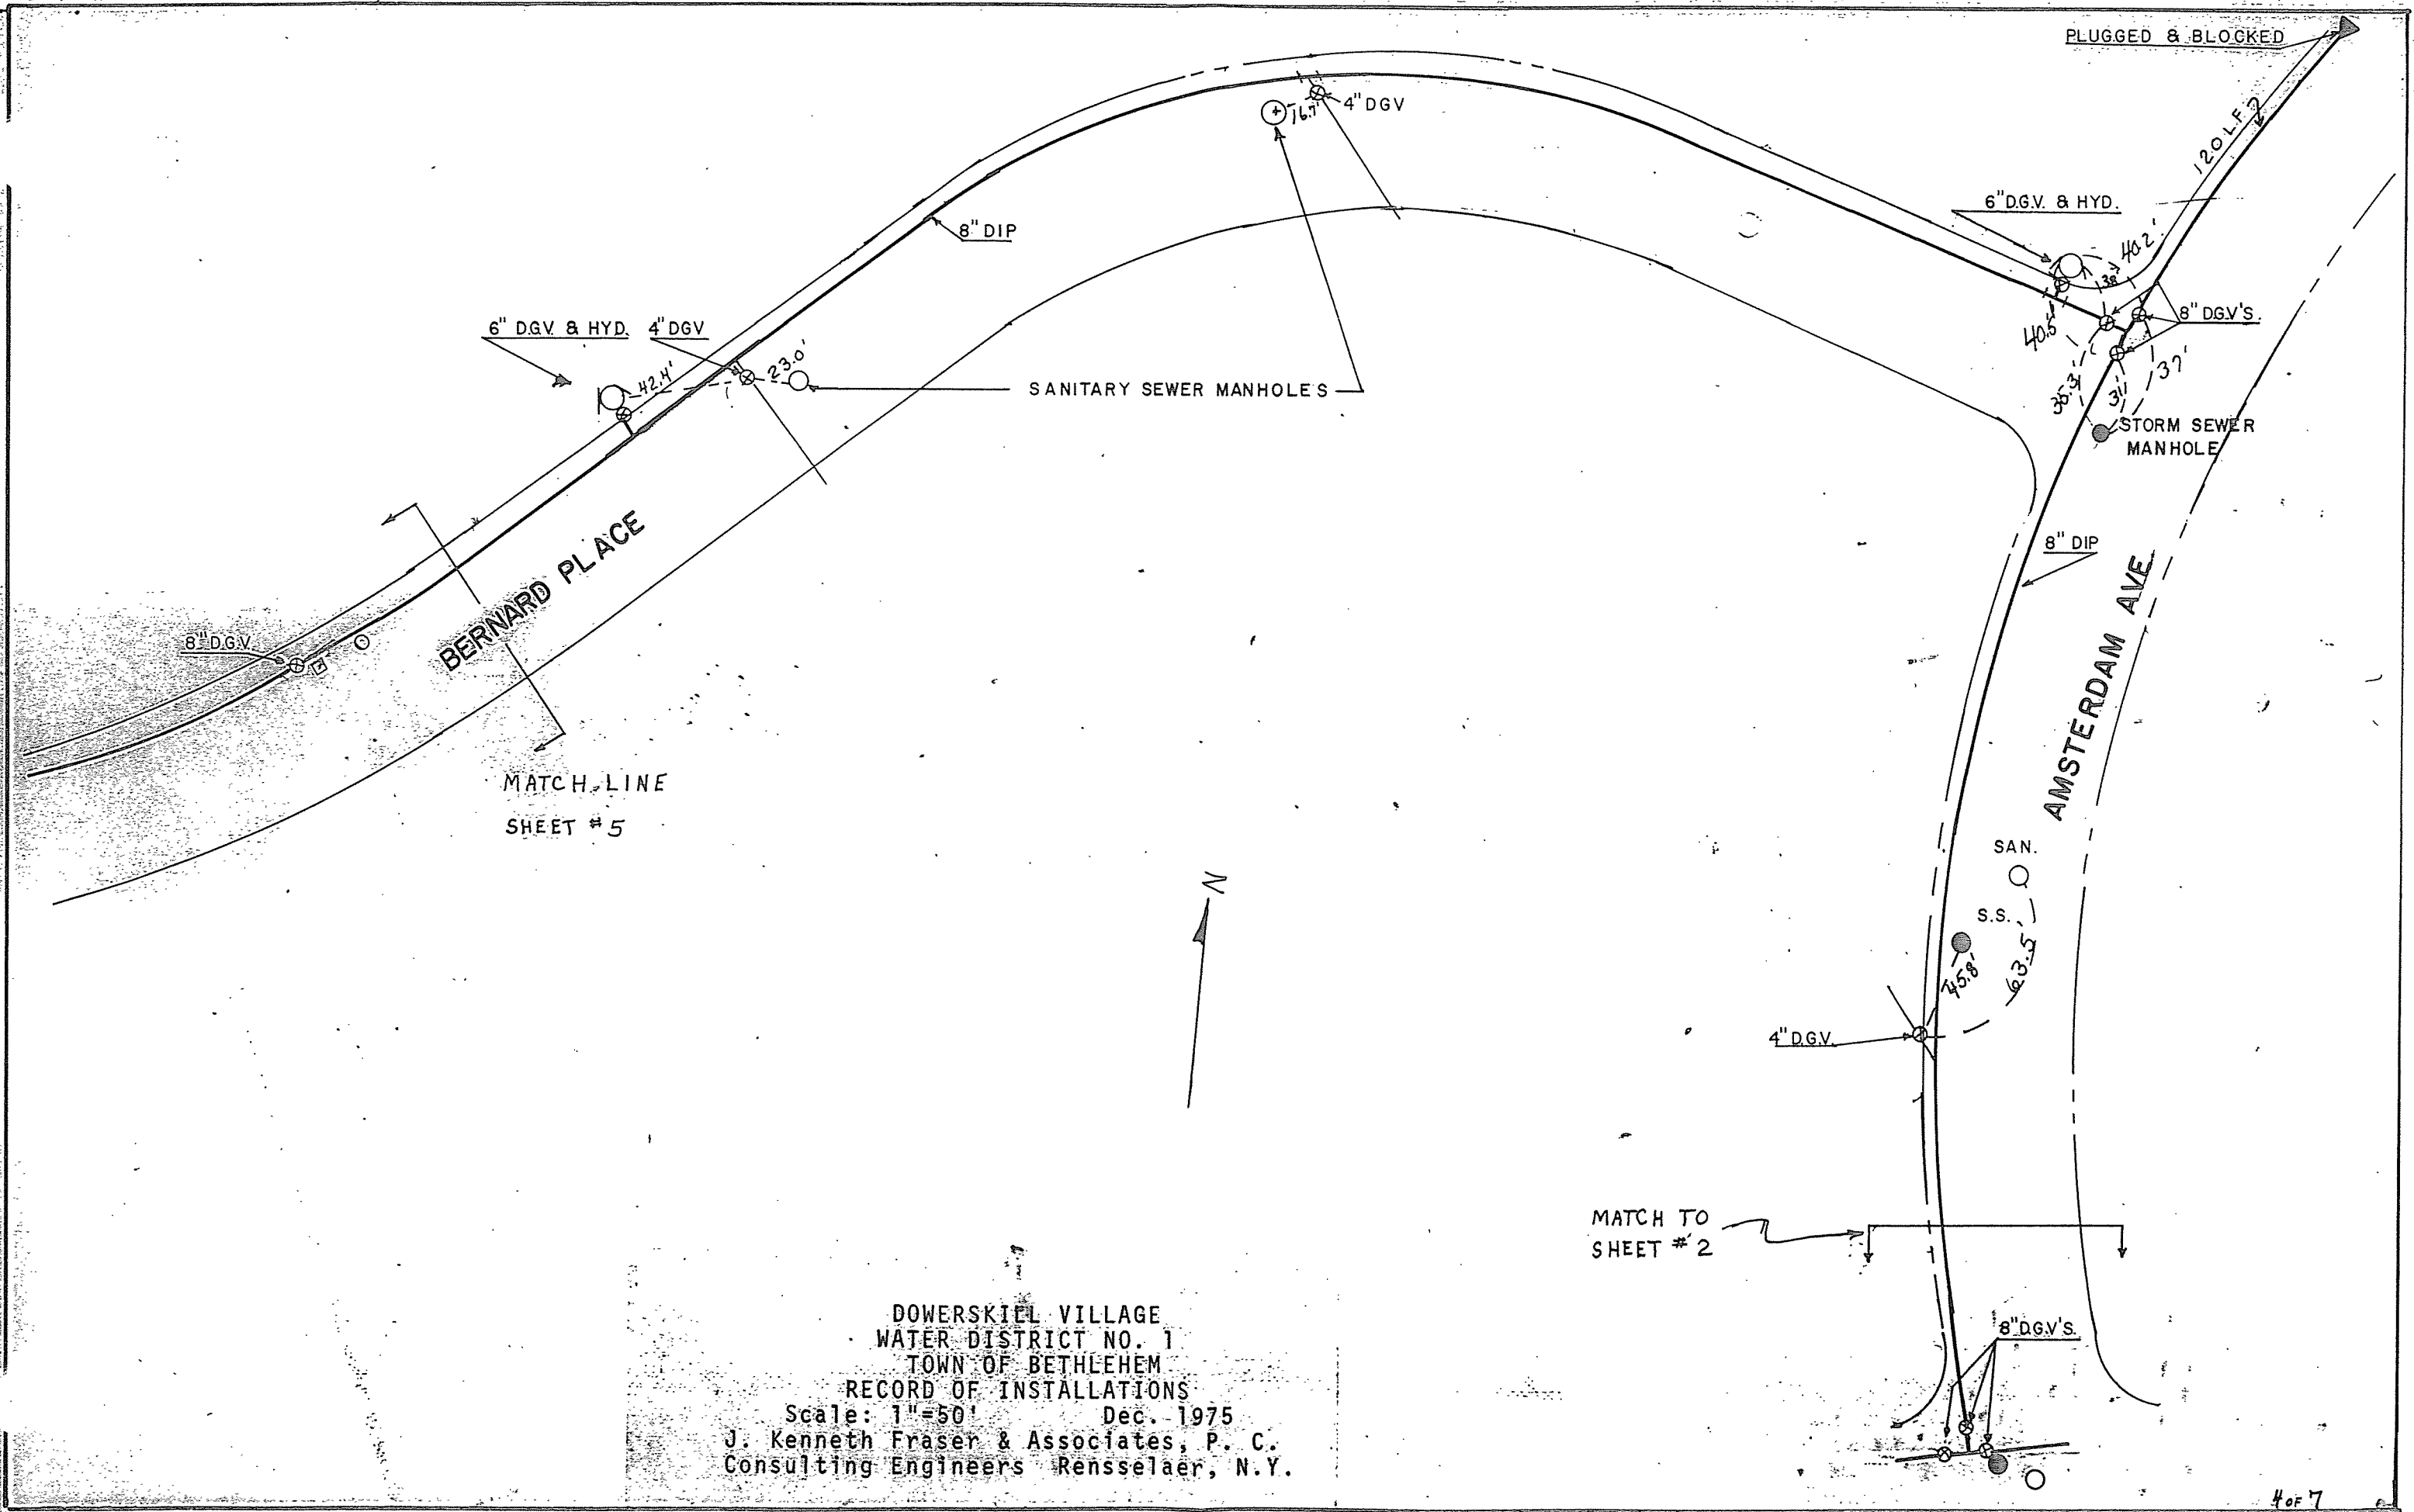

DOWERSKILL VILLAGE
WATER DISTRICT NO. 1
TOWN OF BETHLEHEM
RECORD OF INSTALLATIONS
Scale: 1"=50' Dec. 1975
J. Kenneth Fraser & Associates, P. C.
Consulting Engineers Rensselaer, N.Y.