


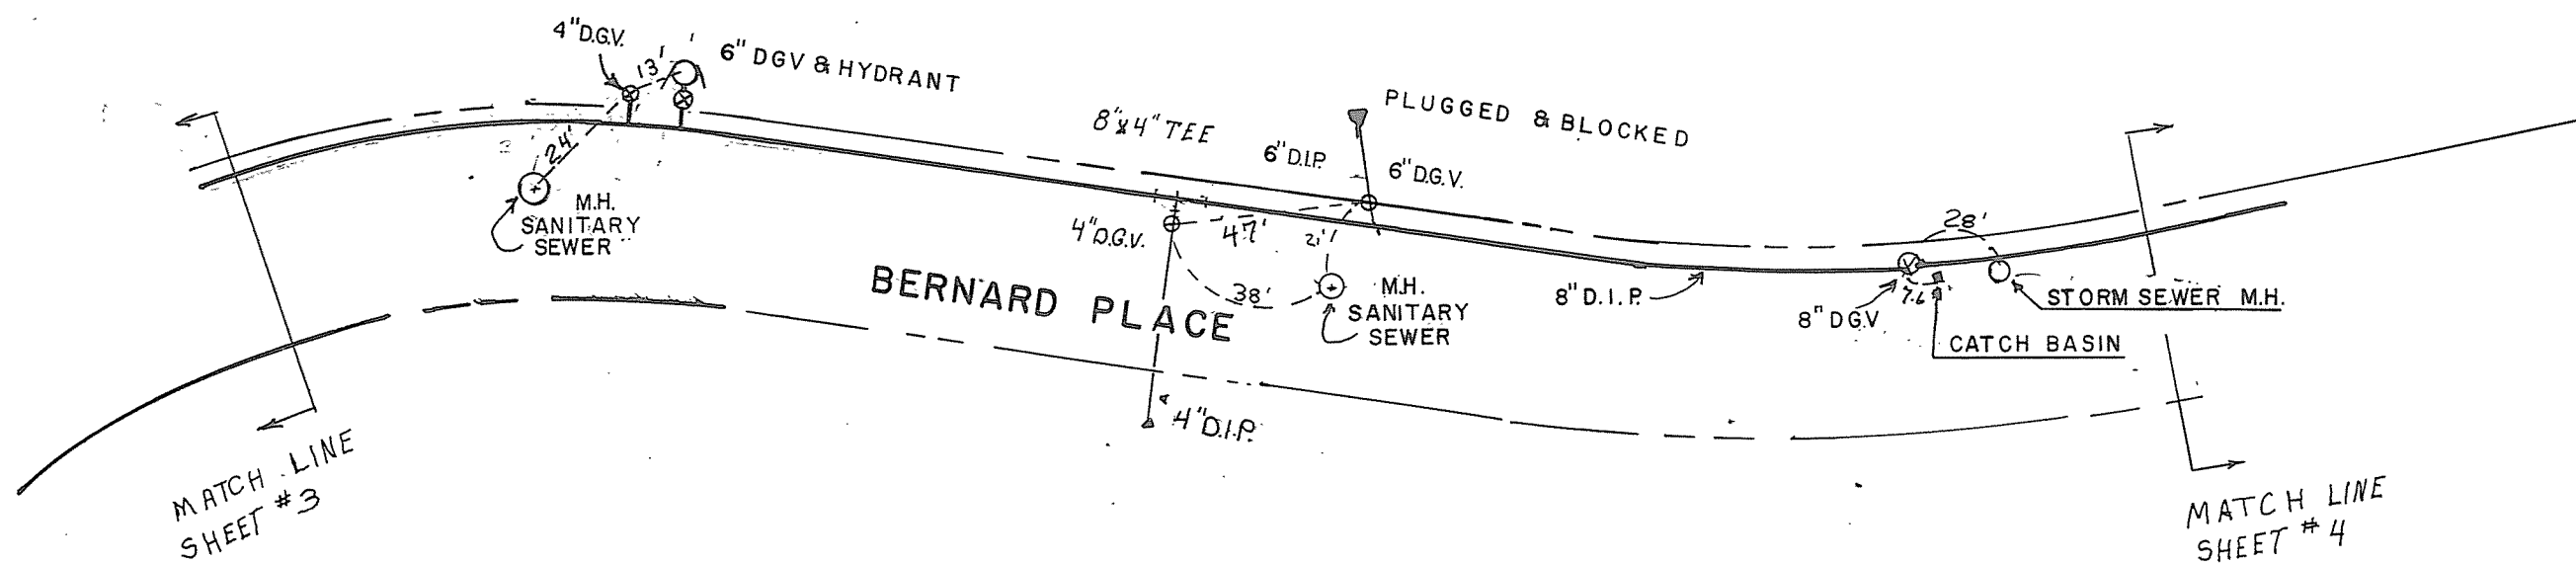

DOWERSKILL VILLAGE
 WATER DISTRICT NO. 1
 TOWN OF BETHLEHEM
 RECORD OF INSTALLATIONS
 Scale: 1"=50' Dec. 1975
 J. Kenneth Fraser & Associates, P. C.
 Consulting Engineers Rensselaer, N.Y.