


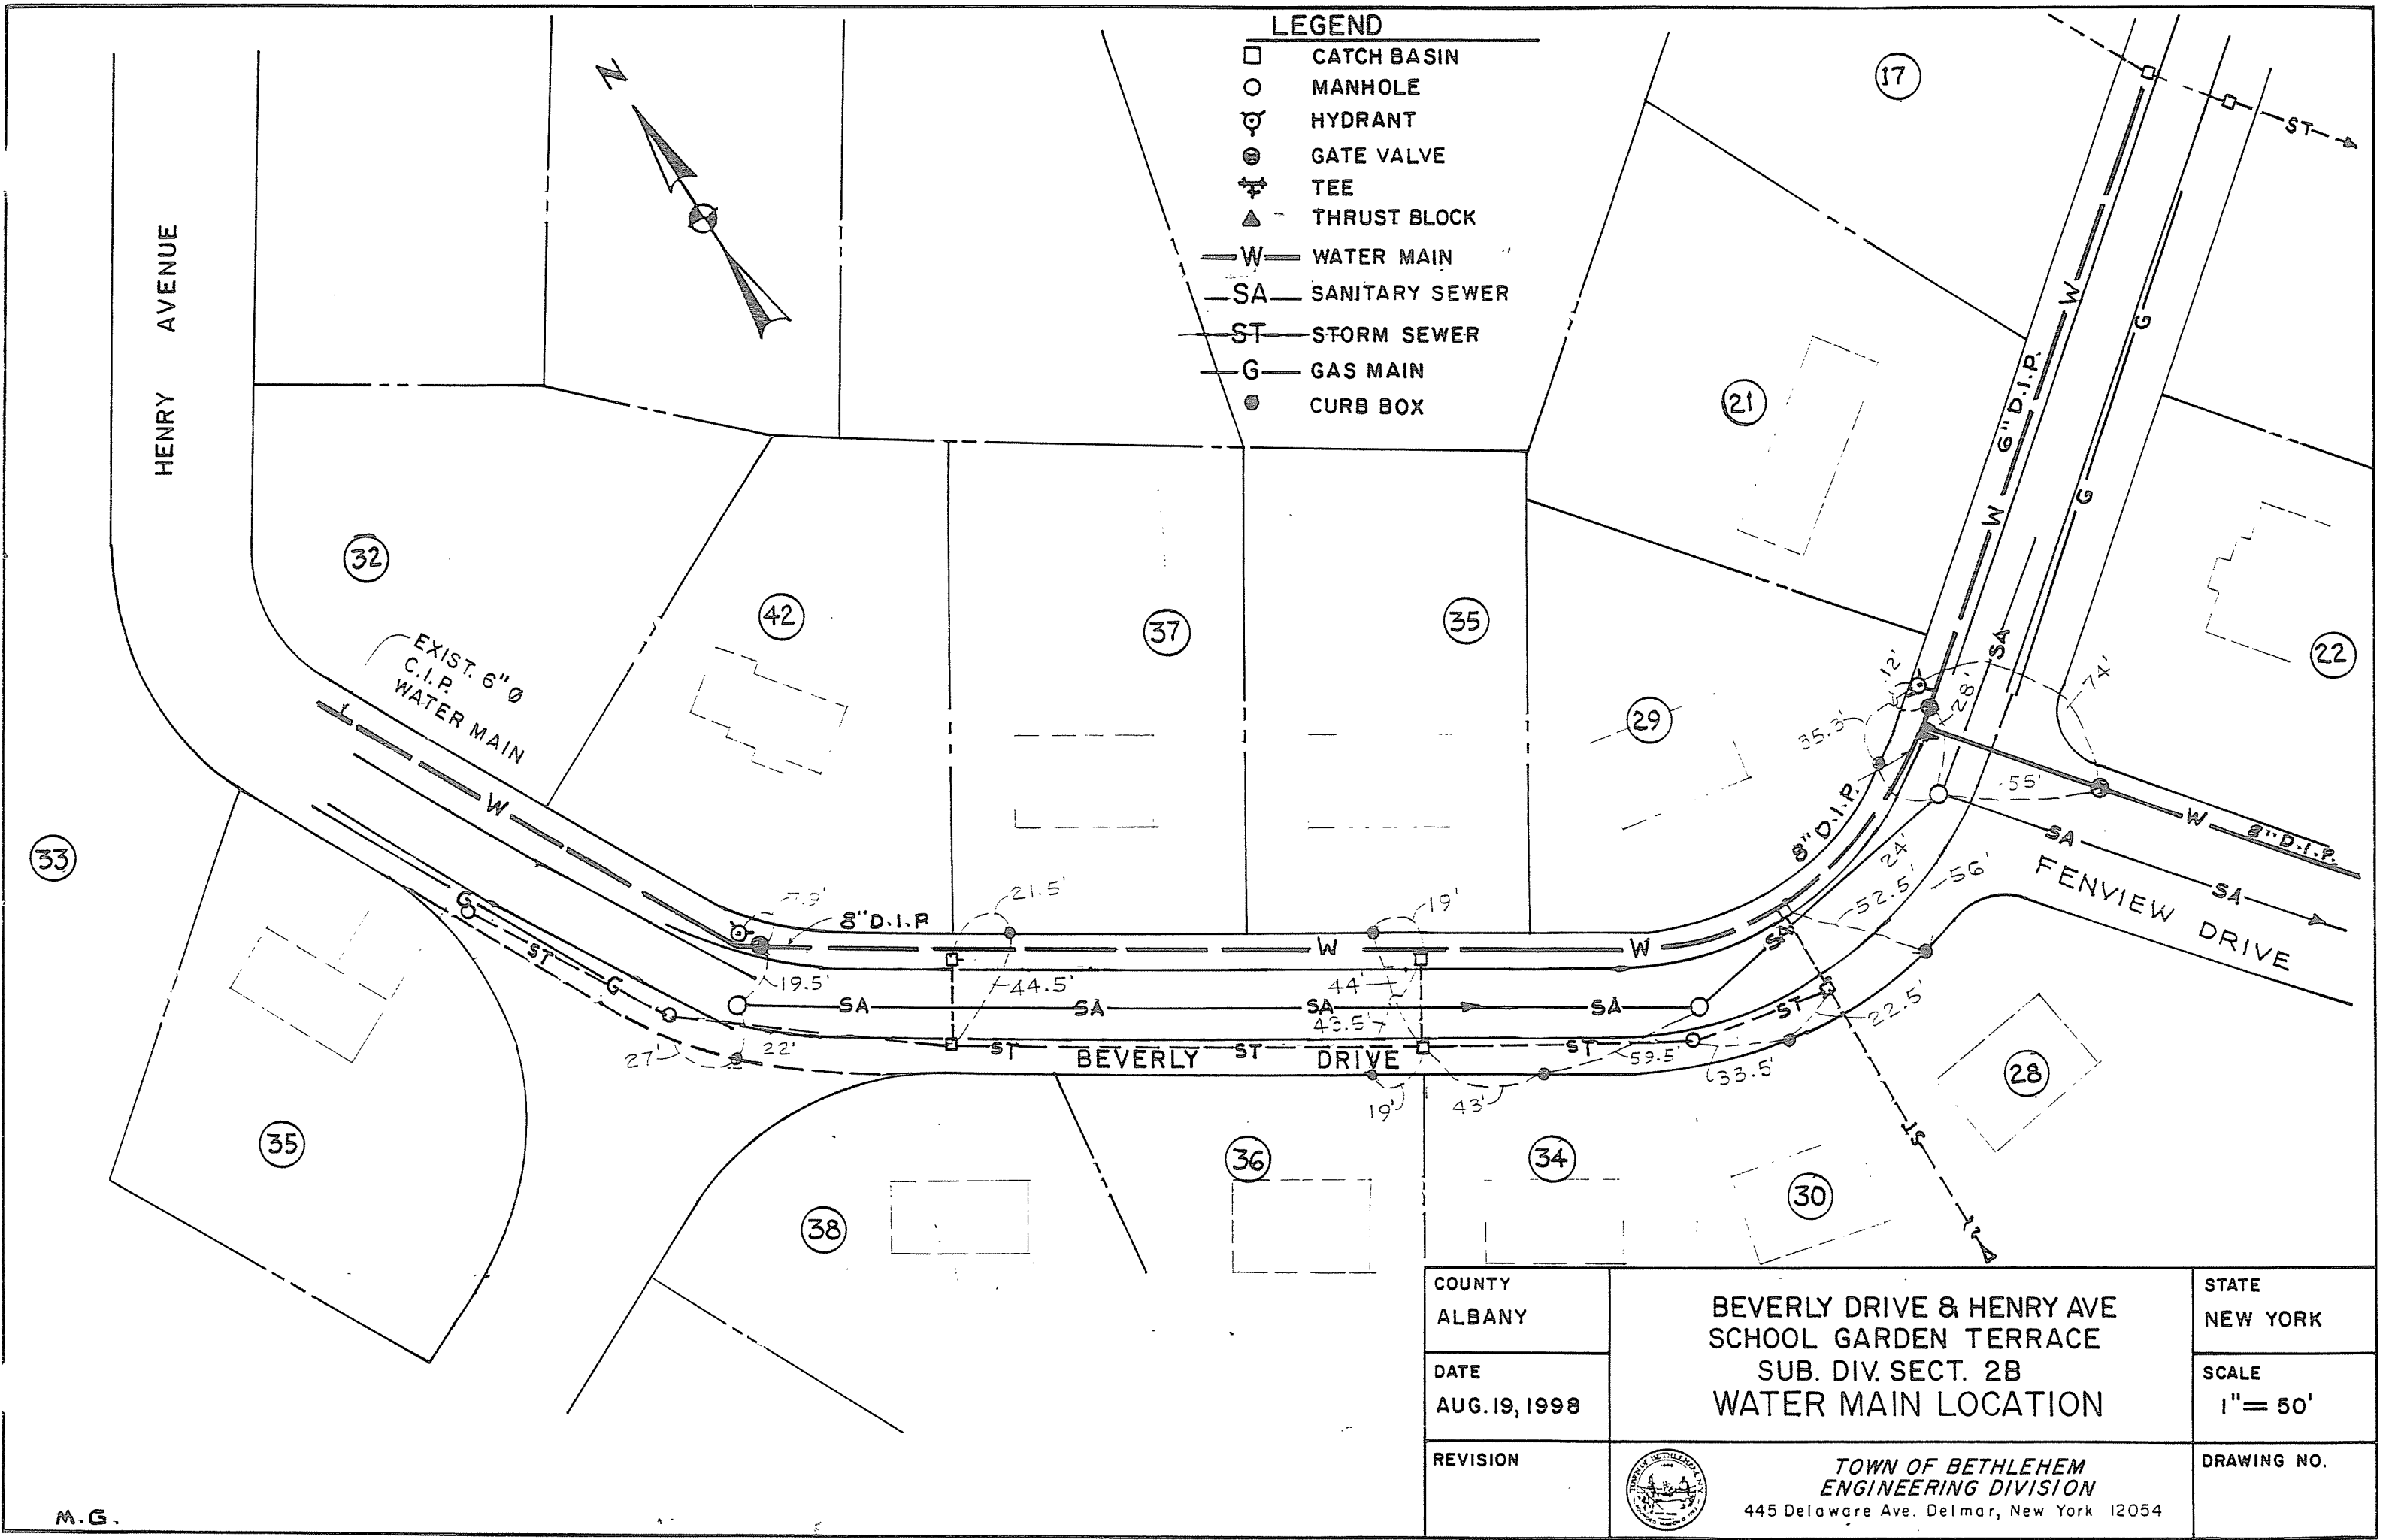

LEGEND

- CATCH BASIN
- MANHOLE
- HYDRANT
- GATE VALVE
- TEE
- THRUST BLOCK
- W WATER MAIN
- SA SANITARY SEWER
- ST STORM SEWER
- G GAS MAIN
- CURB BOX

COUNTY ALBANY	BEVERLY DRIVE & HENRY AVE SCHOOL GARDEN TERRACE SUB. DIV. SECT. 2B WATER MAIN LOCATION	STATE NEW YORK
DATE AUG. 19, 1998		SCALE 1" = 50'
REVISION	 TOWN OF BETHLEHEM ENGINEERING DIVISION 445 Delaware Ave. Delmar, New York 12054	DRAWING NO.

577650

M.G.