


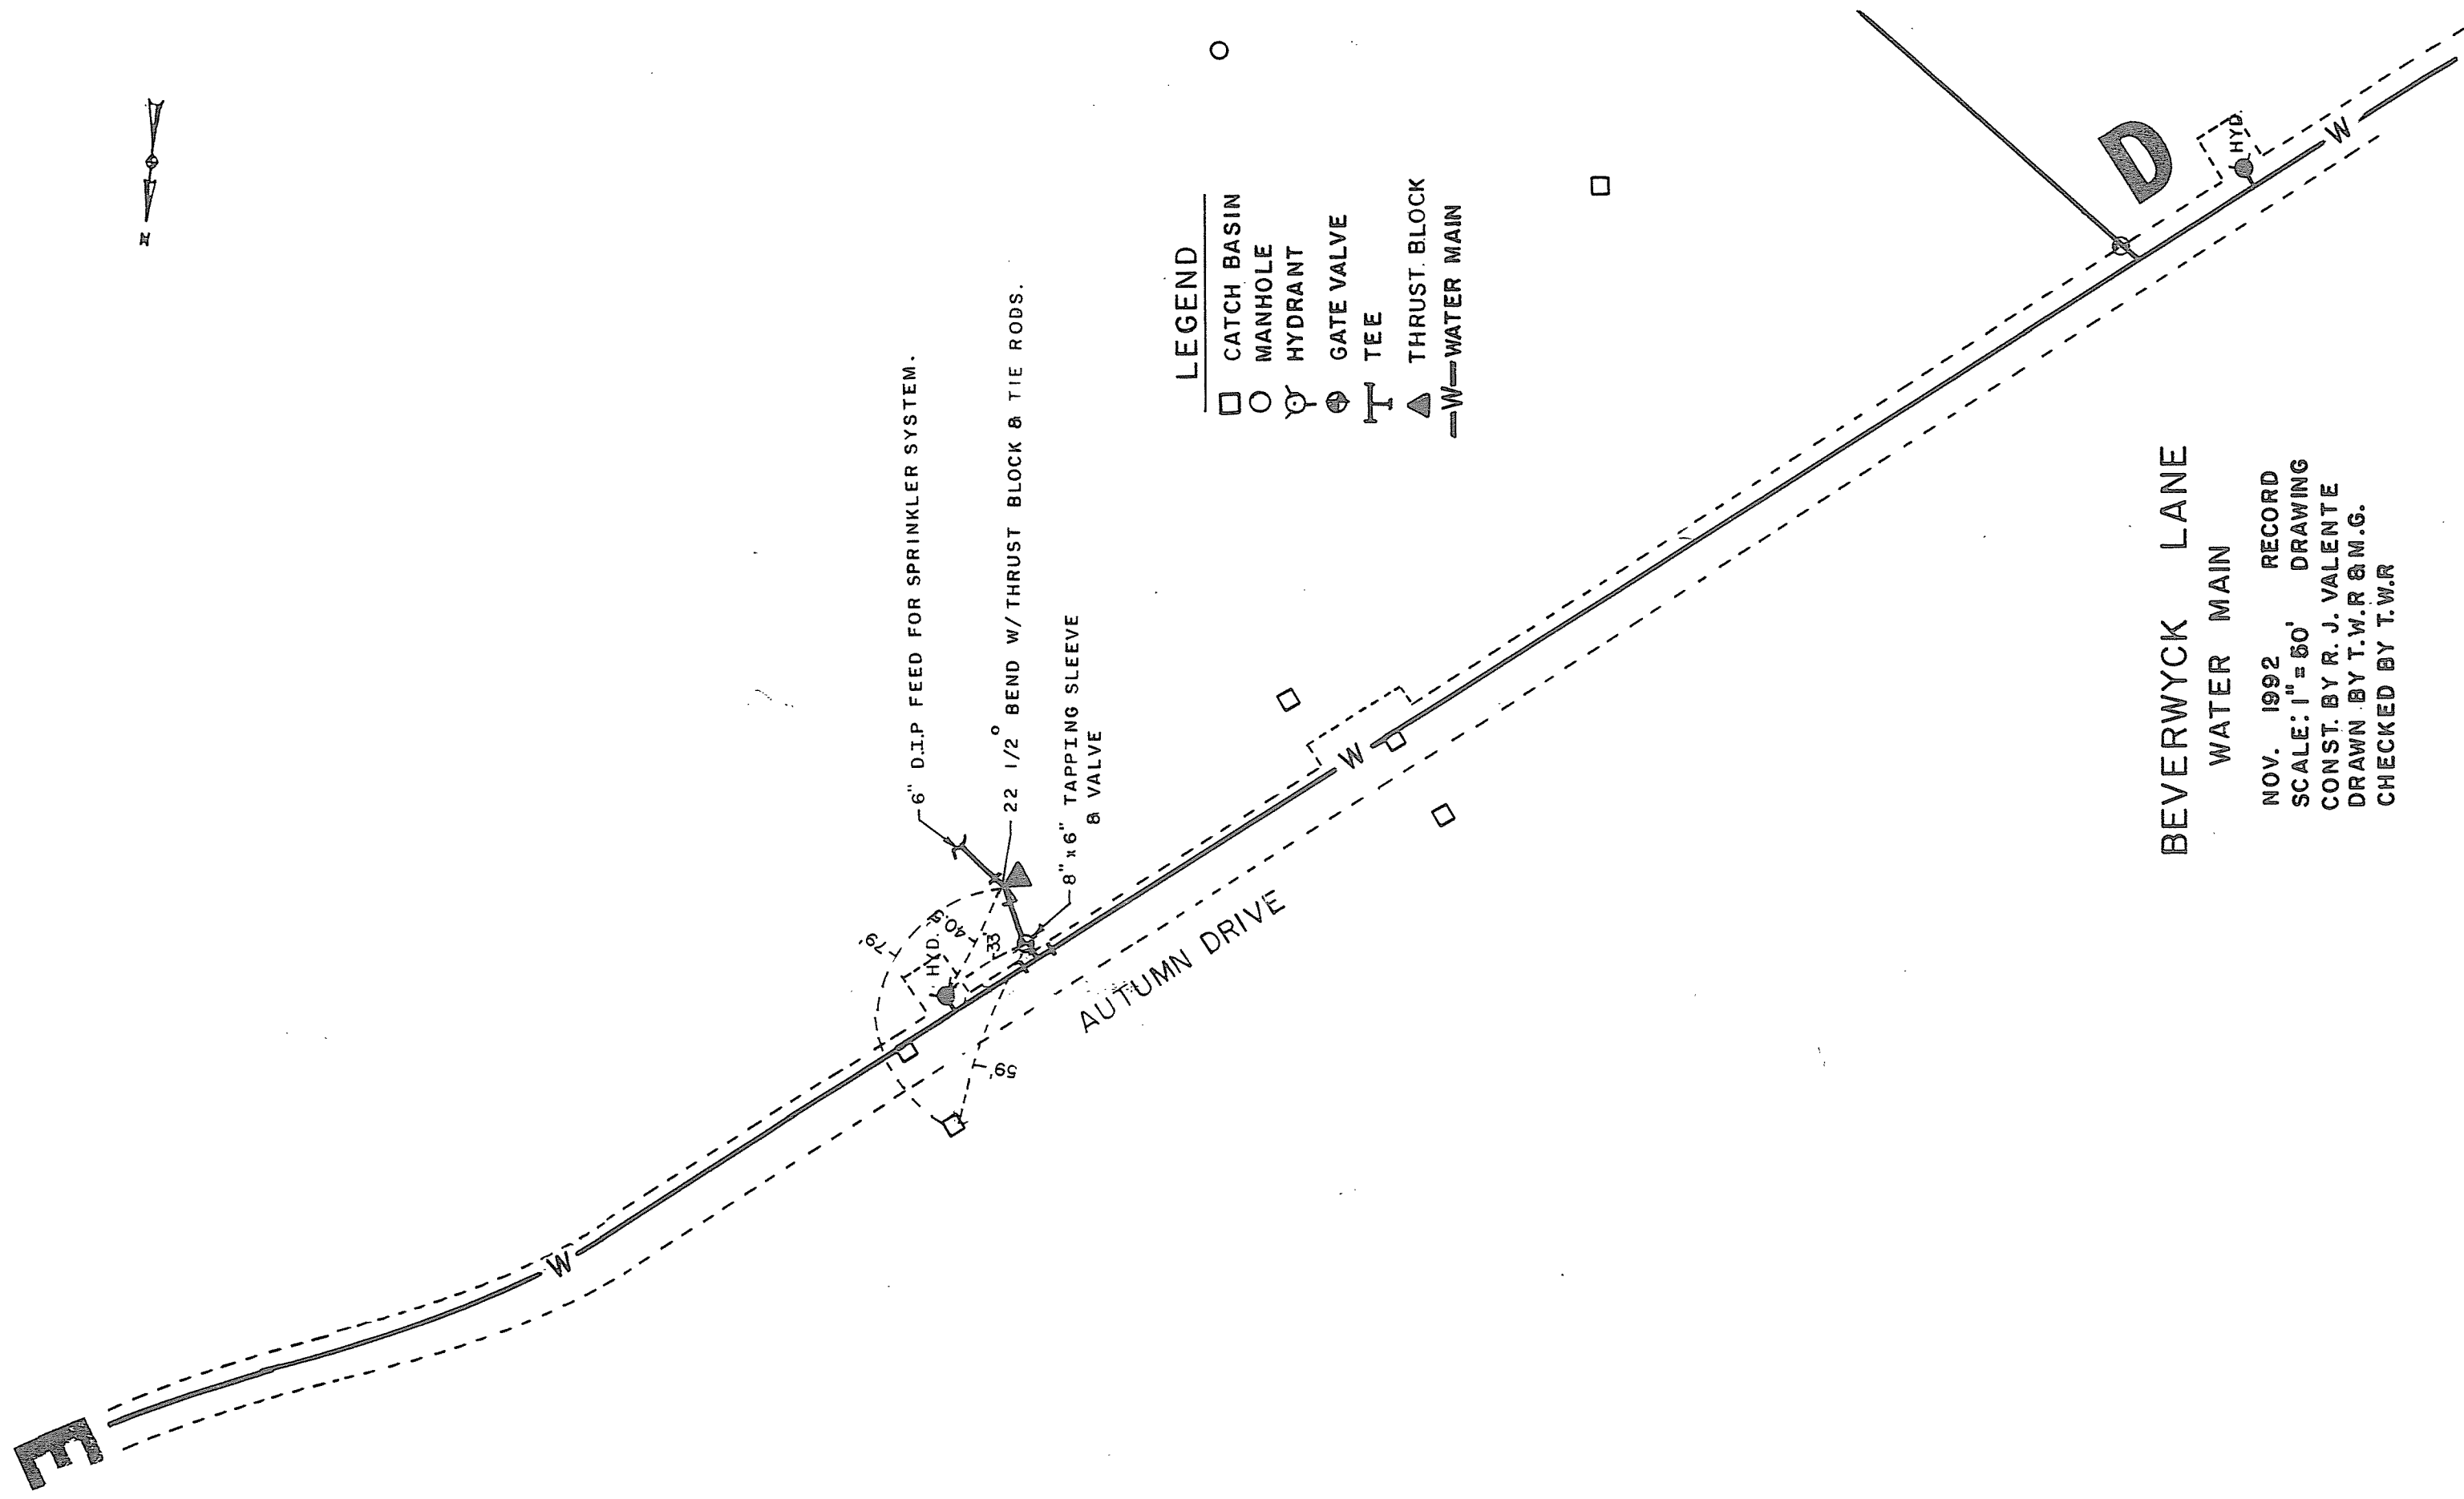

LEGEND

- CATCH BASIN
- MANHOLE
- ⊙ HYDRANT
- ⊕ GATE VALVE
- ⊥ TEE
- ▲ THRUST BLOCK
- W— WATER MAIN

BEVERWYCK LANE
WATER MAIN

NOV. 1992 RECORD
SCALE: 1" = 50' DRAWING
CONST. BY R. J. VALENTE
DRAWN BY T.W.R & M.G.
CHECKED BY T.W.R