


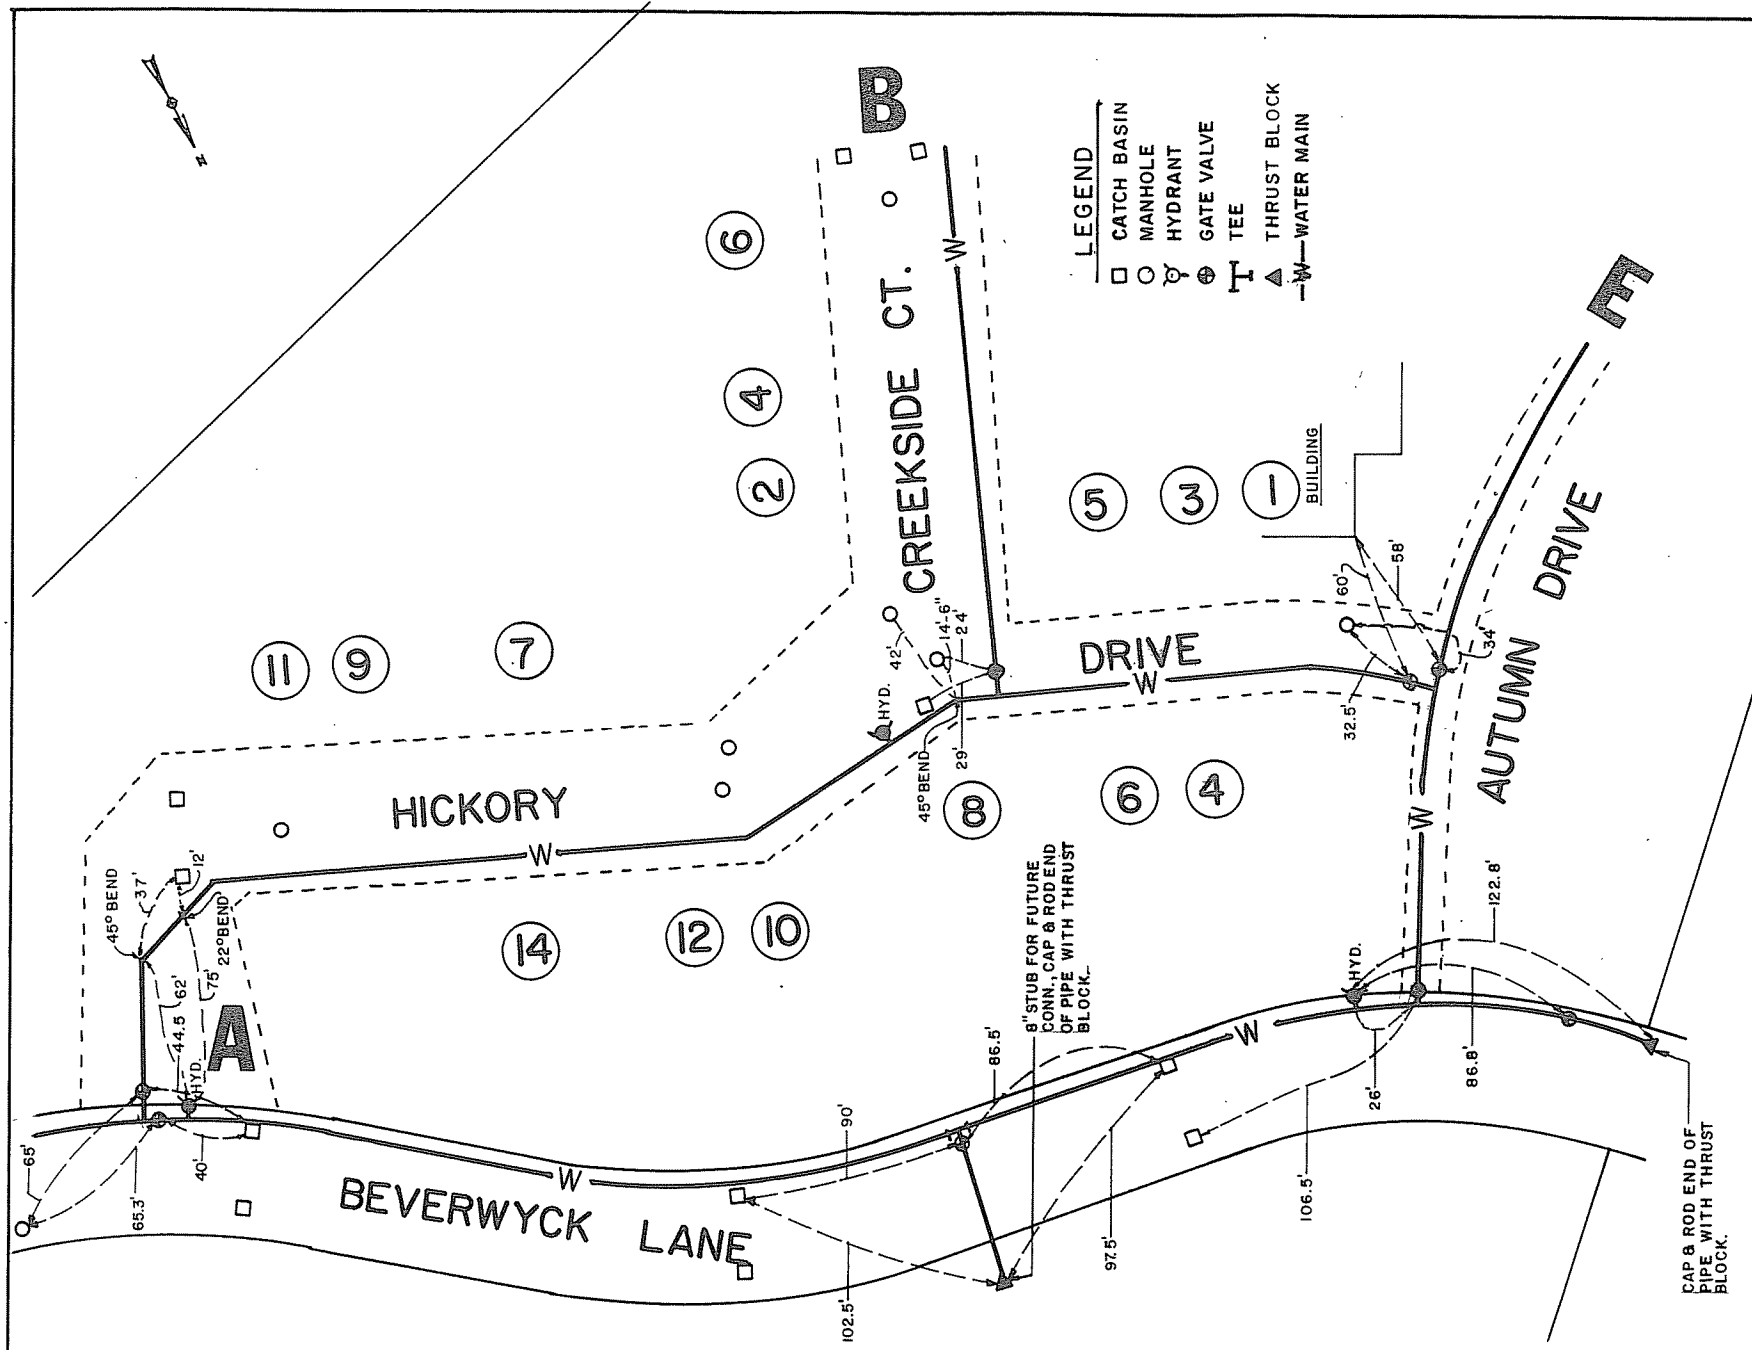

BEVERWYCK LANE
WATER MAIN

NOV. 1992 RECORD
SCALE: 1"=50'
CONST. BY R. J. VALENTE
DRAWN BY T.W.R. & M.G.
CHECKED BY T.W.R.