


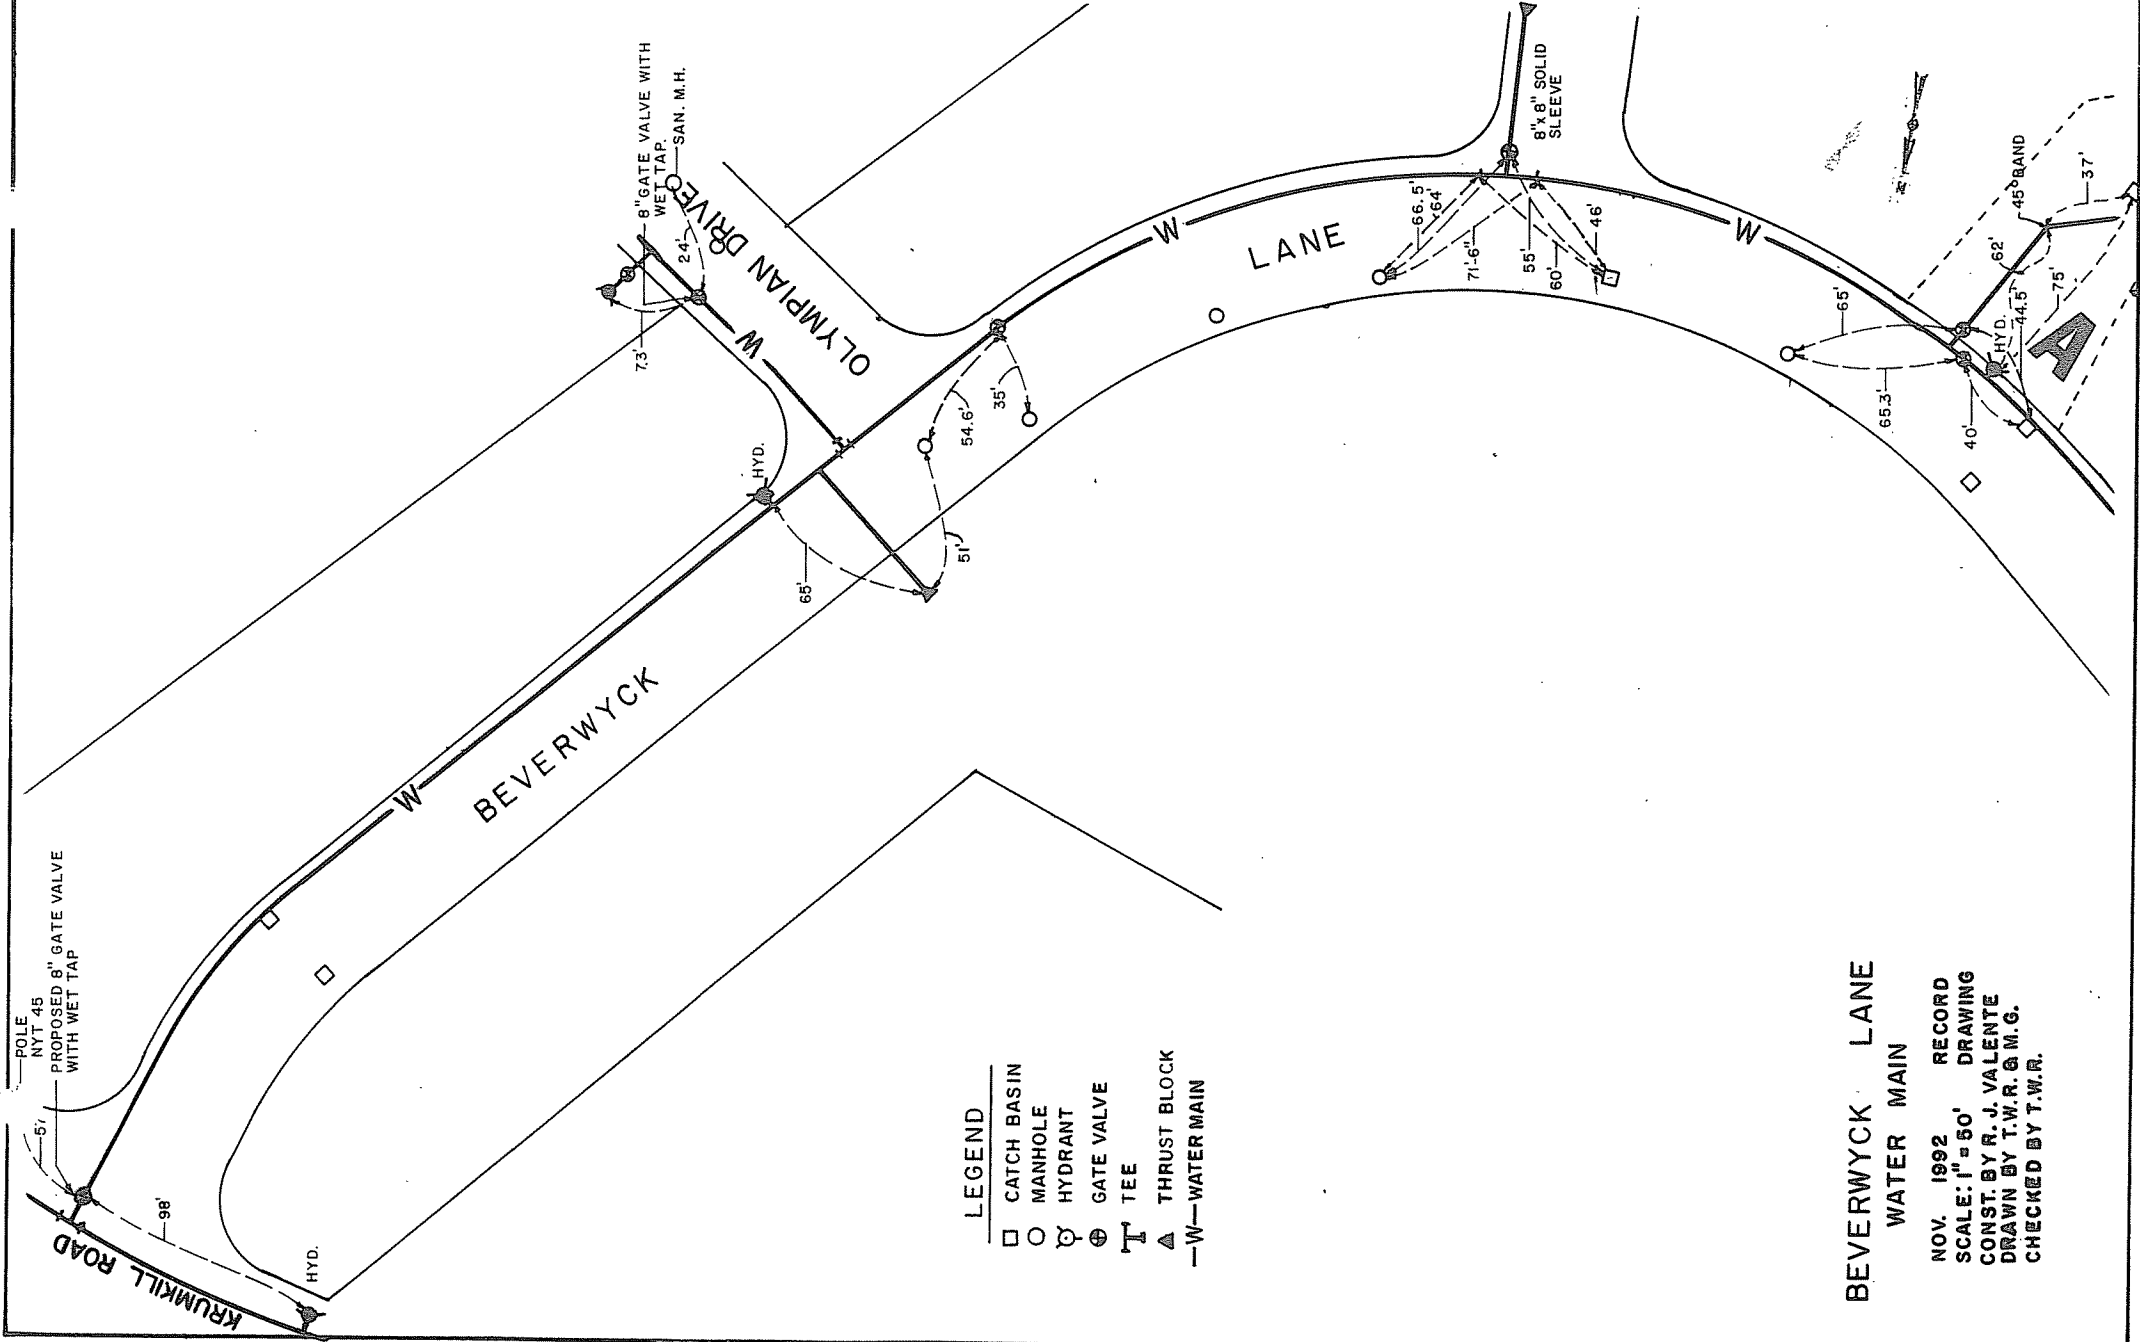

- LEGEND**
- CATCH BASIN
  - MANHOLE
  - ⊙ HYDRANT
  - ⊕ GATE VALVE
  - ⊥ TEE
  - ▲ THRUST BLOCK
  - W- WATER MAIN

**BEVERWYCK LANE  
WATER MAIN**

NOV. 1992 RECORD  
 SCALE: 1" = 50'  
 CONST. BY R. J. VALENTE  
 DRAWN BY T. W. R. & M. G.  
 CHECKED BY T. W. R.