


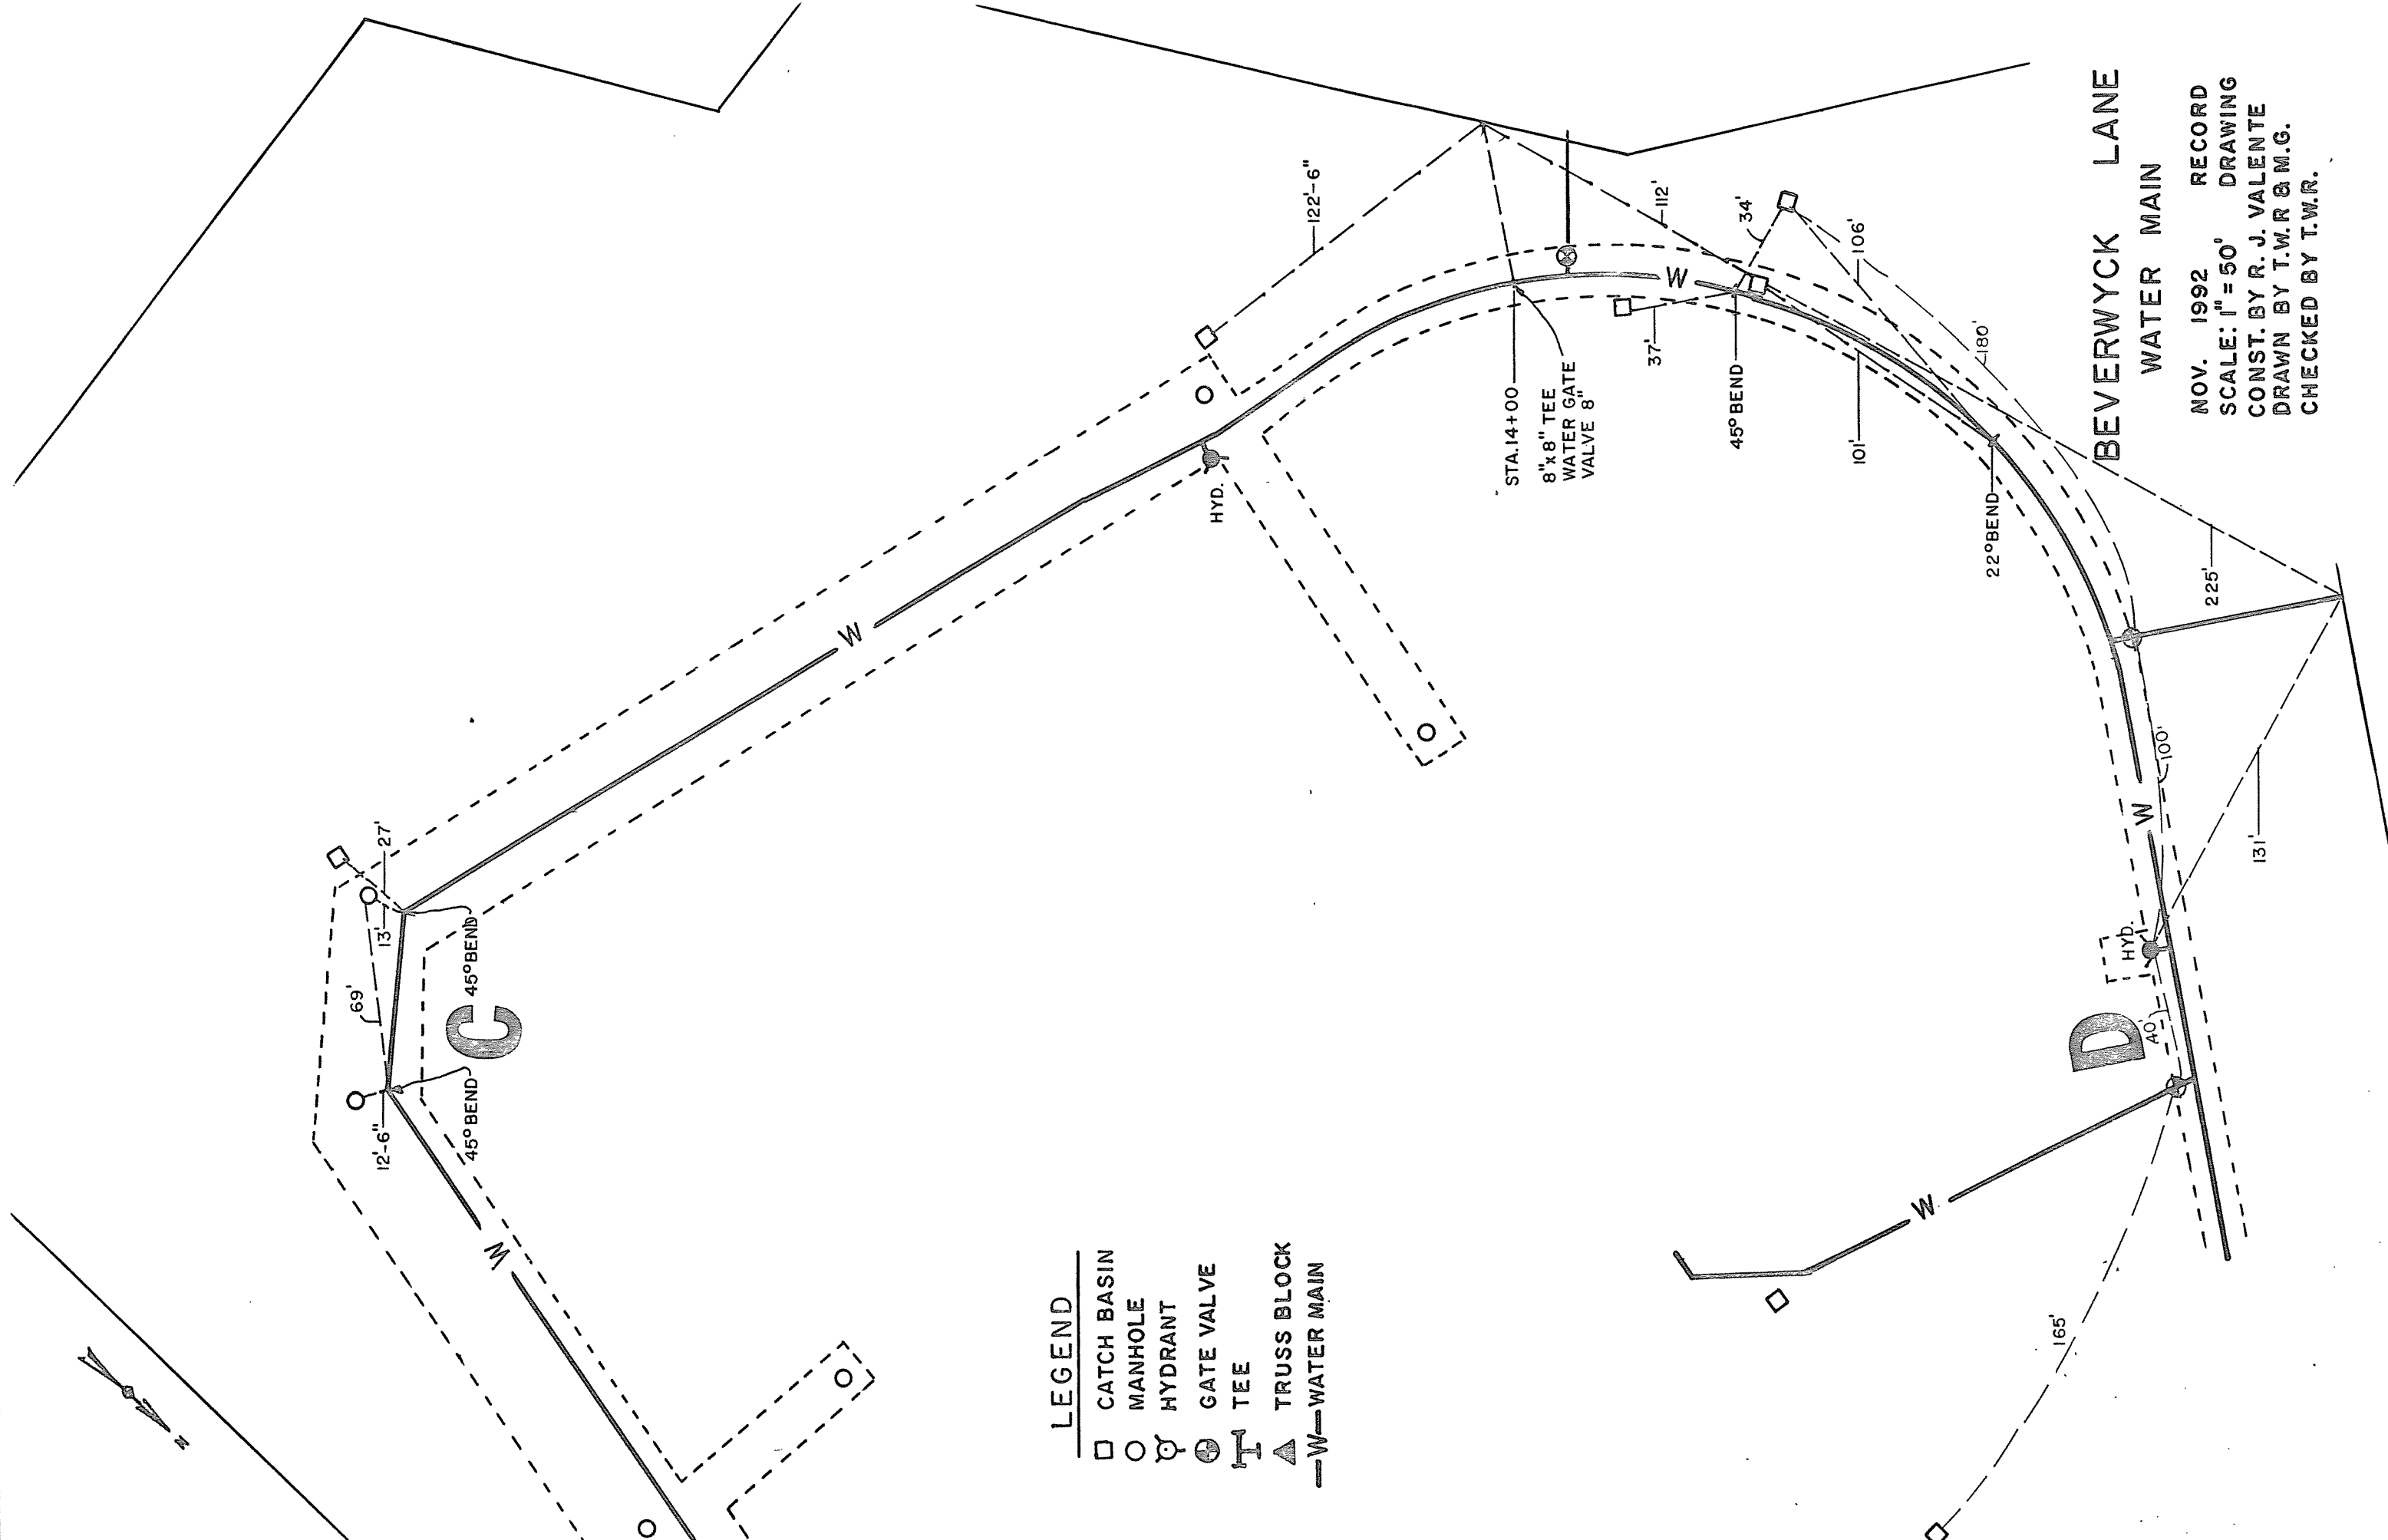

LEGEND

- CATCH BASIN
- MANHOLE
- ⊗ HYDRANT
- GATE VALVE
- ⊥ TEE
- ▲ TRUSS BLOCK
- W— WATER MAIN

BEVERWYCK LANE
WATER MAIN

NOV. 1992 RECORD
SCALE: 1" = 50'
CONST. BY R. J. VALENTE
DRAWN BY T.W.R. & M.G.
CHECKED BY T.W.R.