


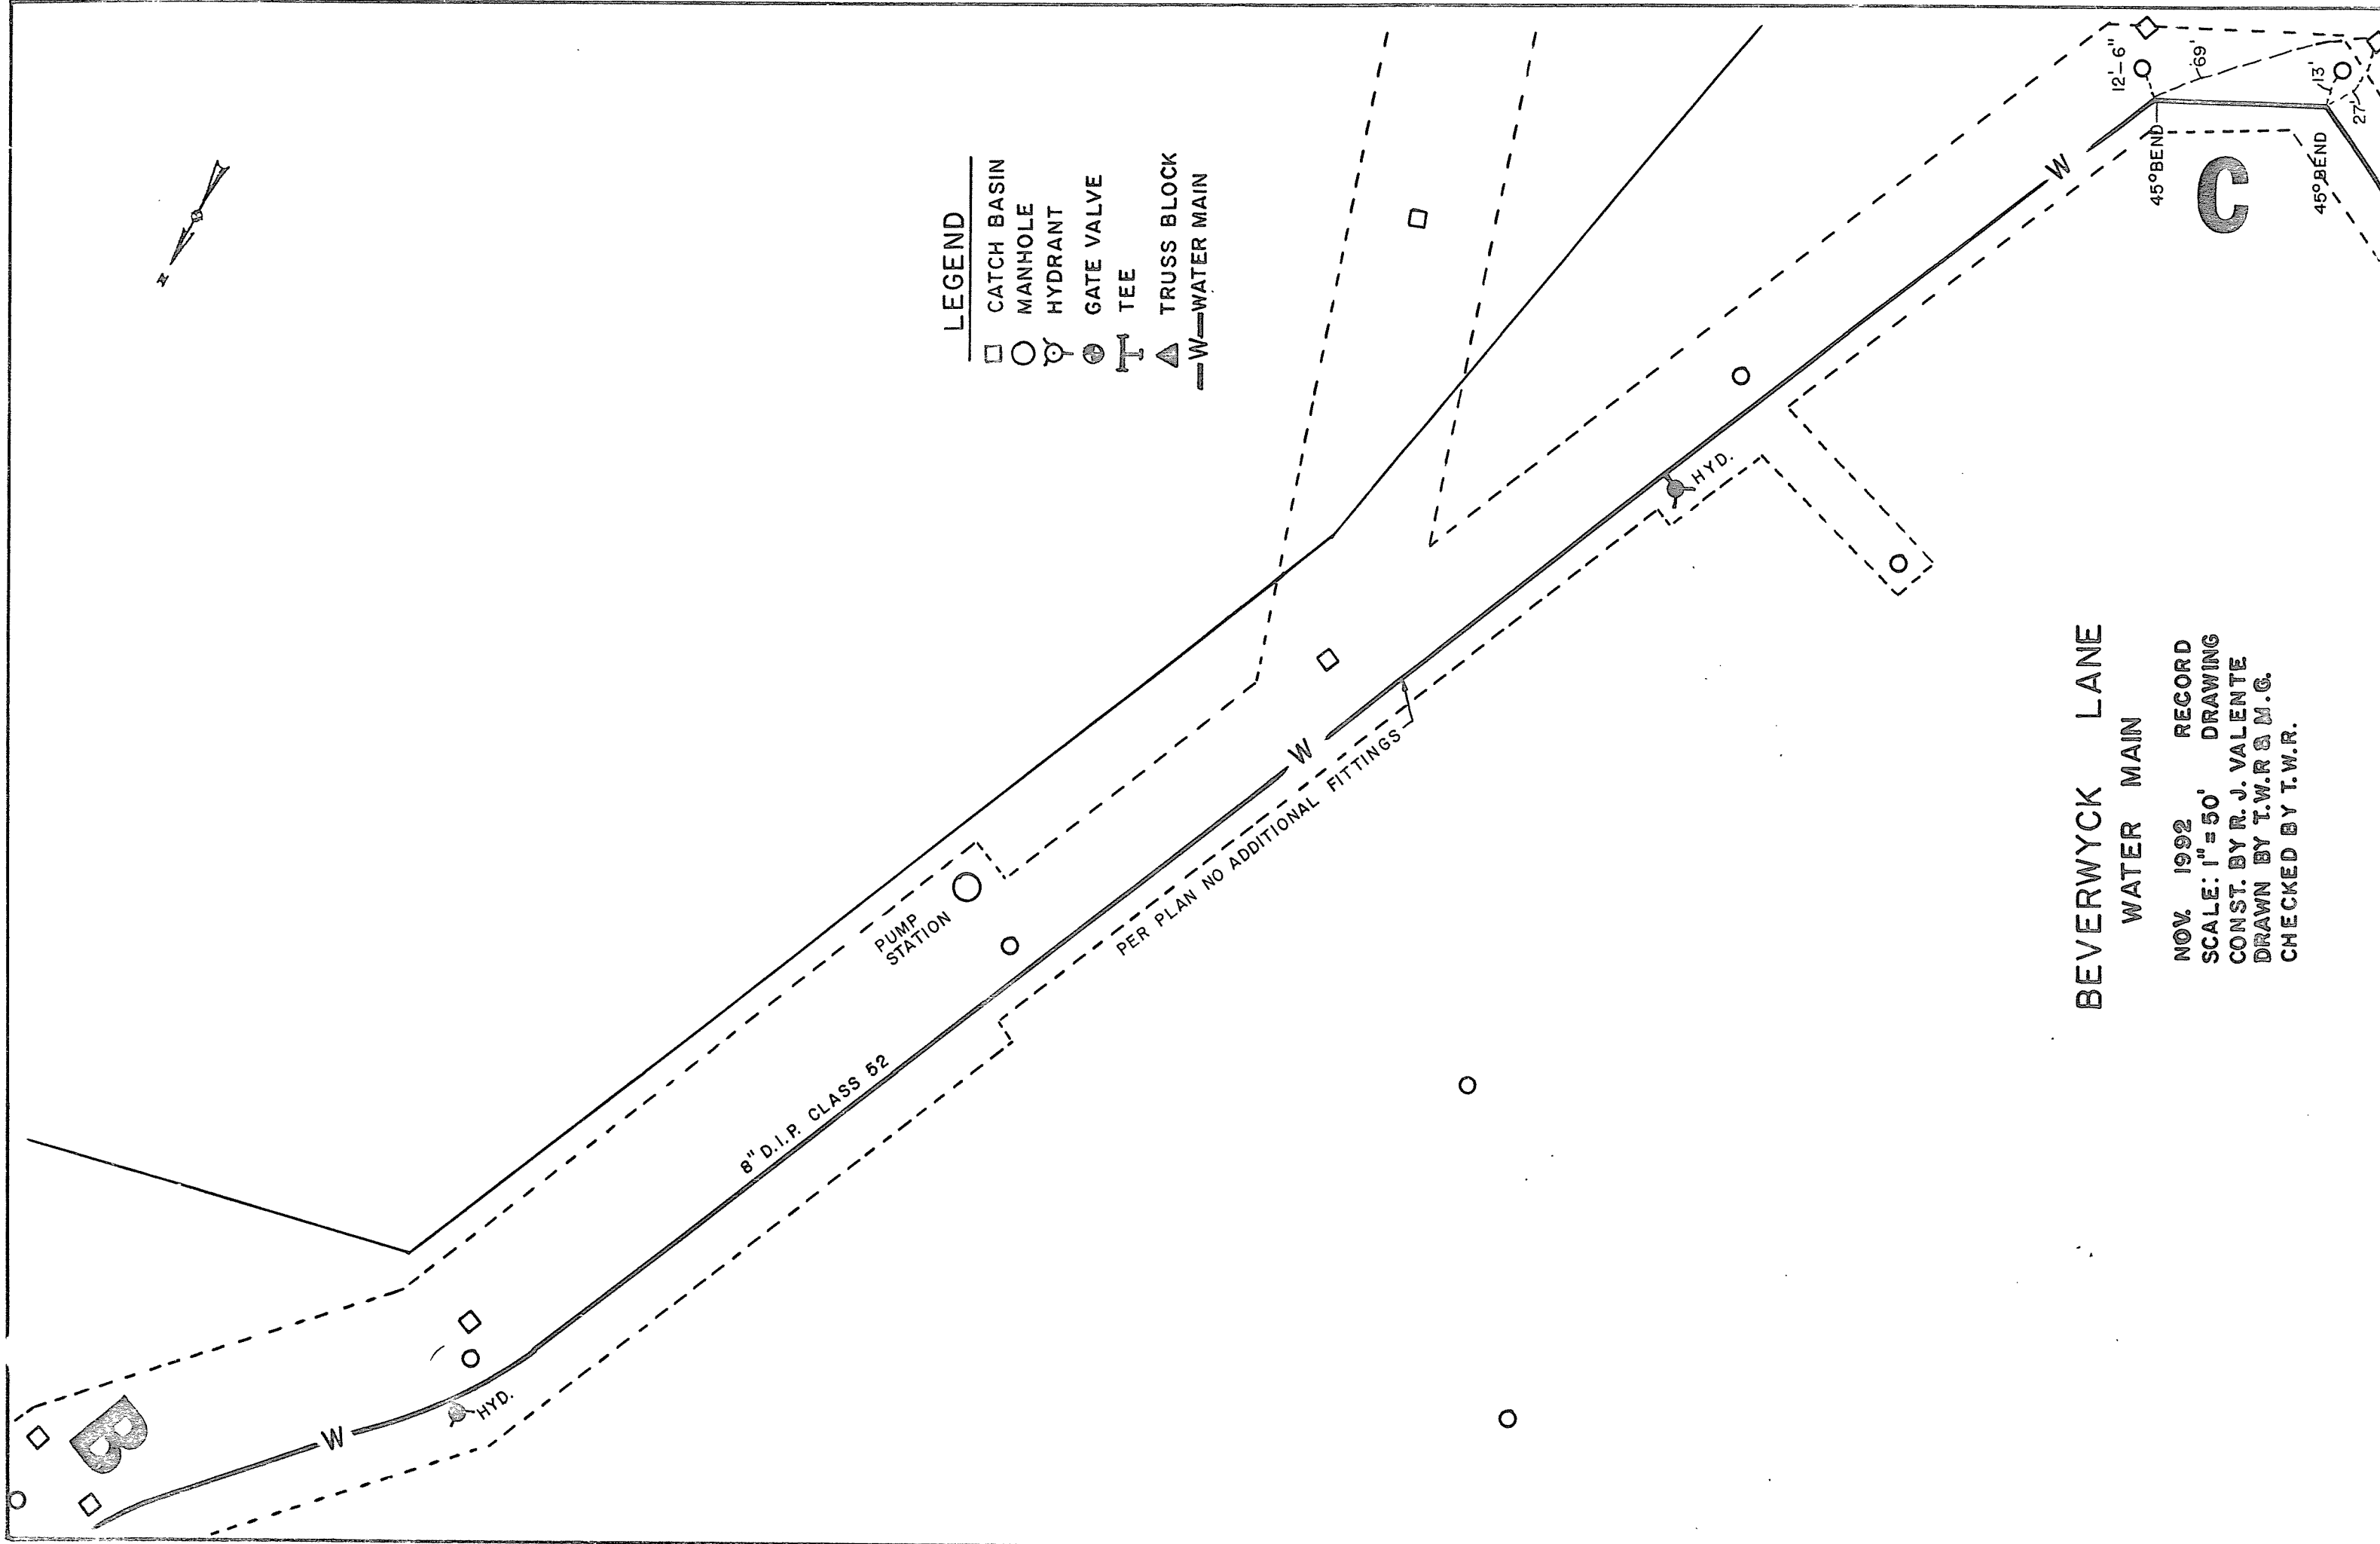

BEVERWYCK LANE
WATER MAIN

NOV. 1992 RECORD
SCALE: 1"=50' DRAWING
CONST. BY R. J. VALENTE
DRAWN BY T.W.R & M.G.
CHECKED BY T.W.R.

LEGEND

- CATCH BASIN
- MANHOLE
- HYDRANT
- GATE VALVE
- TEE
- TRUSS BLOCK
- W-WATER MAIN