


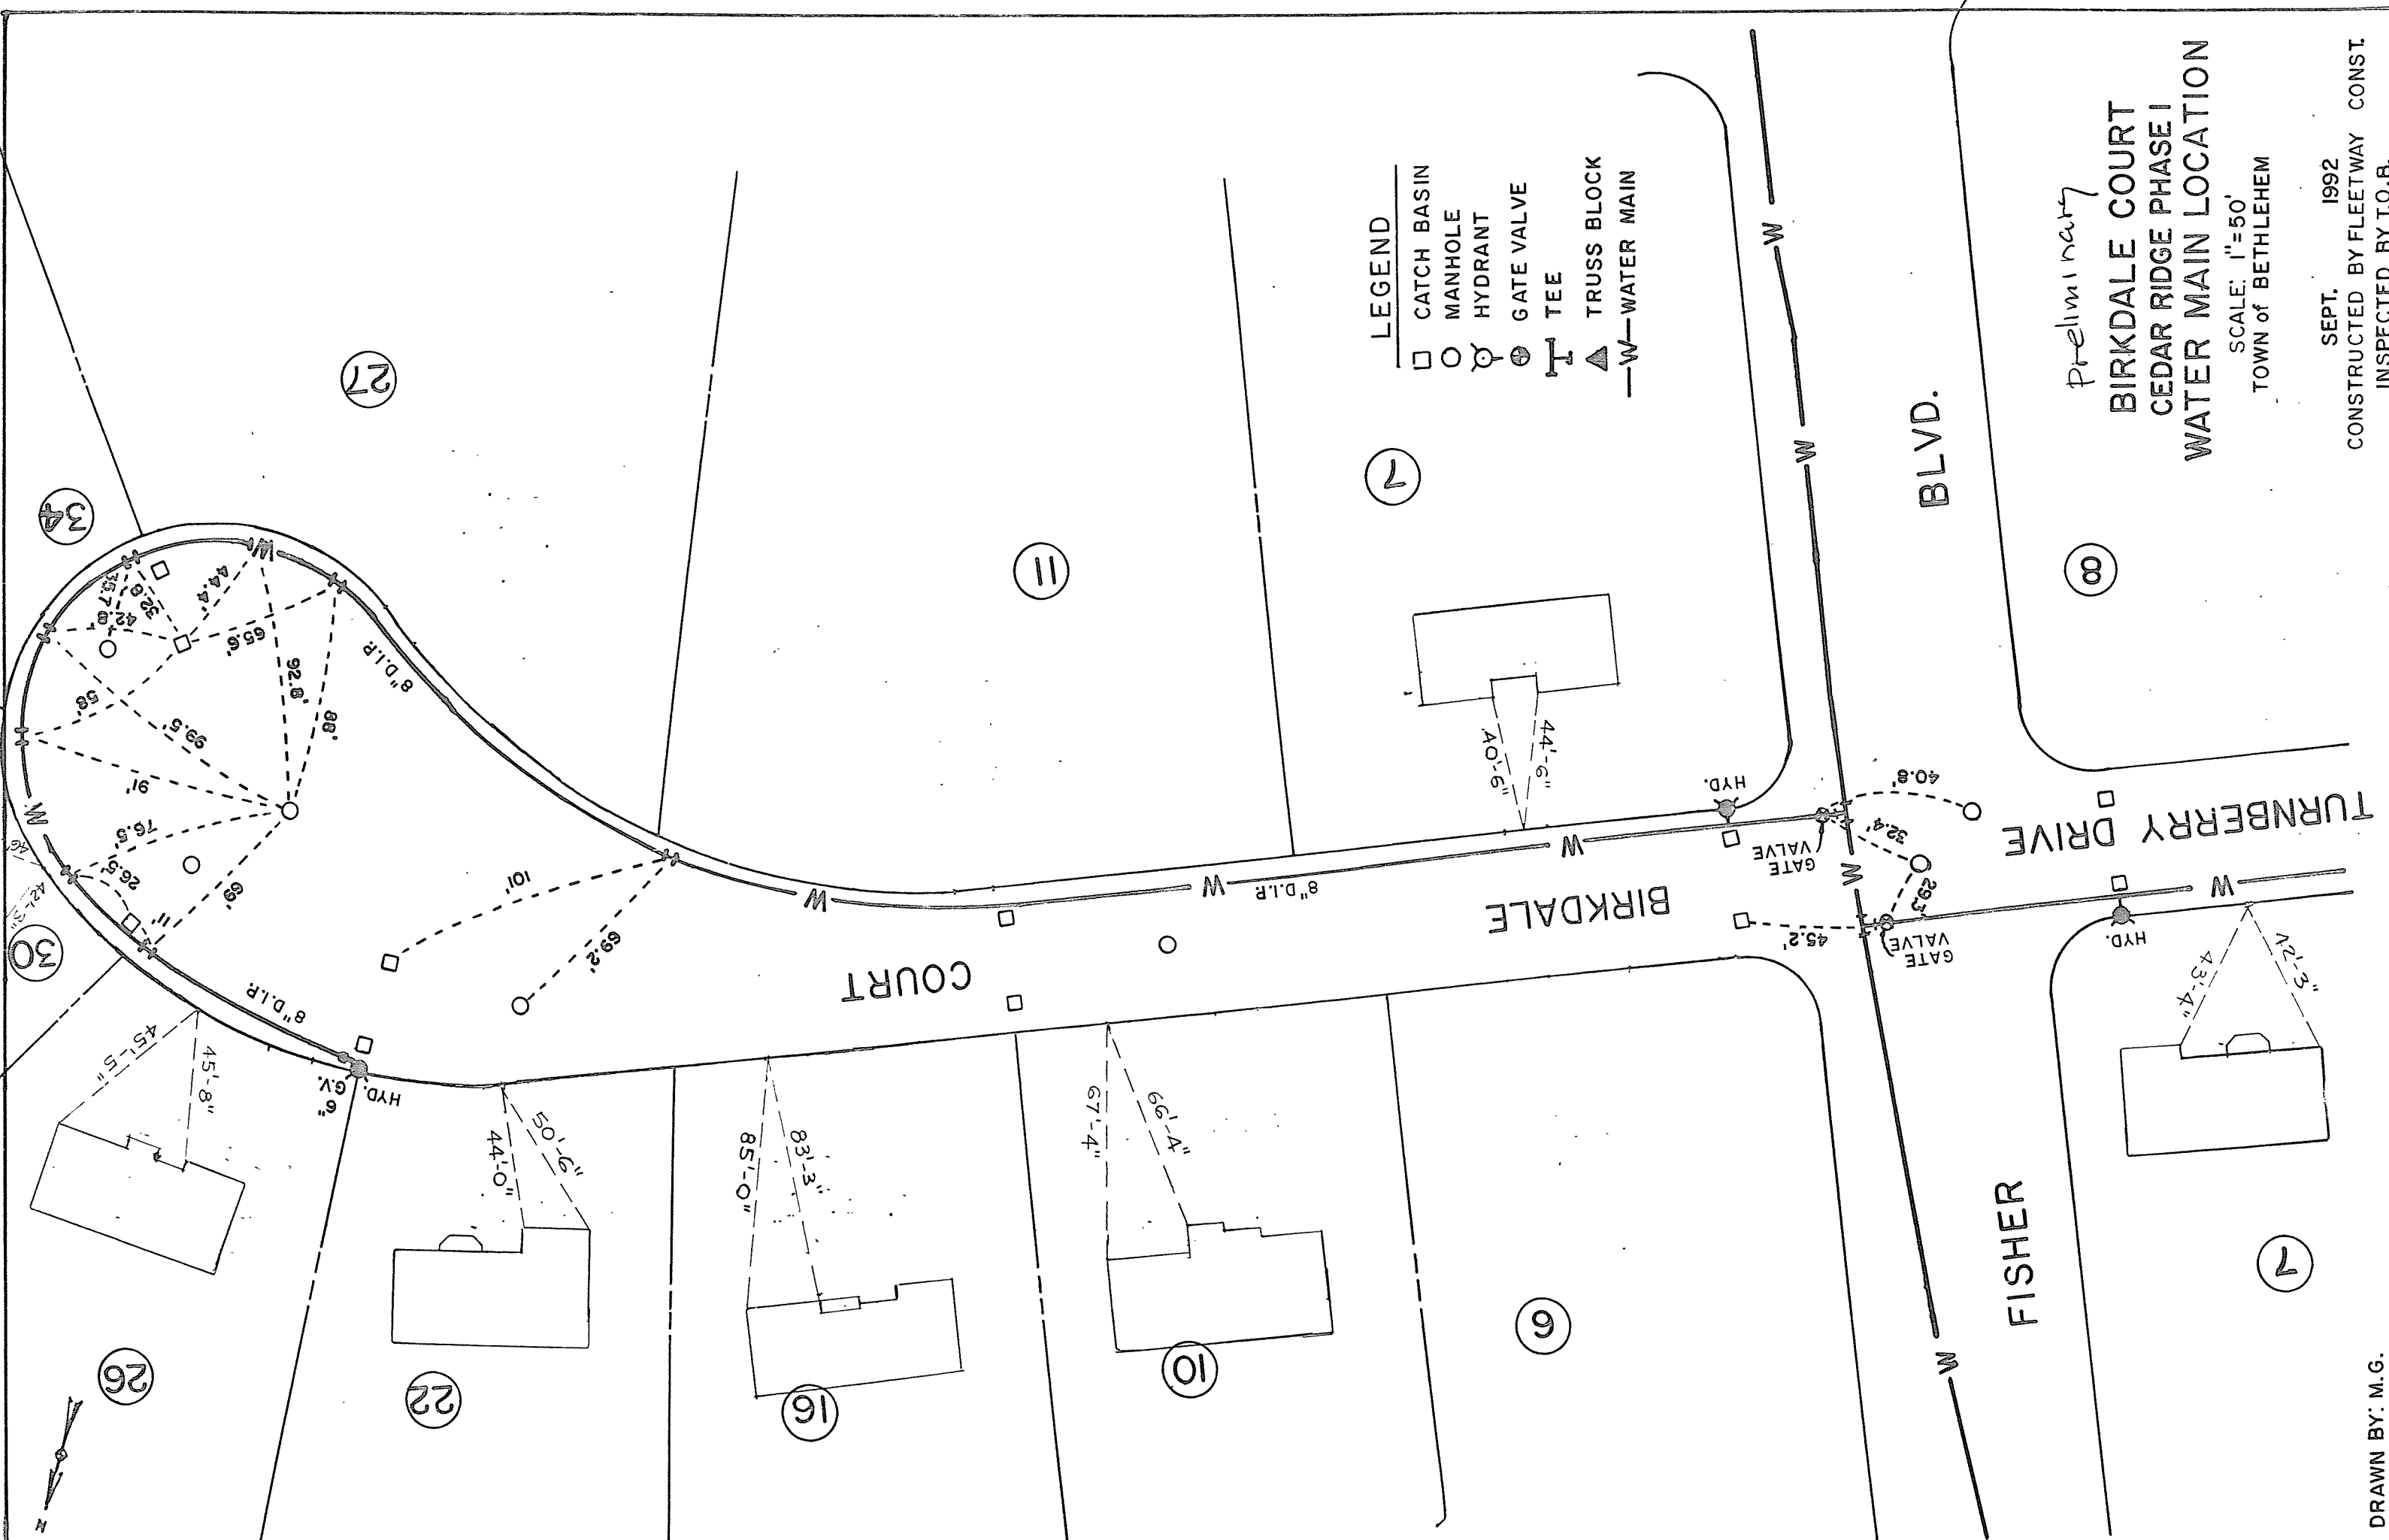

- LEGEND
- CATCH BASIN
 - MANHOLE
 - HYDRANT
 - GATE VALVE
 - TEE
 - TRUSS BLOCK
 - W-WATER MAIN

Preliminary
**BIRKDALE COURT
CEDAR RIDGE PHASE I
WATER MAIN LOCATION**
SCALE: 1"=50'
TOWN OF BETHLEHEM

SEPT. 1992
CONSTRUCTED BY FLEETWAY CONST.
INSPECTED BY T.O.B.

DRAWN BY: M.G.
CHECKED BY: