


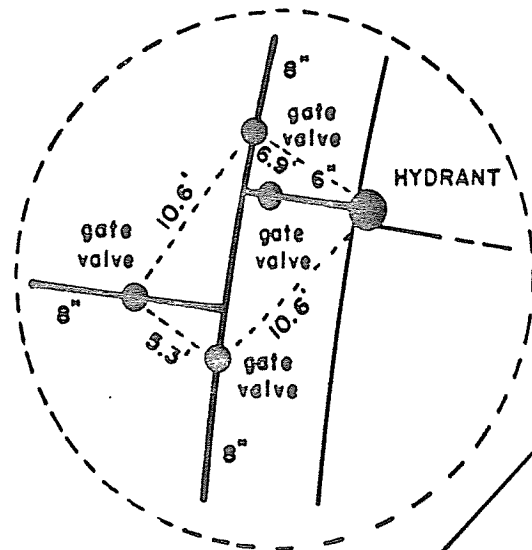

DETAIL "A"

APPROX. 6' OFF PROP. LINE

HYDRANT and gate valve

BITTERSWEET

8" D.I.P.

22 1/2° fitting

54' 50'

APPROX. 6' OFF PROP. LINE

HYDRANT and gate valve

SEE DETAIL "A"

STOCKBRIDGE

WATER

BITTERSWEET
LANE

WATER MAIN
DECEMBER 1986

1" = 50'

SHULTZ CONSTRUCTION