



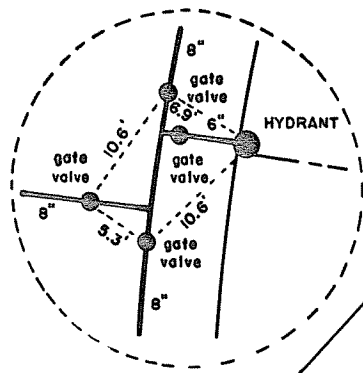

DETAIL "A"

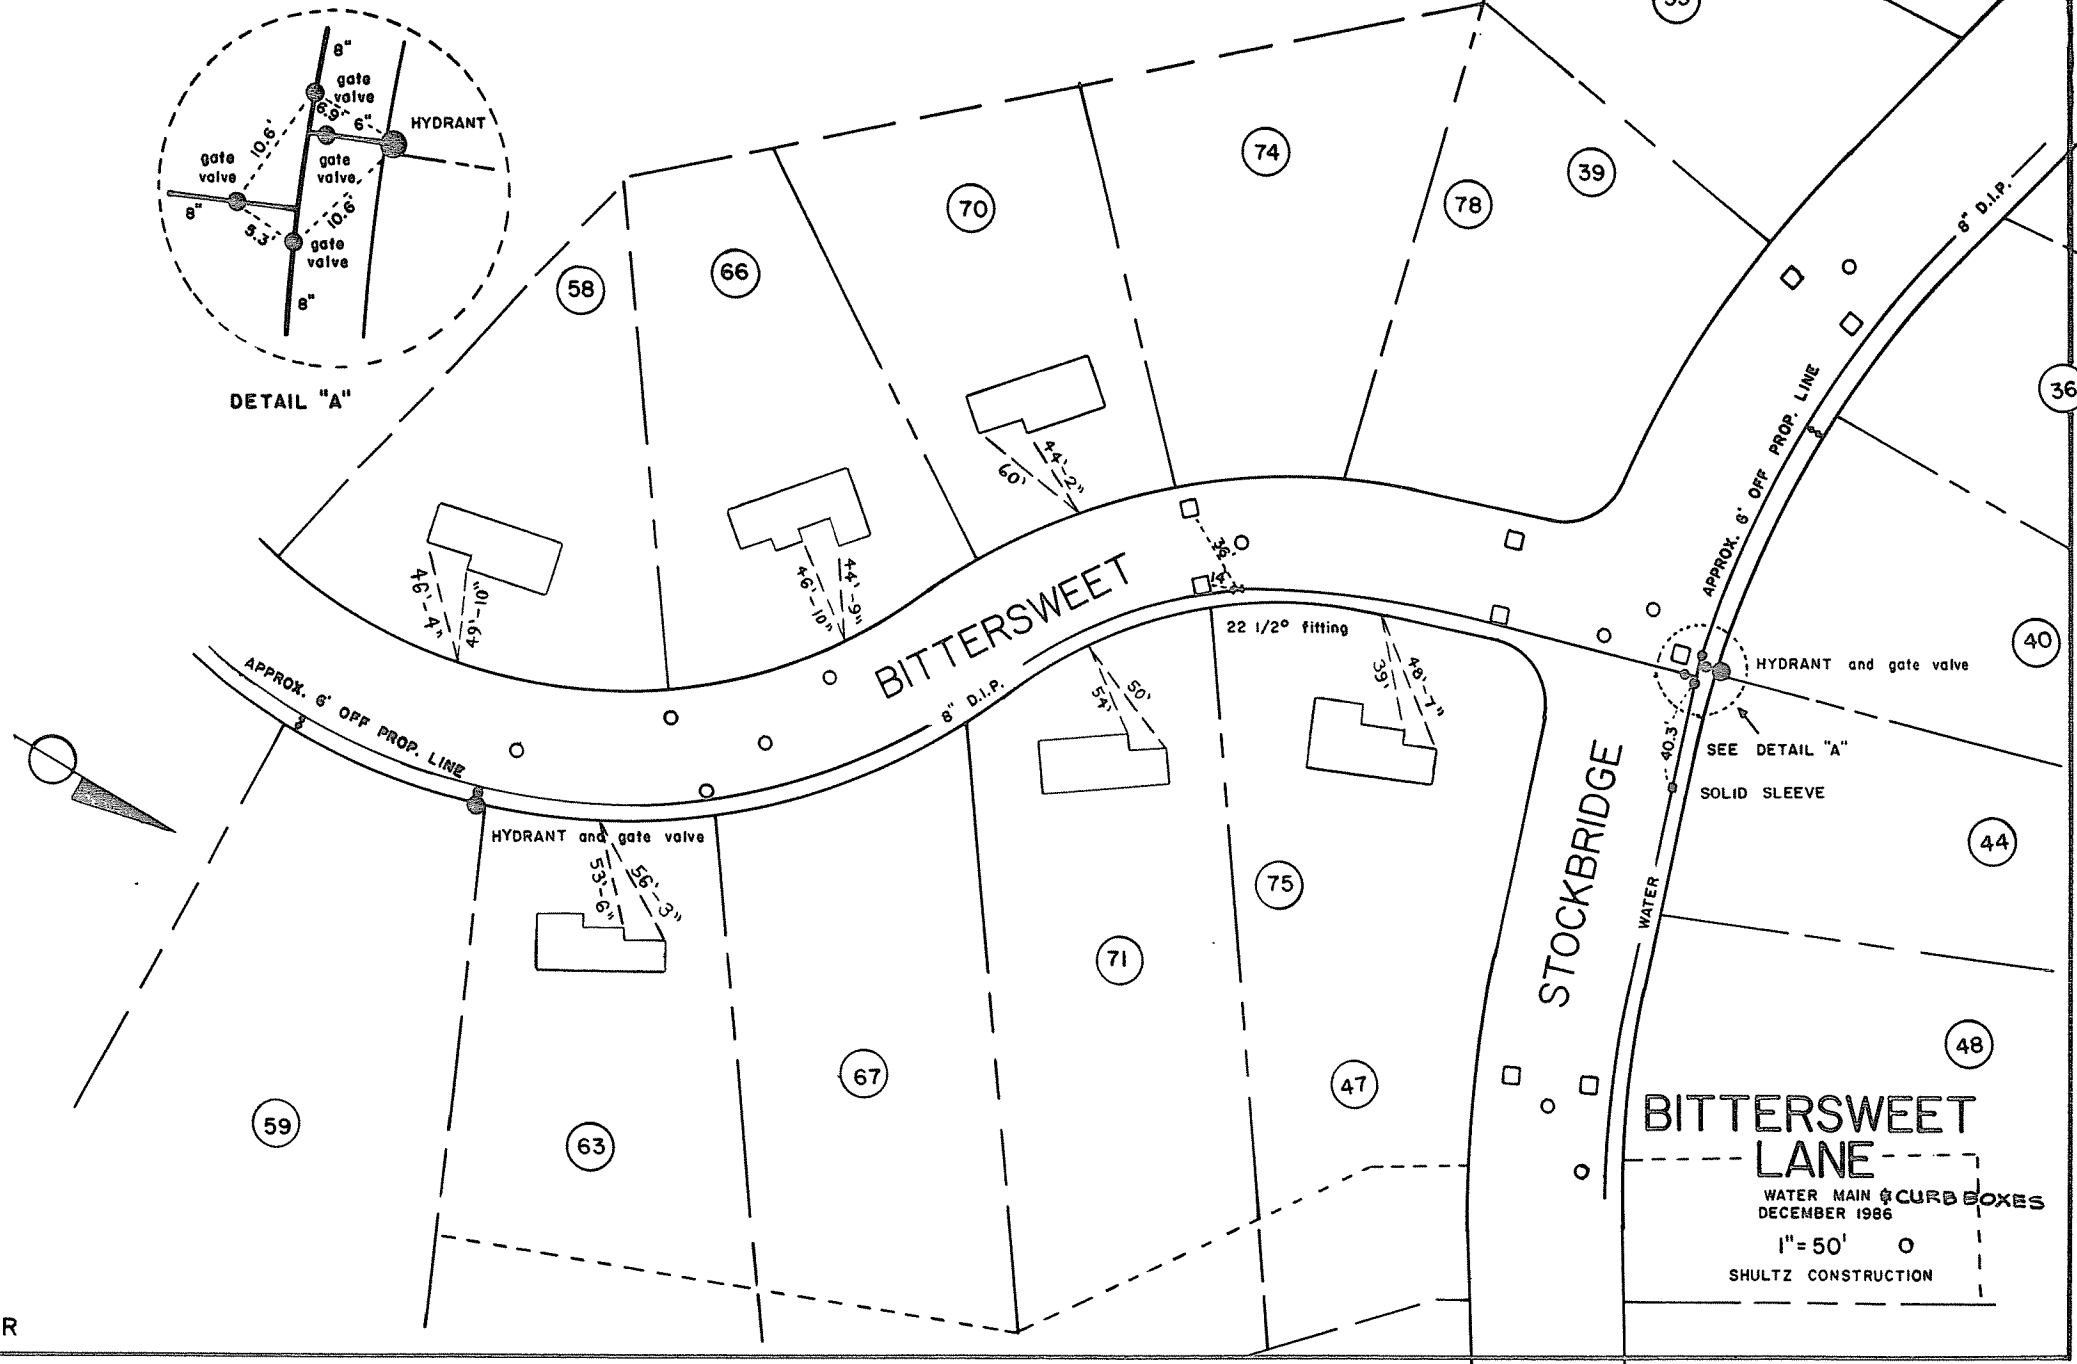

BITTERSWEET LANE

WATER MAIN & CURB BOXES
DECEMBER 1986

1" = 50'

SHULTZ CONSTRUCTION