
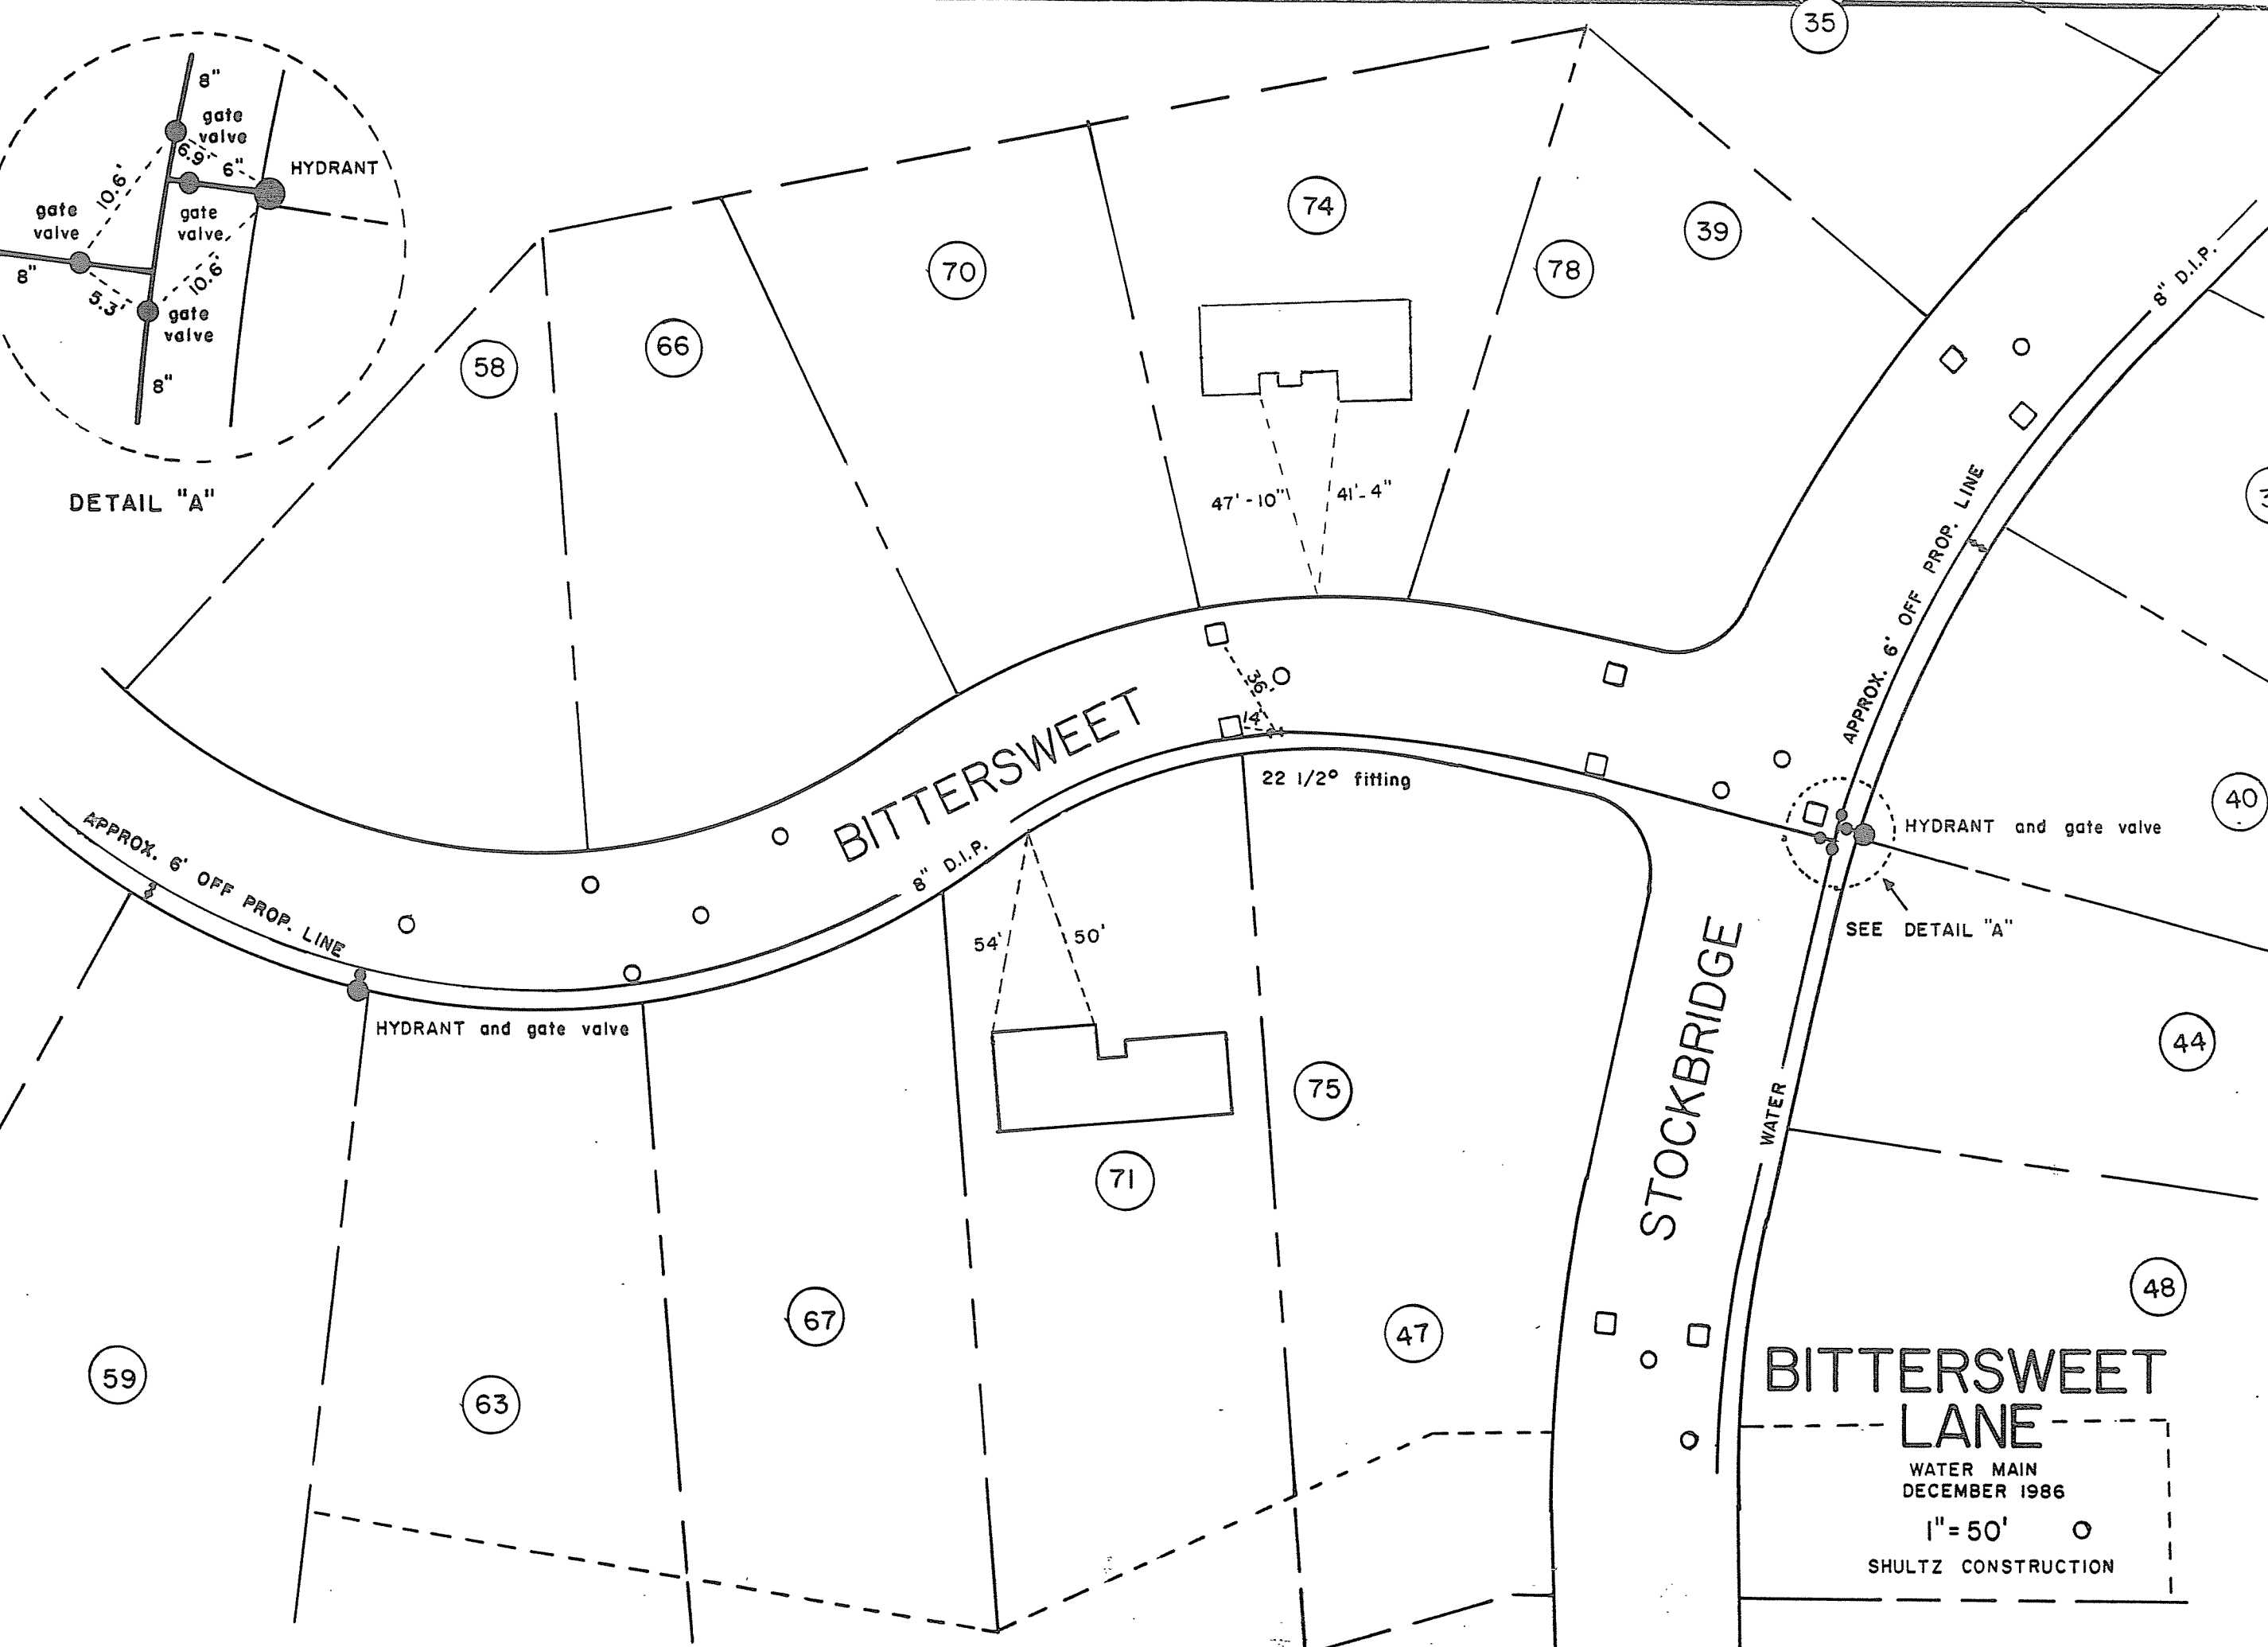


DETAIL "A"

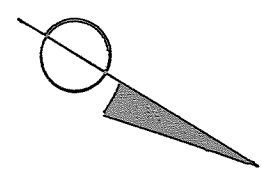

**BITTERSWEET
LANE**

WATER MAIN
DECEMBER 1986

1" = 50'

SHULTZ CONSTRUCTION