

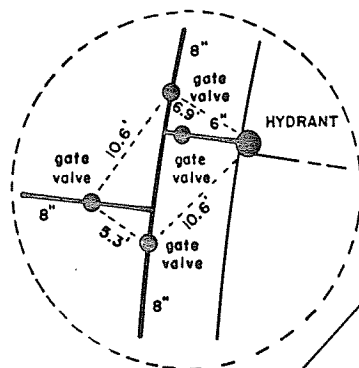


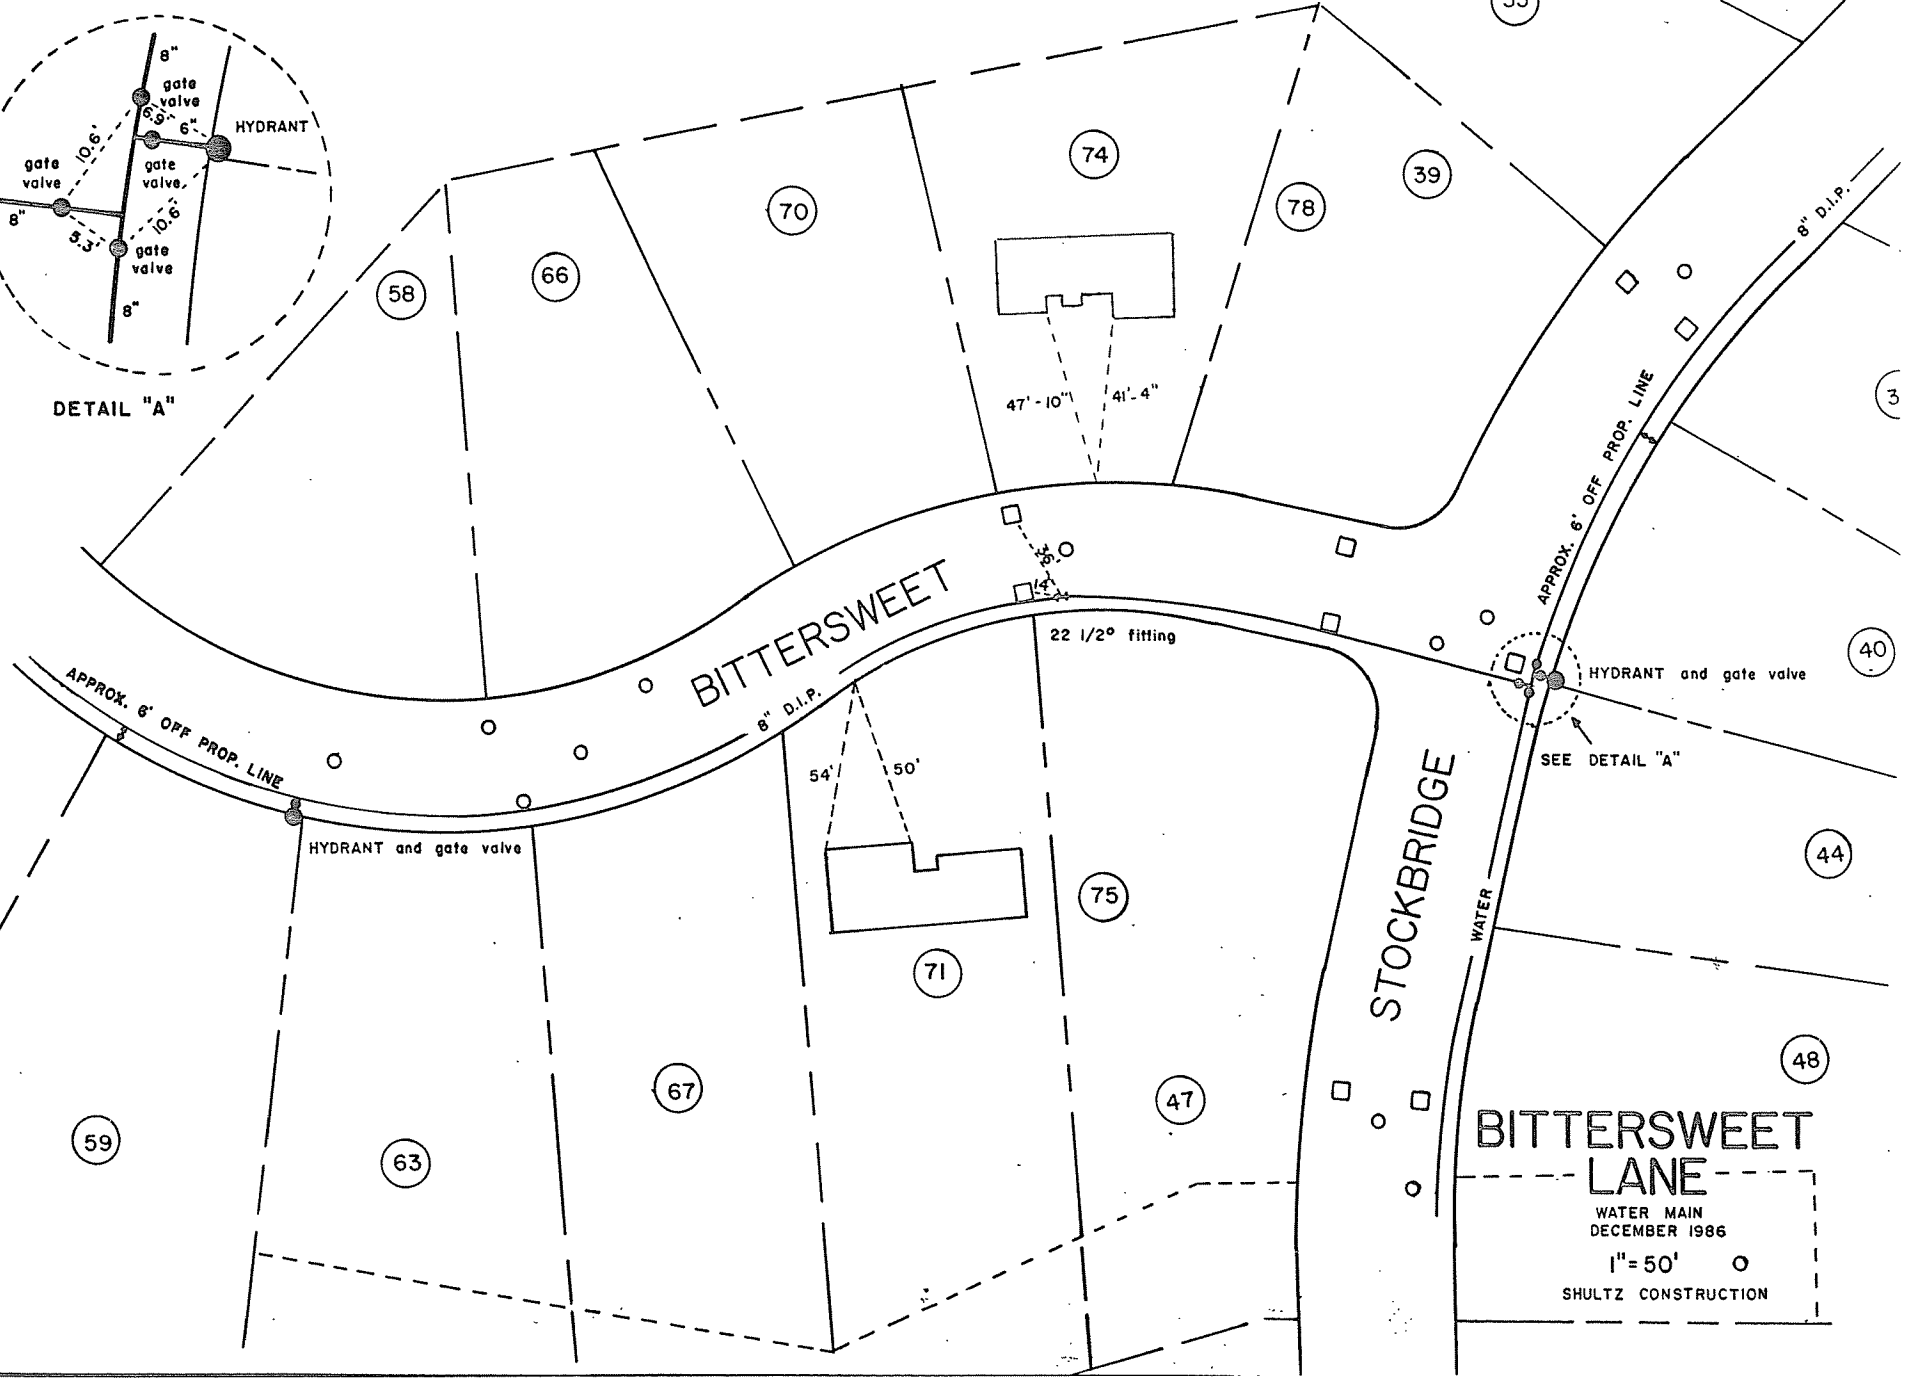

DETAIL "A"

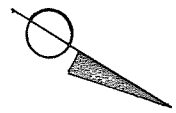

BITTERSWEET LANE

WATER MAIN
DECEMBER 1986

1" = 50'

SHULTZ CONSTRUCTION