


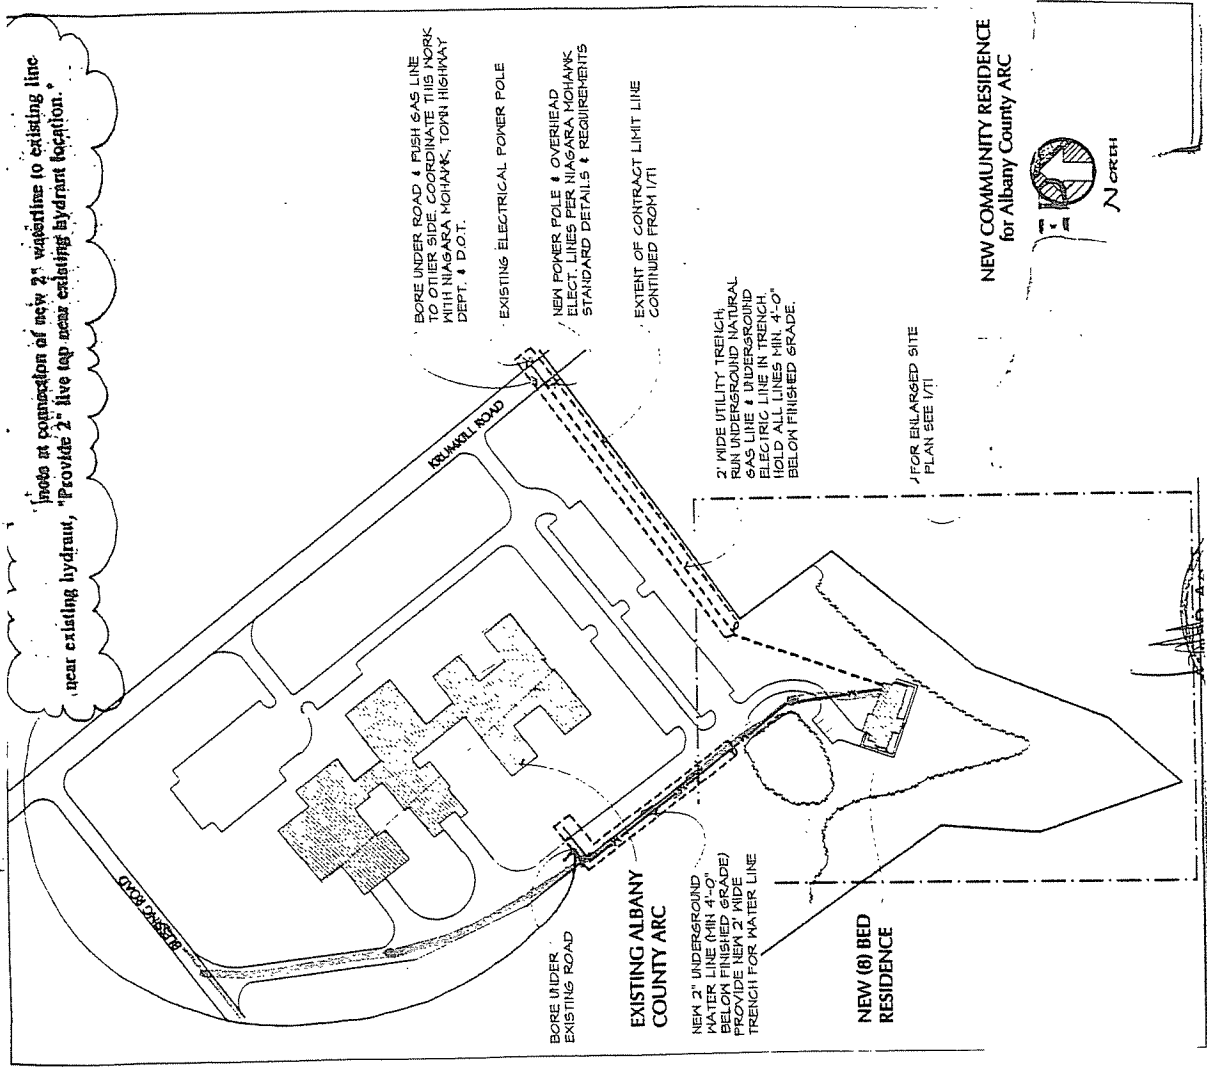

BLESSING ROAD
ALBANY COUNTY ARC
WATER MAIN
N.T.S.

ORIGINAL