


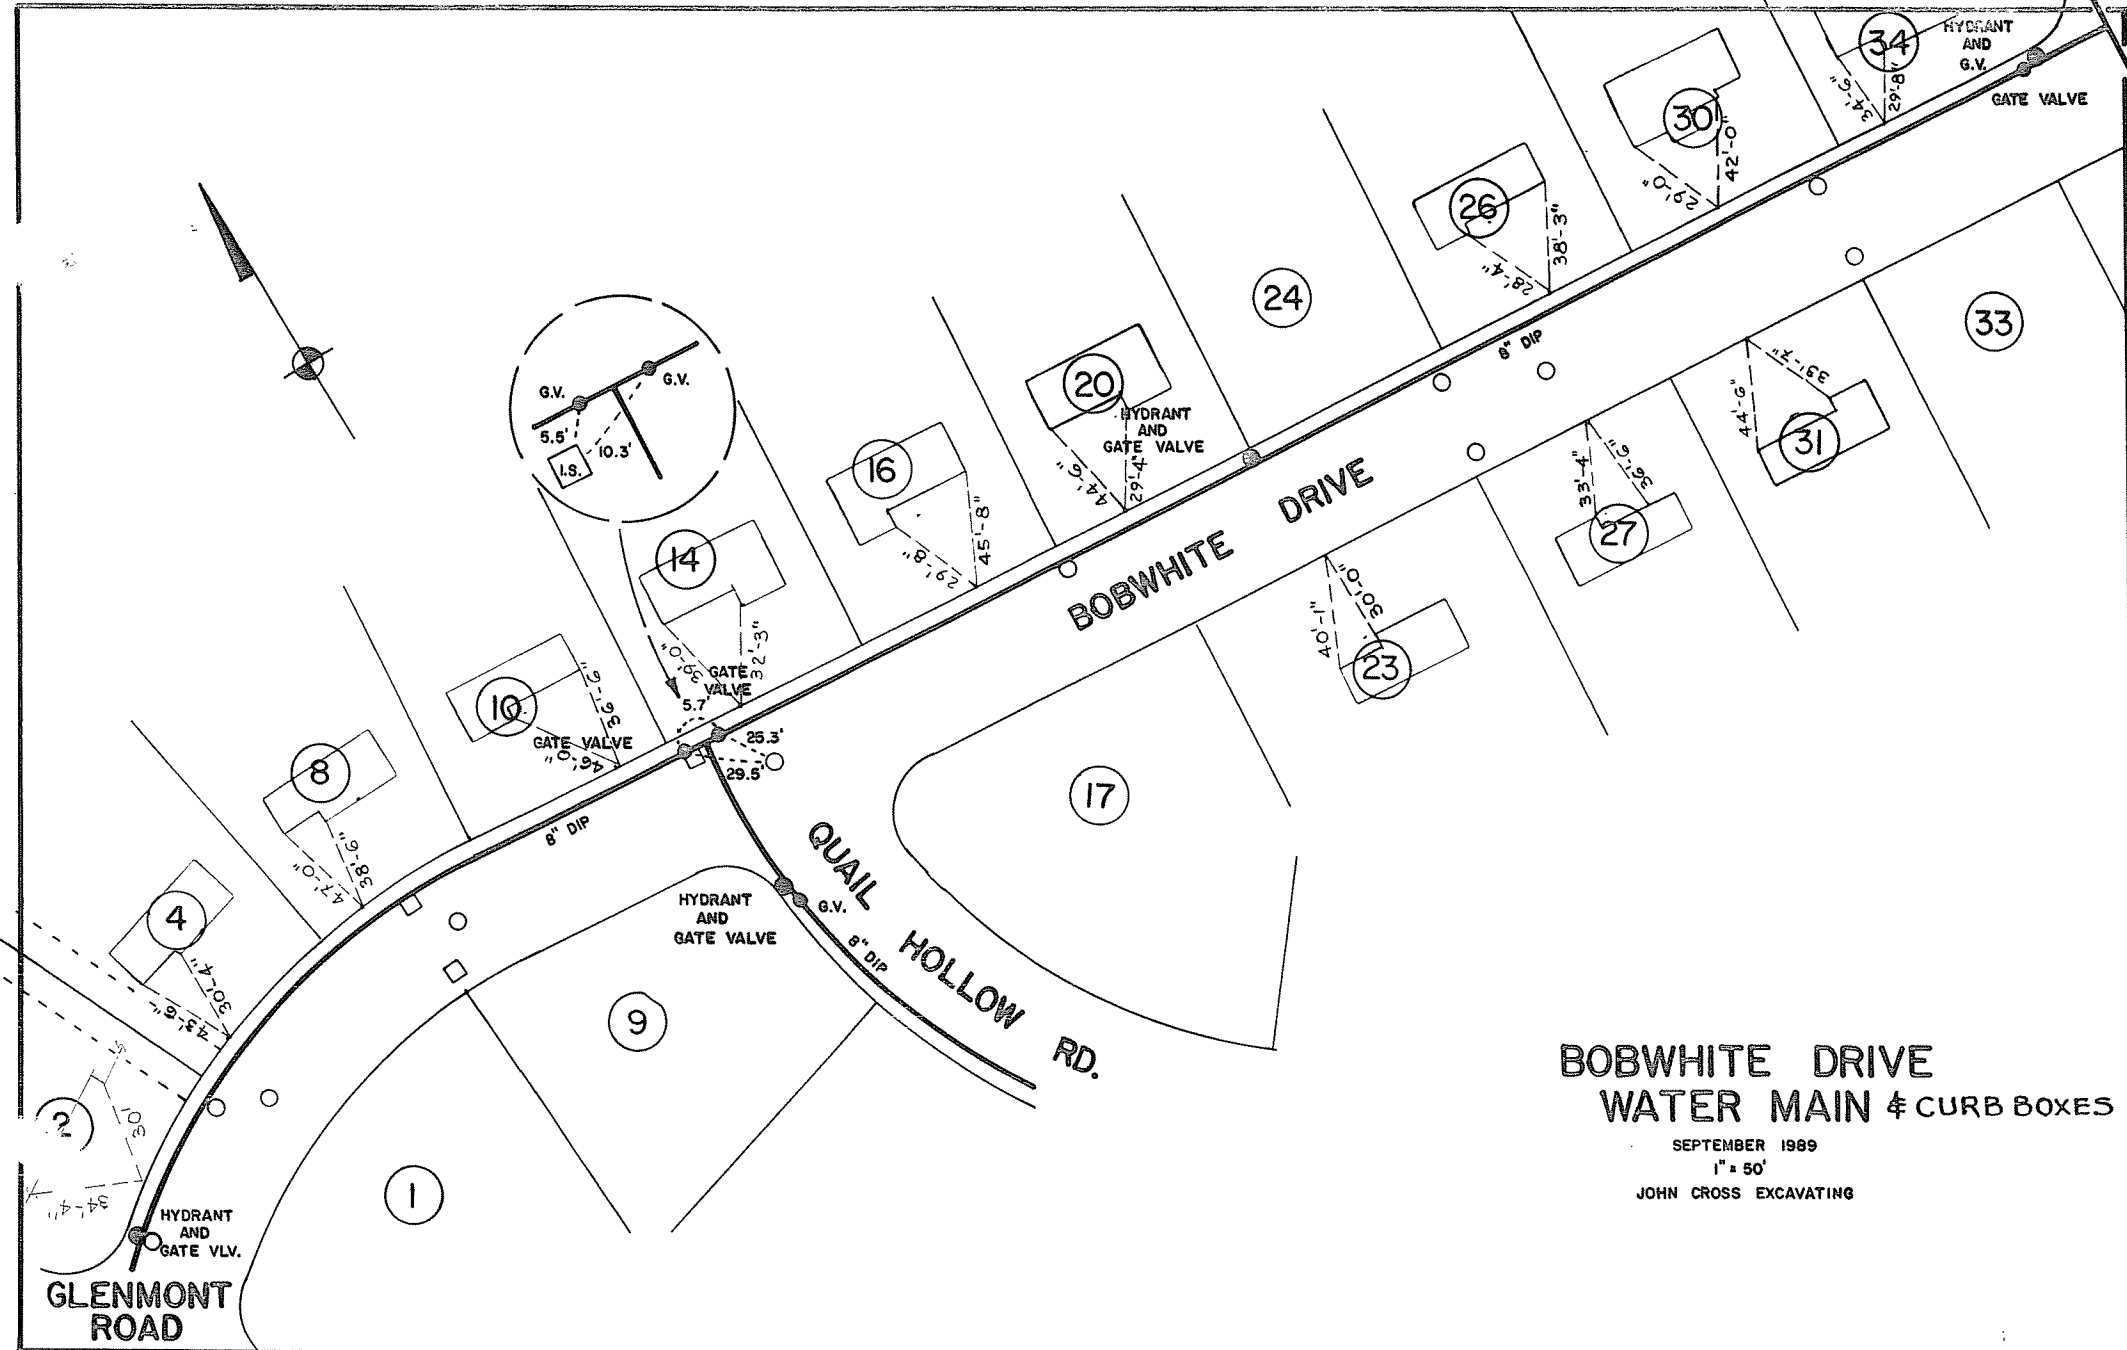

**BOBWHITE DRIVE
WATER MAIN & CURB BOXES**

SEPTEMBER 1989

1" = 50'

JOHN CROSS EXCAVATING