


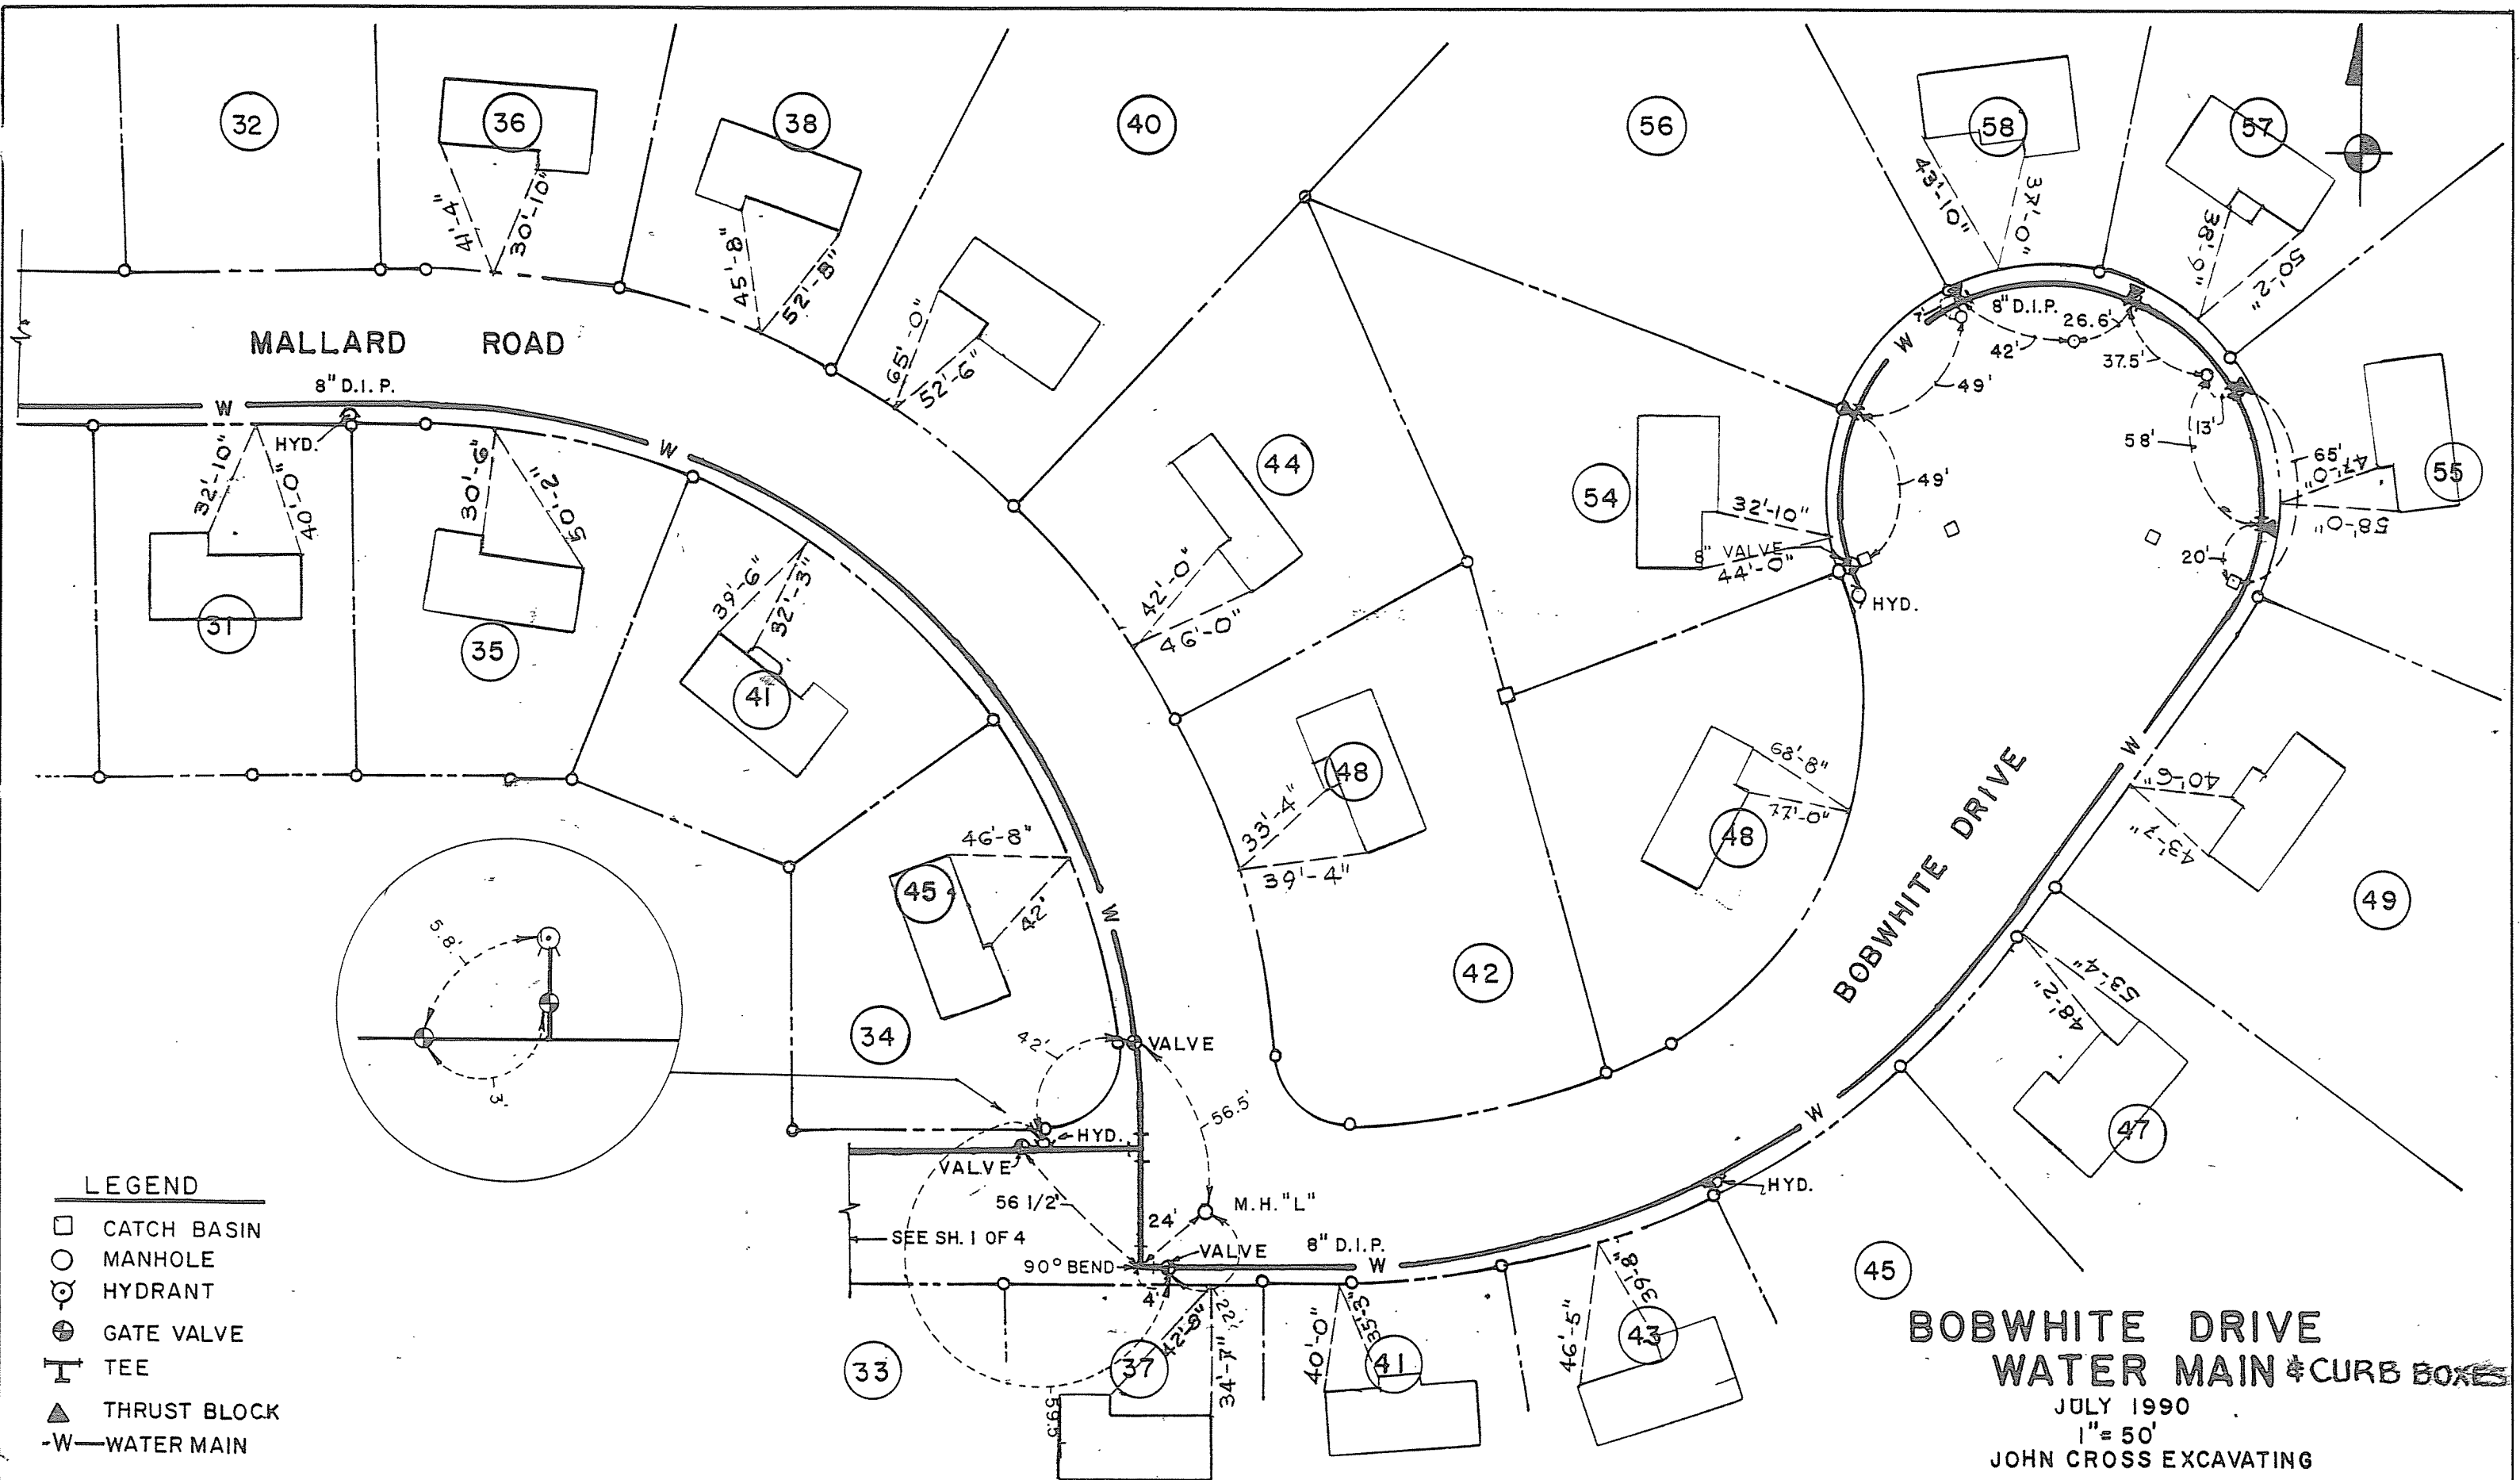

DRAWN BY: M.G.
 CHECKED BY: D.M.S.