


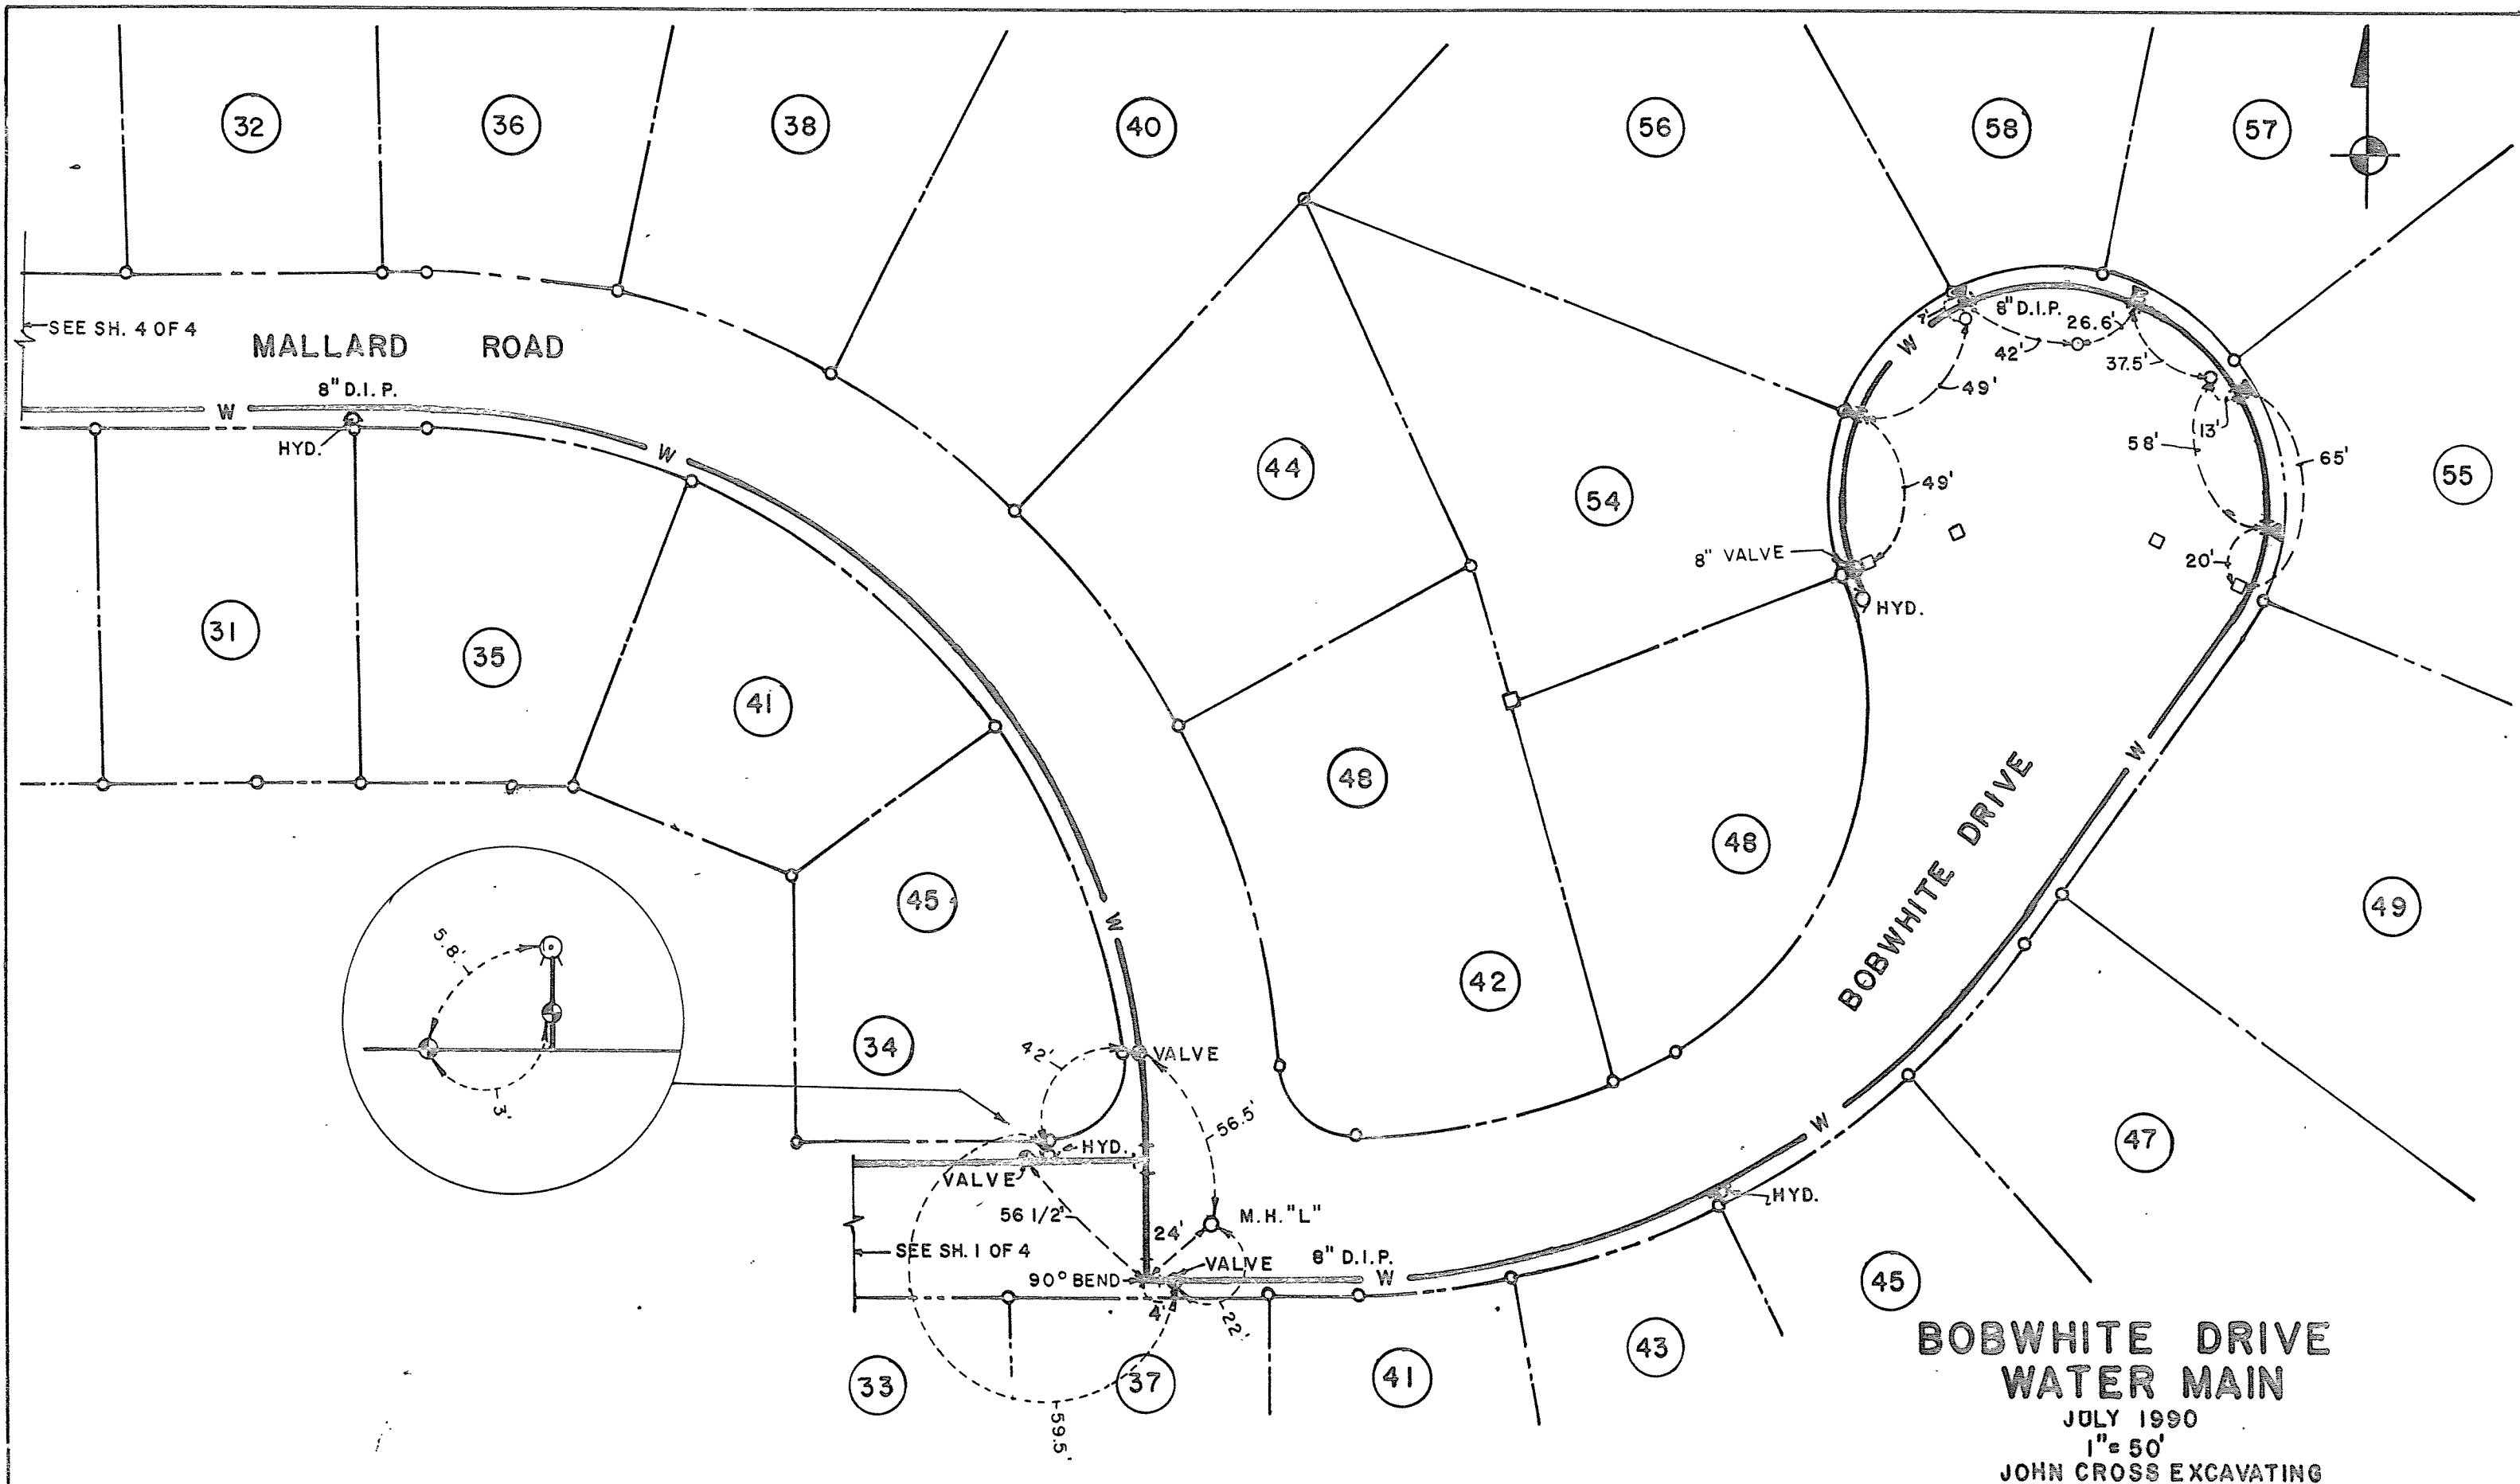

DRAWN BY: M. G.
CHECKED BY: D.M.S.

**BOBWHITE DRIVE
WATER MAIN**
JULY 1990
1" = 50'
JOHN CROSS EXCAVATING